


BENCHMARK NO. 1
 R.R. SPIKE SET IN POWER POLE AT SOUTH SIDE OF I.H. 30 SERVICE ROAD, 180' EAST OF ROCKWALL CLASSIC CARS & BODY SHOP, ACROSS FROM I.H. 30 ENTRANCE RAMP. ELEV. 546.80

BENCHMARK NO. 2
 R.R. SPIKE SET IN TELE. POLE ON NORTH R.O.W. OF UNION PACIFIC RAILROAD, 50' EAST OF S.W. CHAINLINK FENCE CORNER OF LEON TUTTLE BALLFIELD COMPLEX. ELEV. 577.24

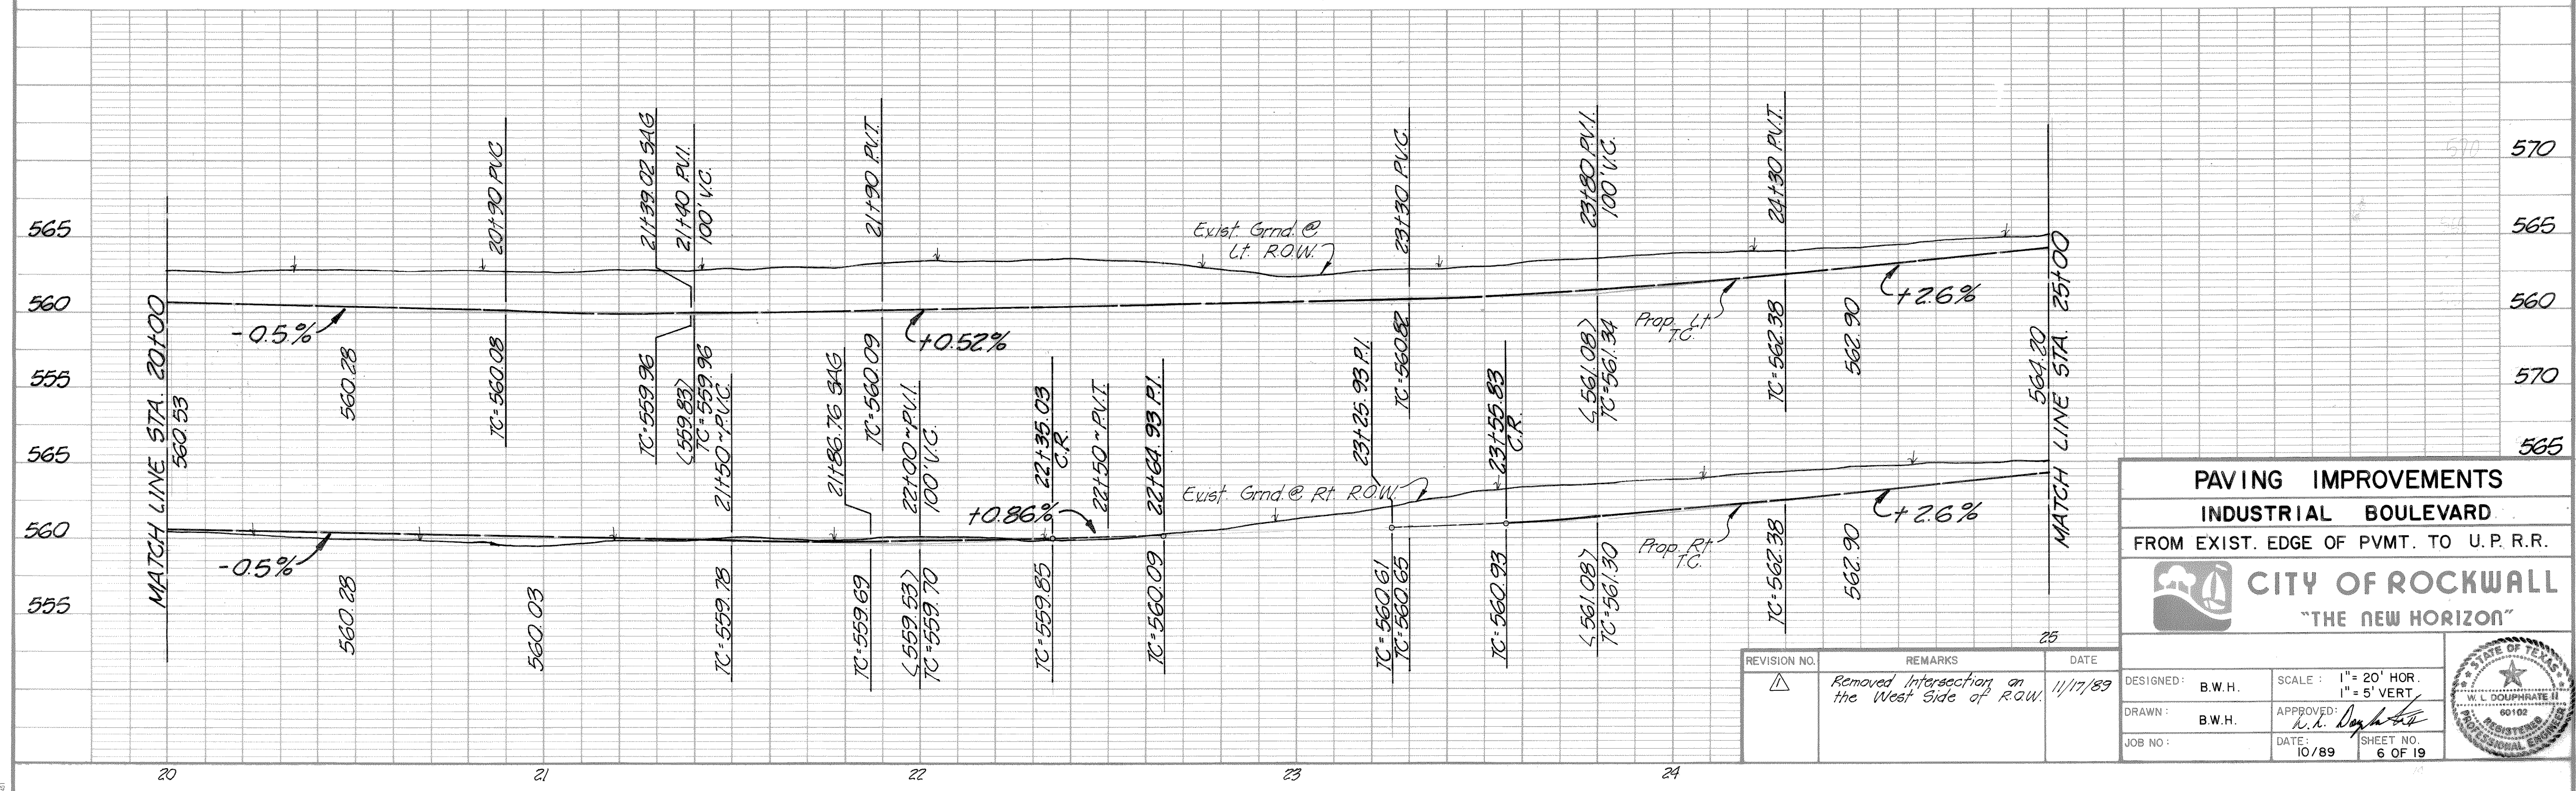

PAVING IMPROVEMENTS	
INDUSTRIAL BOULEVARD	
FROM EXIST. EDGE OF PVMT. TO U.P. R.R.	
CITY OF ROCKWALL "THE NEW HORIZON"	
DESIGNED: B.W.H.	SCALE: 1" = 20' HOR. 1" = 5' VERT
DRAWN: B.W.H.	APPROVED: <i>[Signature]</i>
JOB NO:	DATE: 10/89 SHEET NO: 6 OF 19

REVISION NO.	REMARKS	DATE
1	Removed Intersection on the West Side of R.O.W.	11/17/89

