


BENCHMARK NO. 2
 R.R. SPIKE SET IN TELE. POLE ON NORTH R.O.W. OF UNION PACIFIC RAILROAD, 50' EAST OF S.W. CHAINLINK FENCE CORNER OF LEON TUTTLE BALLFIELD COMPLEX. ELEV. 577.24



| REVISION NO. | REMARKS | DATE |
|--------------|----------------------------|----------|
| 1 | Changed 36" RCP to 30" RCP | 10/30/89 |

| | |
|------------------|---------------------------------------|
| DESIGNED: B.W.H. | SCALE: 1" = 20' HOR. 1" = 5' VERT. |
| DRAWN: B.W.H. | APPROVED: <i>[Signature]</i> |
| JOB NO: | DATE: 10/89 |
| | SHEET NO: 9 OF 19 |

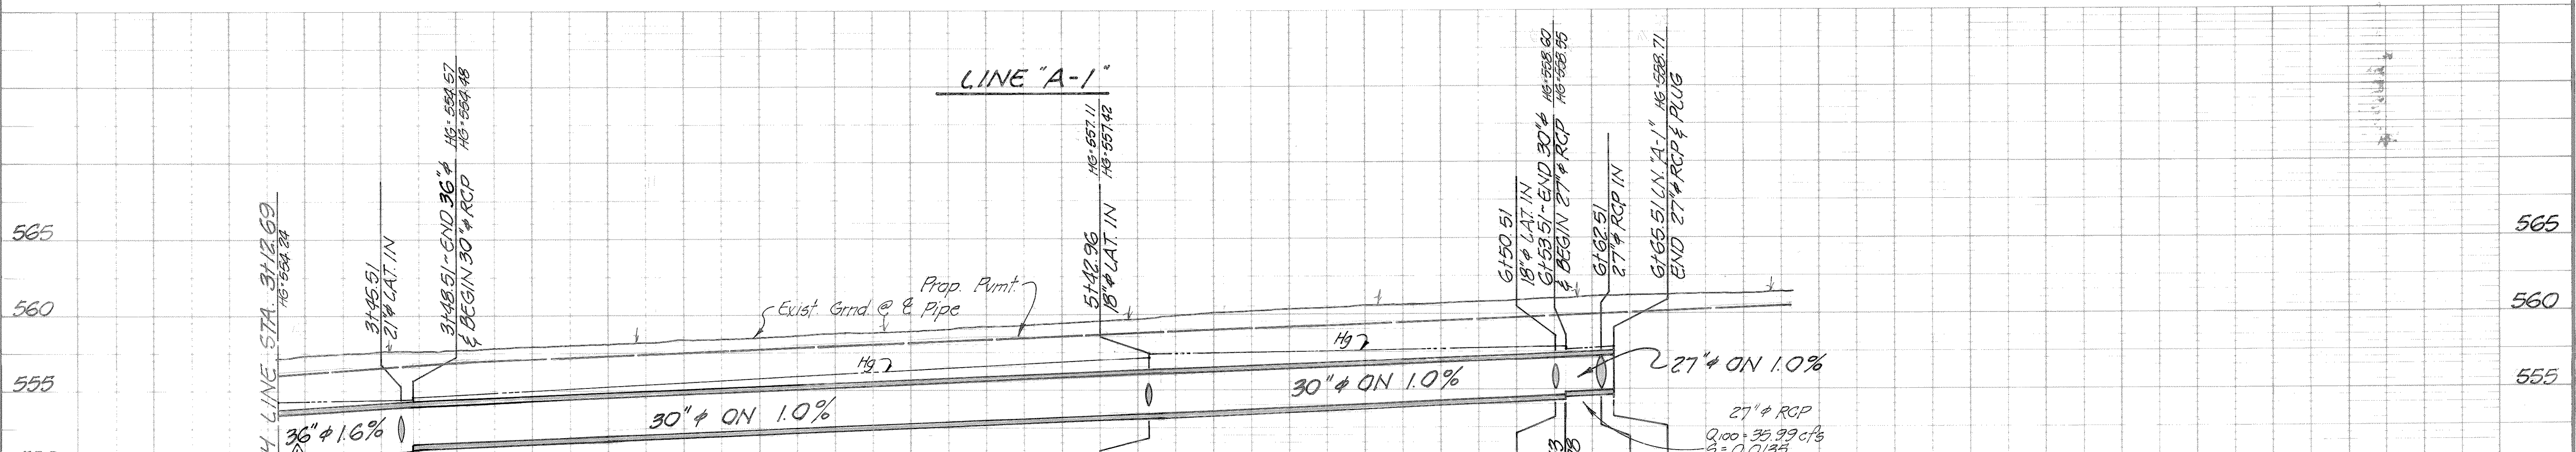