



BENCHMARK NO. 1
 R.R. SPIKE SET IN POWER POLE AT SOUTH SIDE OF I.H. 30 SERVICE ROAD, 180' EAST OF ROCKWALL CLASSIC CARS & BODY SHOP, ACROSS FROM I.H. 30 ENTRANCE RAMP. ELEV. 546.80

BENCHMARK NO. 2
 R.R. SPIKE SET IN TELE. POLE ON NORTH R.O.W. OF UNION PACIFIC RAILROAD, 50' EAST OF S.W. CHAINLINK FENCE CORNER OF LEON TUTTLE BALLFIELD COMPLEX. ELEV. 577.24

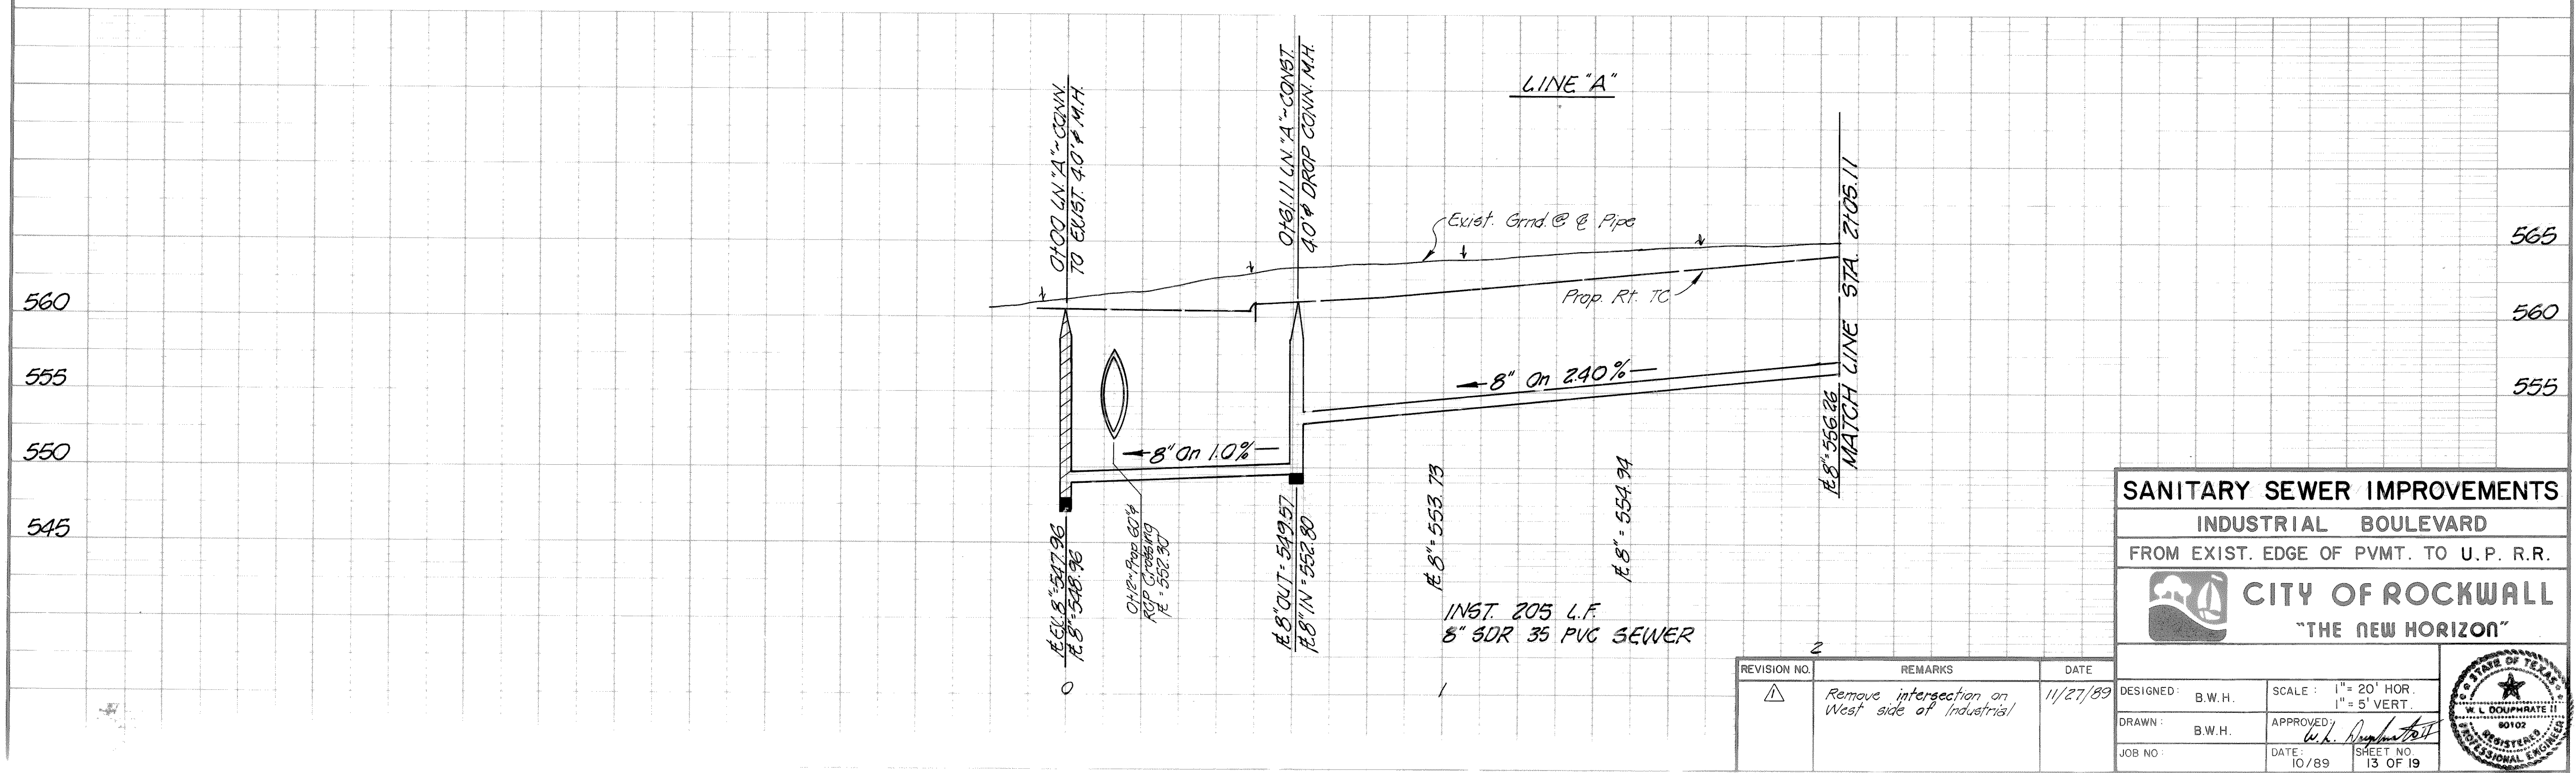

SANITARY SEWER IMPROVEMENTS
INDUSTRIAL BOULEVARD
 FROM EXIST. EDGE OF PVMT. TO U.P. R.R.

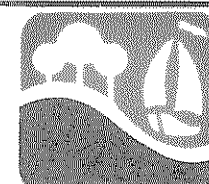

CITY OF ROCKWALL
 "THE NEW HORIZON"

REVISION NO.	REMARKS	DATE
2	Remove intersection on West side of Industrial	11/27/89

DESIGNED:	B.W.H.	SCALE:	1" = 20' HOR. 1" = 5' VERT.
DRAWN:	B.W.H.	APPROVED:	<i>W.L. Oculuprate II</i>
JOB NO:		DATE:	10/89
		SHEET NO:	13 OF 19

