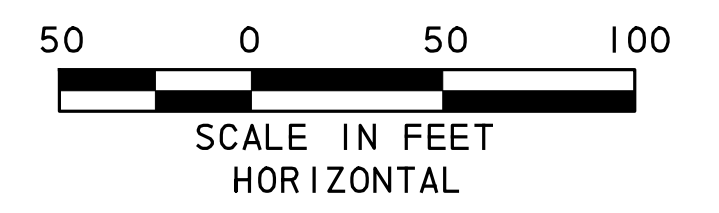
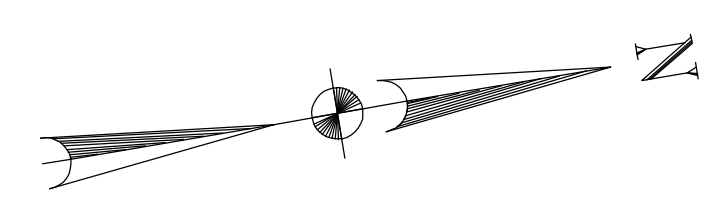

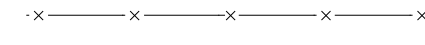

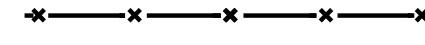
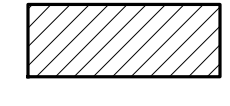
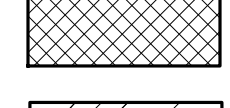
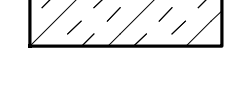

 
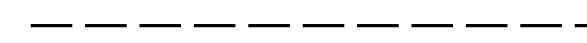
 


DESCRIPTION	UNIT	QUANTITY
STORM DRAIN STRUCTURE REMOVAL	LF	173
BASE AND ASPHALT REMOVAL	SY	2324
CONCRETE PAVEMENT REMOVAL	SY	410
FENCE REMOVAL	LF	172

THESE ITEMS ARE SUBSIDIARY TO ITEM 3.1 PREPARING RIGHT-OF-WAY AND SHOWN FOR CONTRACTORS INFORMATION ONLY.



LEGEND

-  EXIST. TREE TO REMAIN
-  EXIST. FENCE TO REMAIN
-  EXIST. TREE TO BE REMOVED (SEE NOTE 3)
-  EXIST. FENCE TO BE REMOVED
-  EXIST. BRUSH & SMALL DIAMETER TREES TO BE REMOVED
-  EXIST. ASPHALT PAVEMENT TO BE REMOVED
-  EXIST. CONCRETE TO BE REMOVED
-  PROP FENCE CORNER/PULL POST (MATCH EXIST TYPE PER TXDOT DETAIL WF(1)-94 OR WF(2)-96)
-  PROPOSED RIGHT-OF-WAY
-  DRAINAGE EASEMENT
-  TEMP. CONSTRUCTION EASEMENT


NOTES:

1. CONTRACTOR SHALL BE PAID FOR REMOVALS IN ACCORDANCE WITH SPEC. ITEM 3.1, PREPARING RIGHT-OF-WAY.
2. QUANTITIES SHOWN ARE FOR CONTRACTOR'S INFORMATION ONLY.
3. REMOVE ONLY THOSE TREES NECESSARY TO ALLOW CONSTRUCTION TO BE COMPLETED. SEE SPECIAL CONDITIONS IN THE CONTRACT DOCUMENTS.

RECORD DRAWING
 This drawing is a compilation of the original sealed engineering drawing and modifications by addenda, change orders and information furnished by the contractor. Information shown that was provided by the contractor and others not associated with the design engineer cannot be verified for accuracy or completeness. Original sealed drawing is on file at the office of AECOM USA Group, Inc., TBPE REG. NO. F-3082

ORIGINAL DRAWING SEALED & SIGNED BY
 T.H. Gaertner, P.E.
 TX NO. 37124


NO.	REVISION	BY	DATE

 **City of Rockwall, Texas**

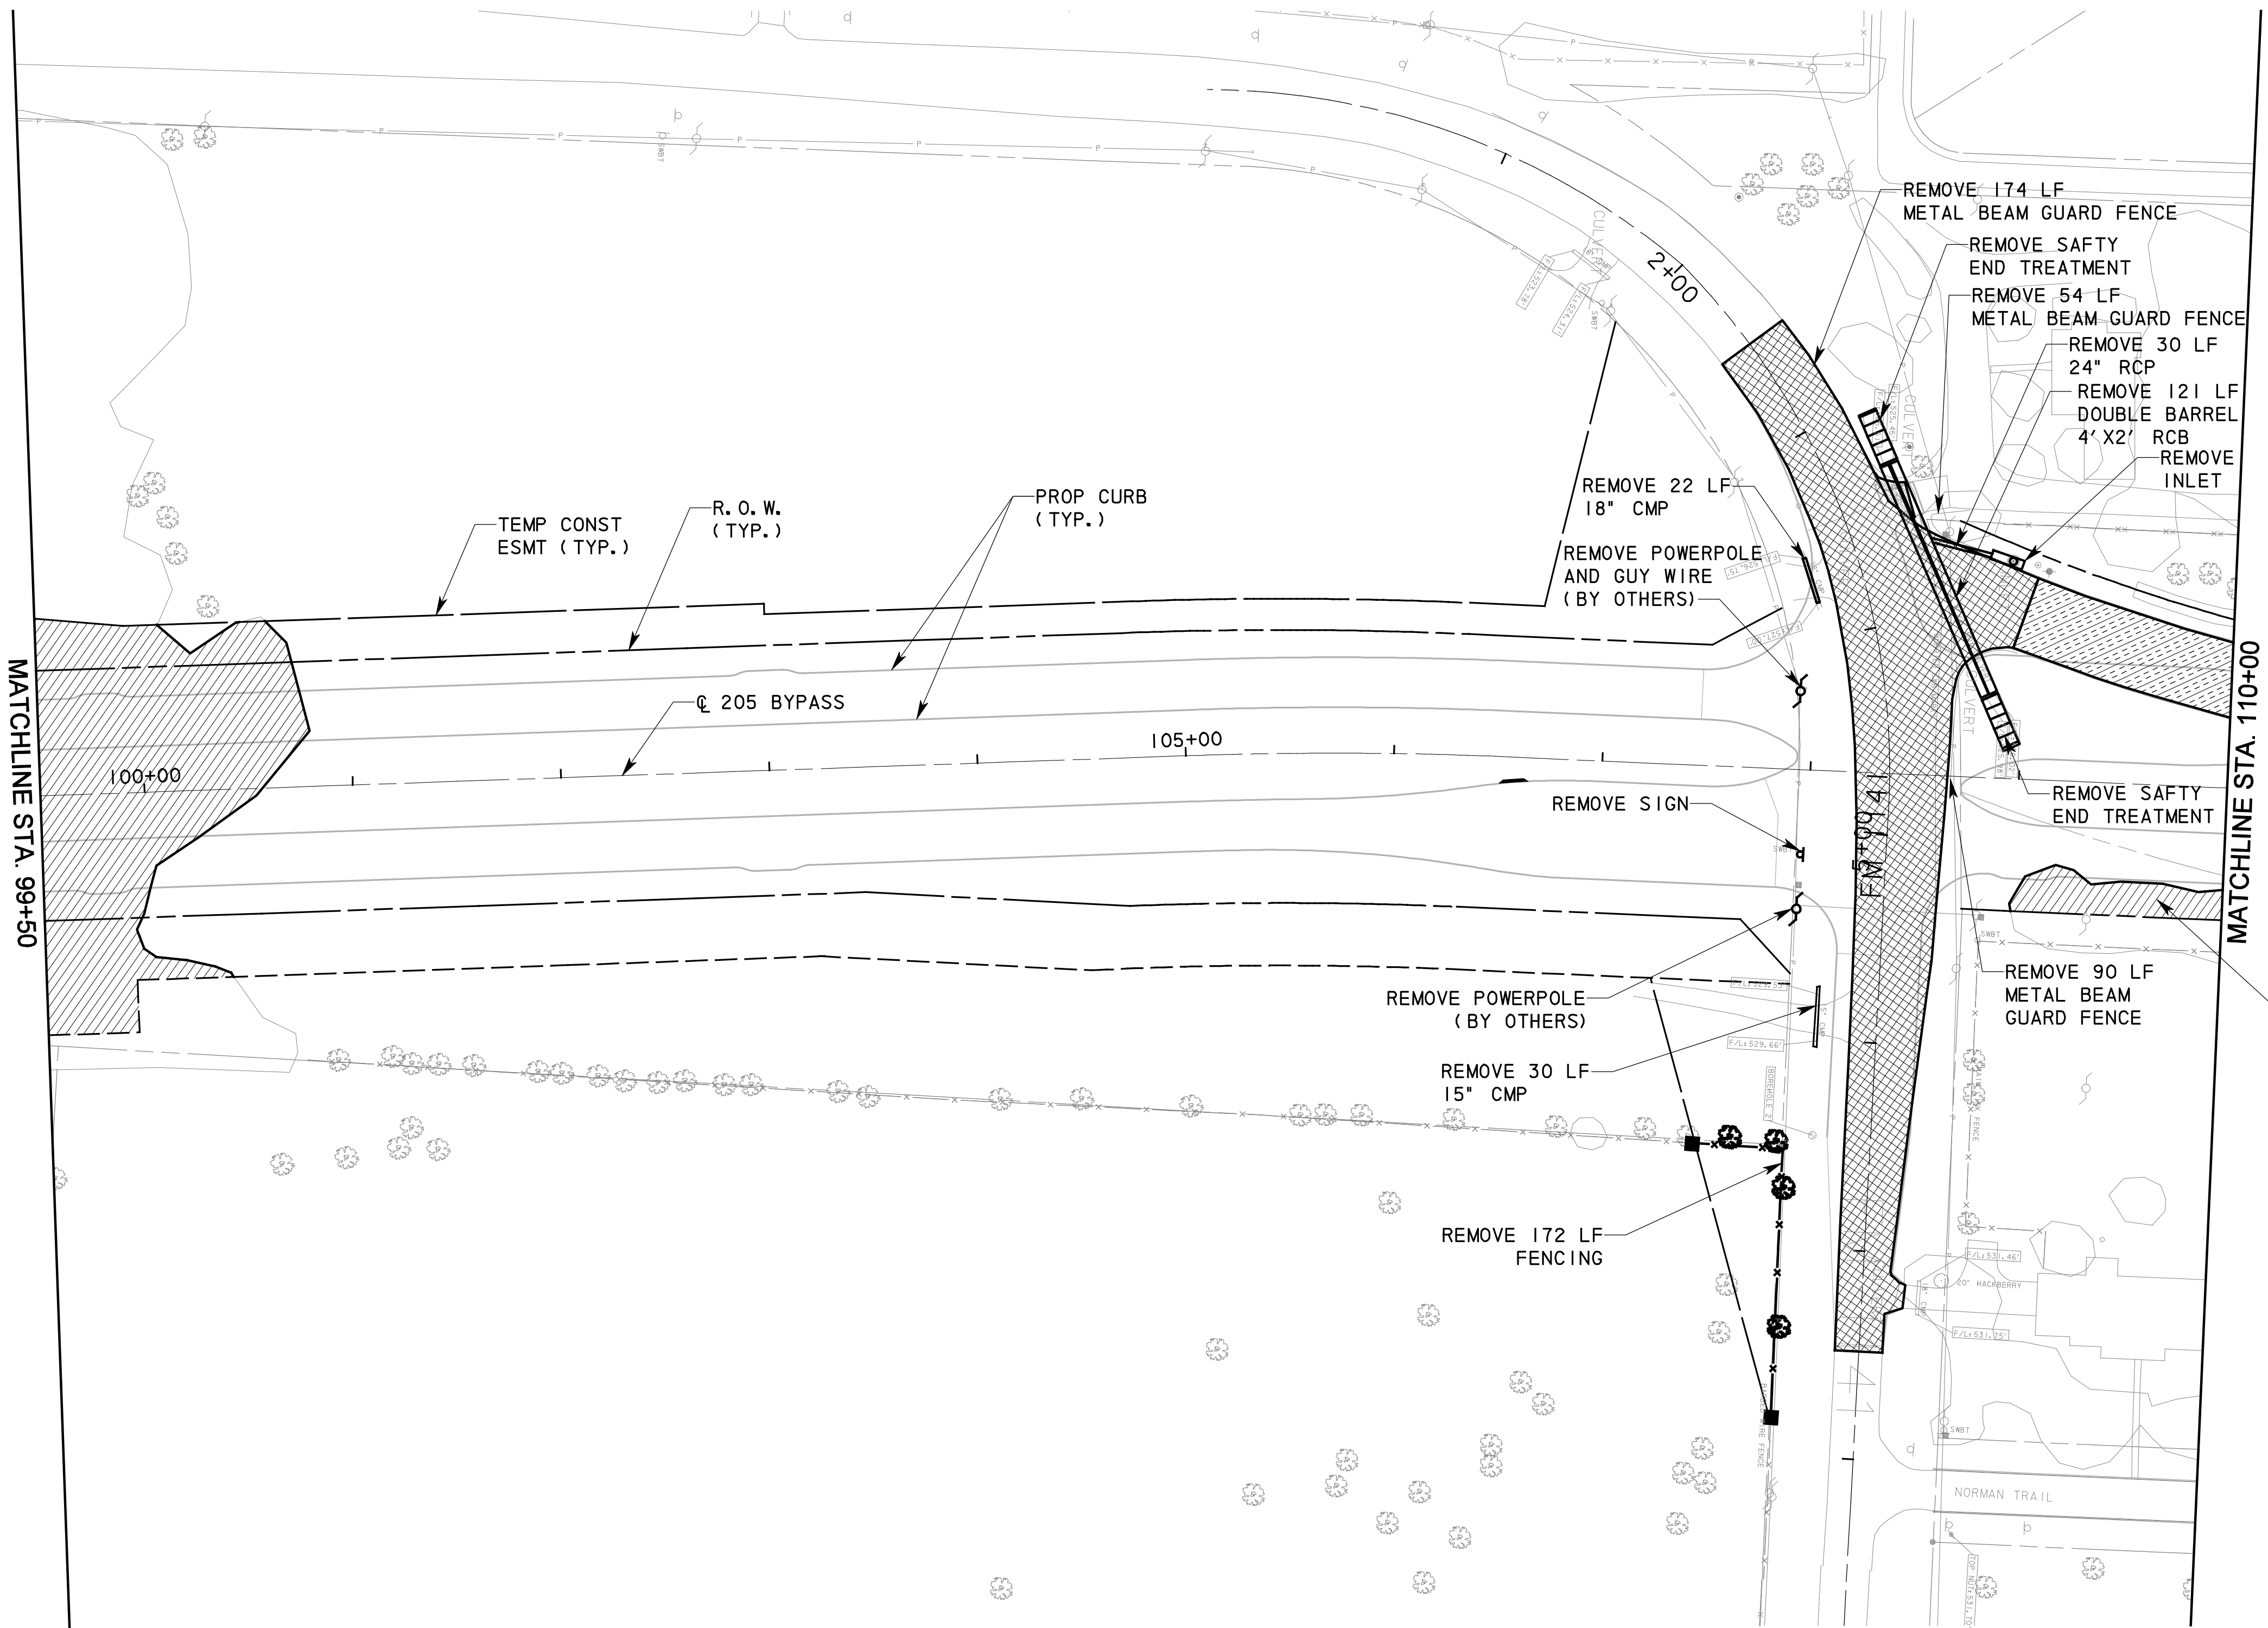205 BYPASS PHASE 2

DEMOLITION PLAN
 STA. 99+50 TO STA. 110+00

TCB AECOM		TCB INC. WWW.TCB.AECOM.COM 17300 DALLAS PARKWAY, SUITE 1010 DALLAS, TEXAS 75248	
Unit	PW-DAL-FW	Scale	AS SHOWN
Designed	THG	Checked	TCB
Drawn	FG	Approved	TCB
Date	11/23/2009	Project No.	60004153
Sheet	18	of	142



P:\4328\60004153\205Bypass\CADD\Sheets\Phase 2 - SH 66 To 120+00\Record Drawing 10_7_09\018Dem-03.dgn
 11/23/2009