


**LEGEND**

- RIGHT OF WAY
- - - TEMPORARY SLOPE EASEMENT
- - - DRAINAGE EASEMENT
- ▭ CONCRETE PAVEMENT
- ▨ HMAC PAVEMENT

**NOTES:**

1. CONSTRUCT LANDSCAPE MAINTENANCE RAMP. SEE MISCELLANEOUS ROADWAY DETAILS.

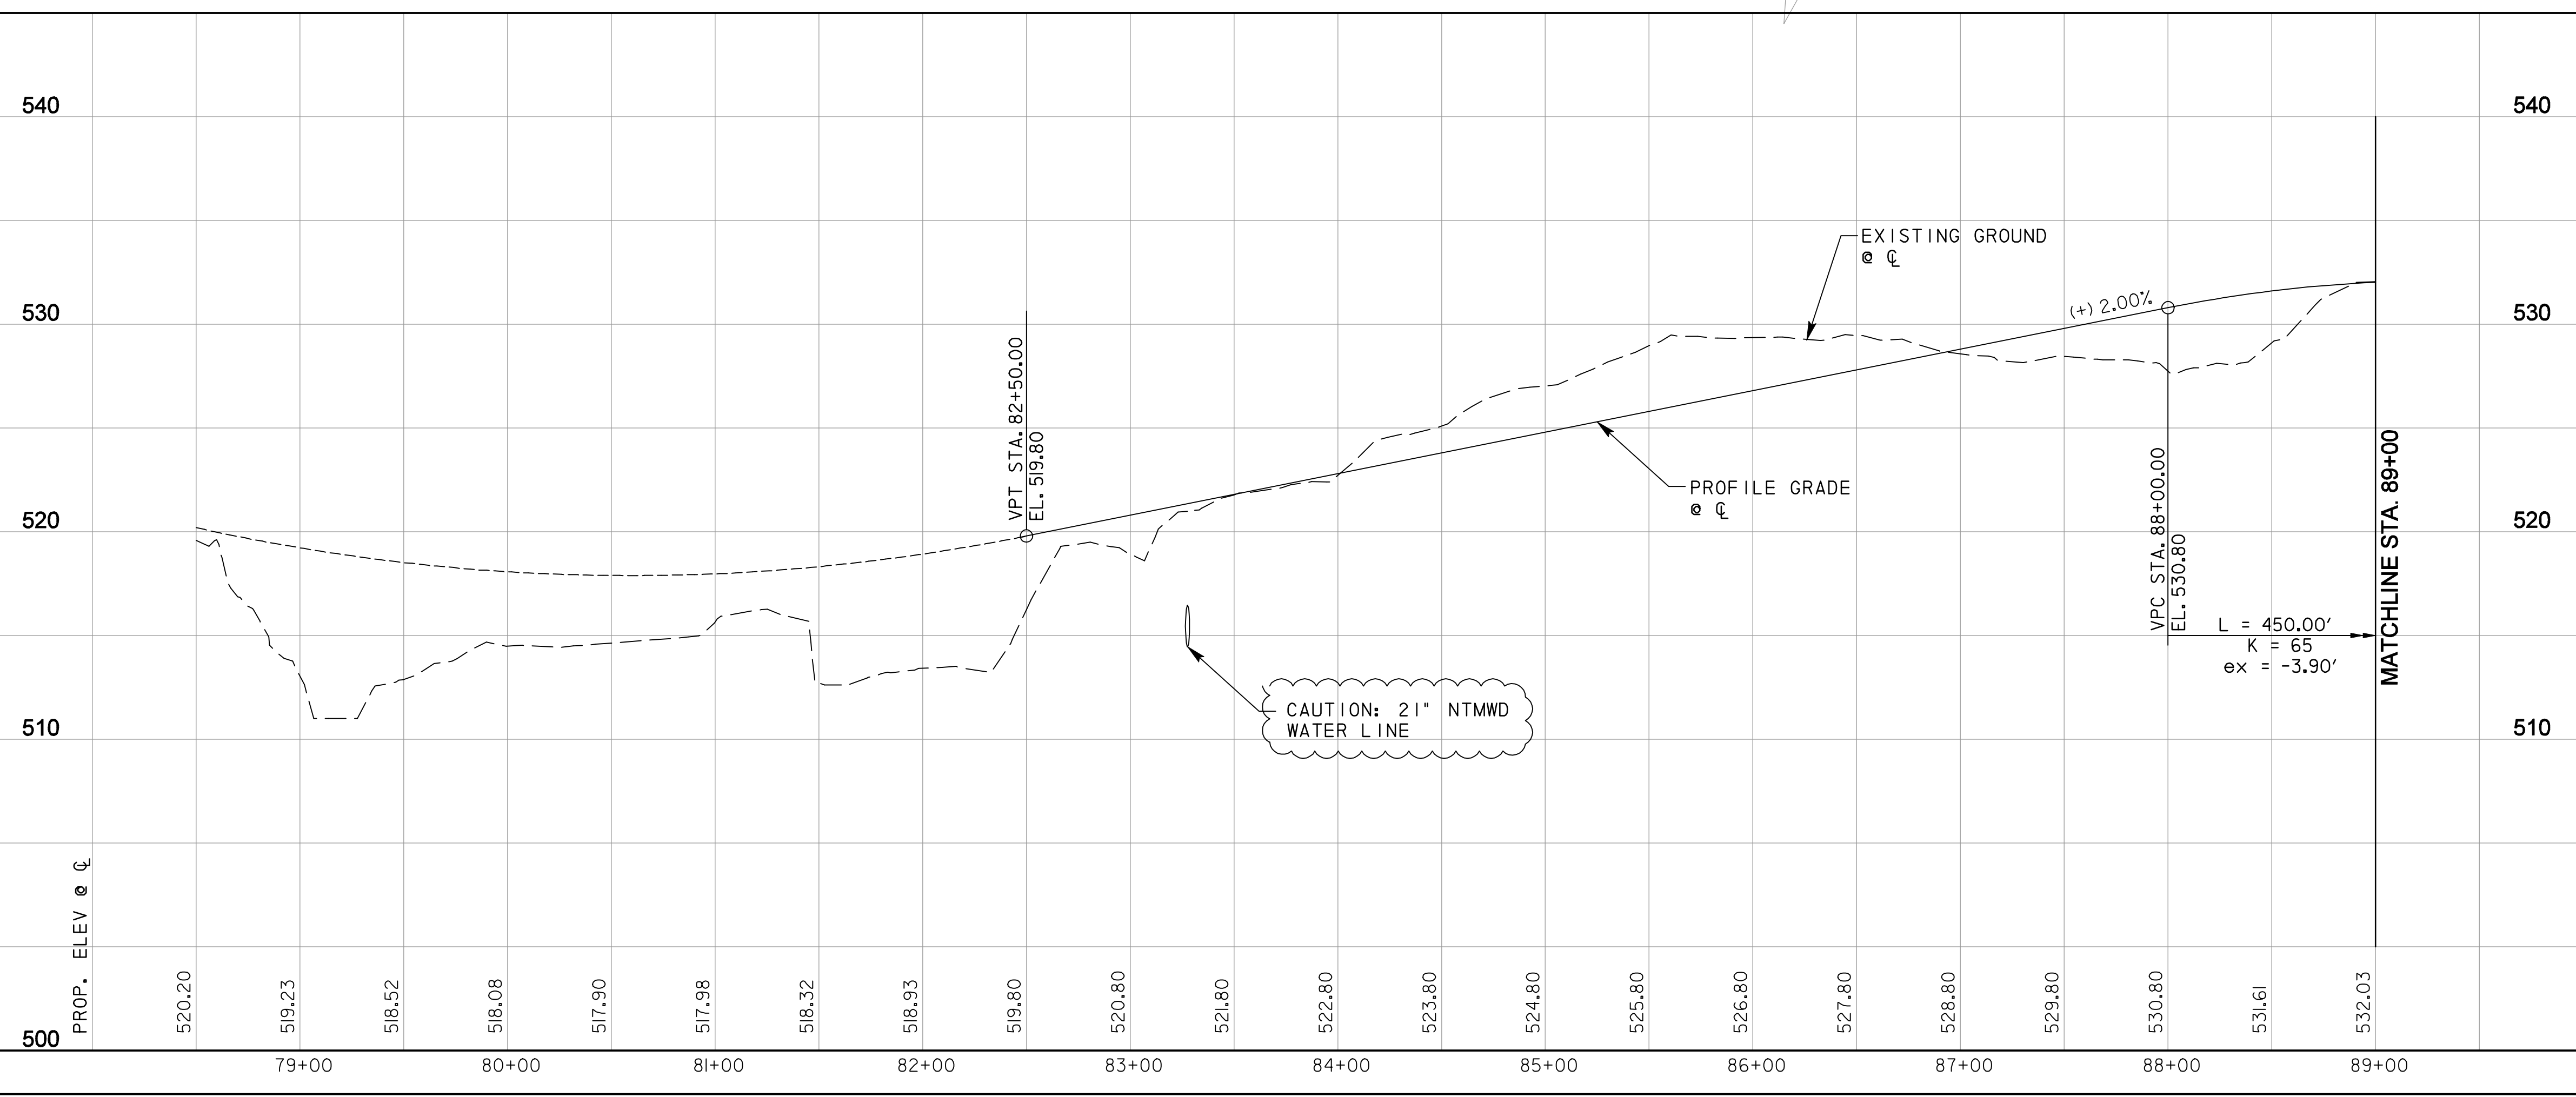

**RECORD DRAWING**  
 This drawing is a compilation of the original sealed engineering drawing and modifications by addenda, change orders and information furnished by the contractor. Information shown that was provided by the contractor and others not associated with the design engineer cannot be verified for accuracy or completeness. Original sealed drawing is on file at the office of AECOM USA Group, Inc., TBPE REG. NO. F-3082

**ORIGINAL DRAWING SEALED & SIGNED BY**  
 T.H. Gaertner, P.E.  
 TX NO. 37124

NO.	REVISION	BY	DATE
1	ADDED NTMWD WATER LINE	THG	08/18/08



**205 BYPASS PHASE 2**

**PLAN & PROFILE STA. 82+50 TO STA. 89+00**

**TCB AECOM**  
 TCB INC. WWW.TCB.AECOM.COM  
 17300 DALLAS PARKWAY, SUITE 1010  
 DALLAS, TEXAS 75248

Unit	PW-DAL-FW	Scale	Horz: AS SHOWN Vert: AS SHOWN	Date	11/23/2009
Designed	THG	Checked	TCB	Project No.	60004153
Drawn	FG	Approved	TCB	Sheet	23 of 142

P:\4328\60004153\205Bypass\CADD\Sheets\Phase 2 - SH 66 To 120+00\Record Drawing 10\_7\_09\023Pov\ngpp-205BP01.dgn  
 11/23/2009