


P:\4328\60004\53-205Bypass\CADD\Sheets\Phase 2- SH 66 To 120+00\Record Drawing 10_7_09\023\IntersectLay-SH66-01.dgn
 11/23/2009

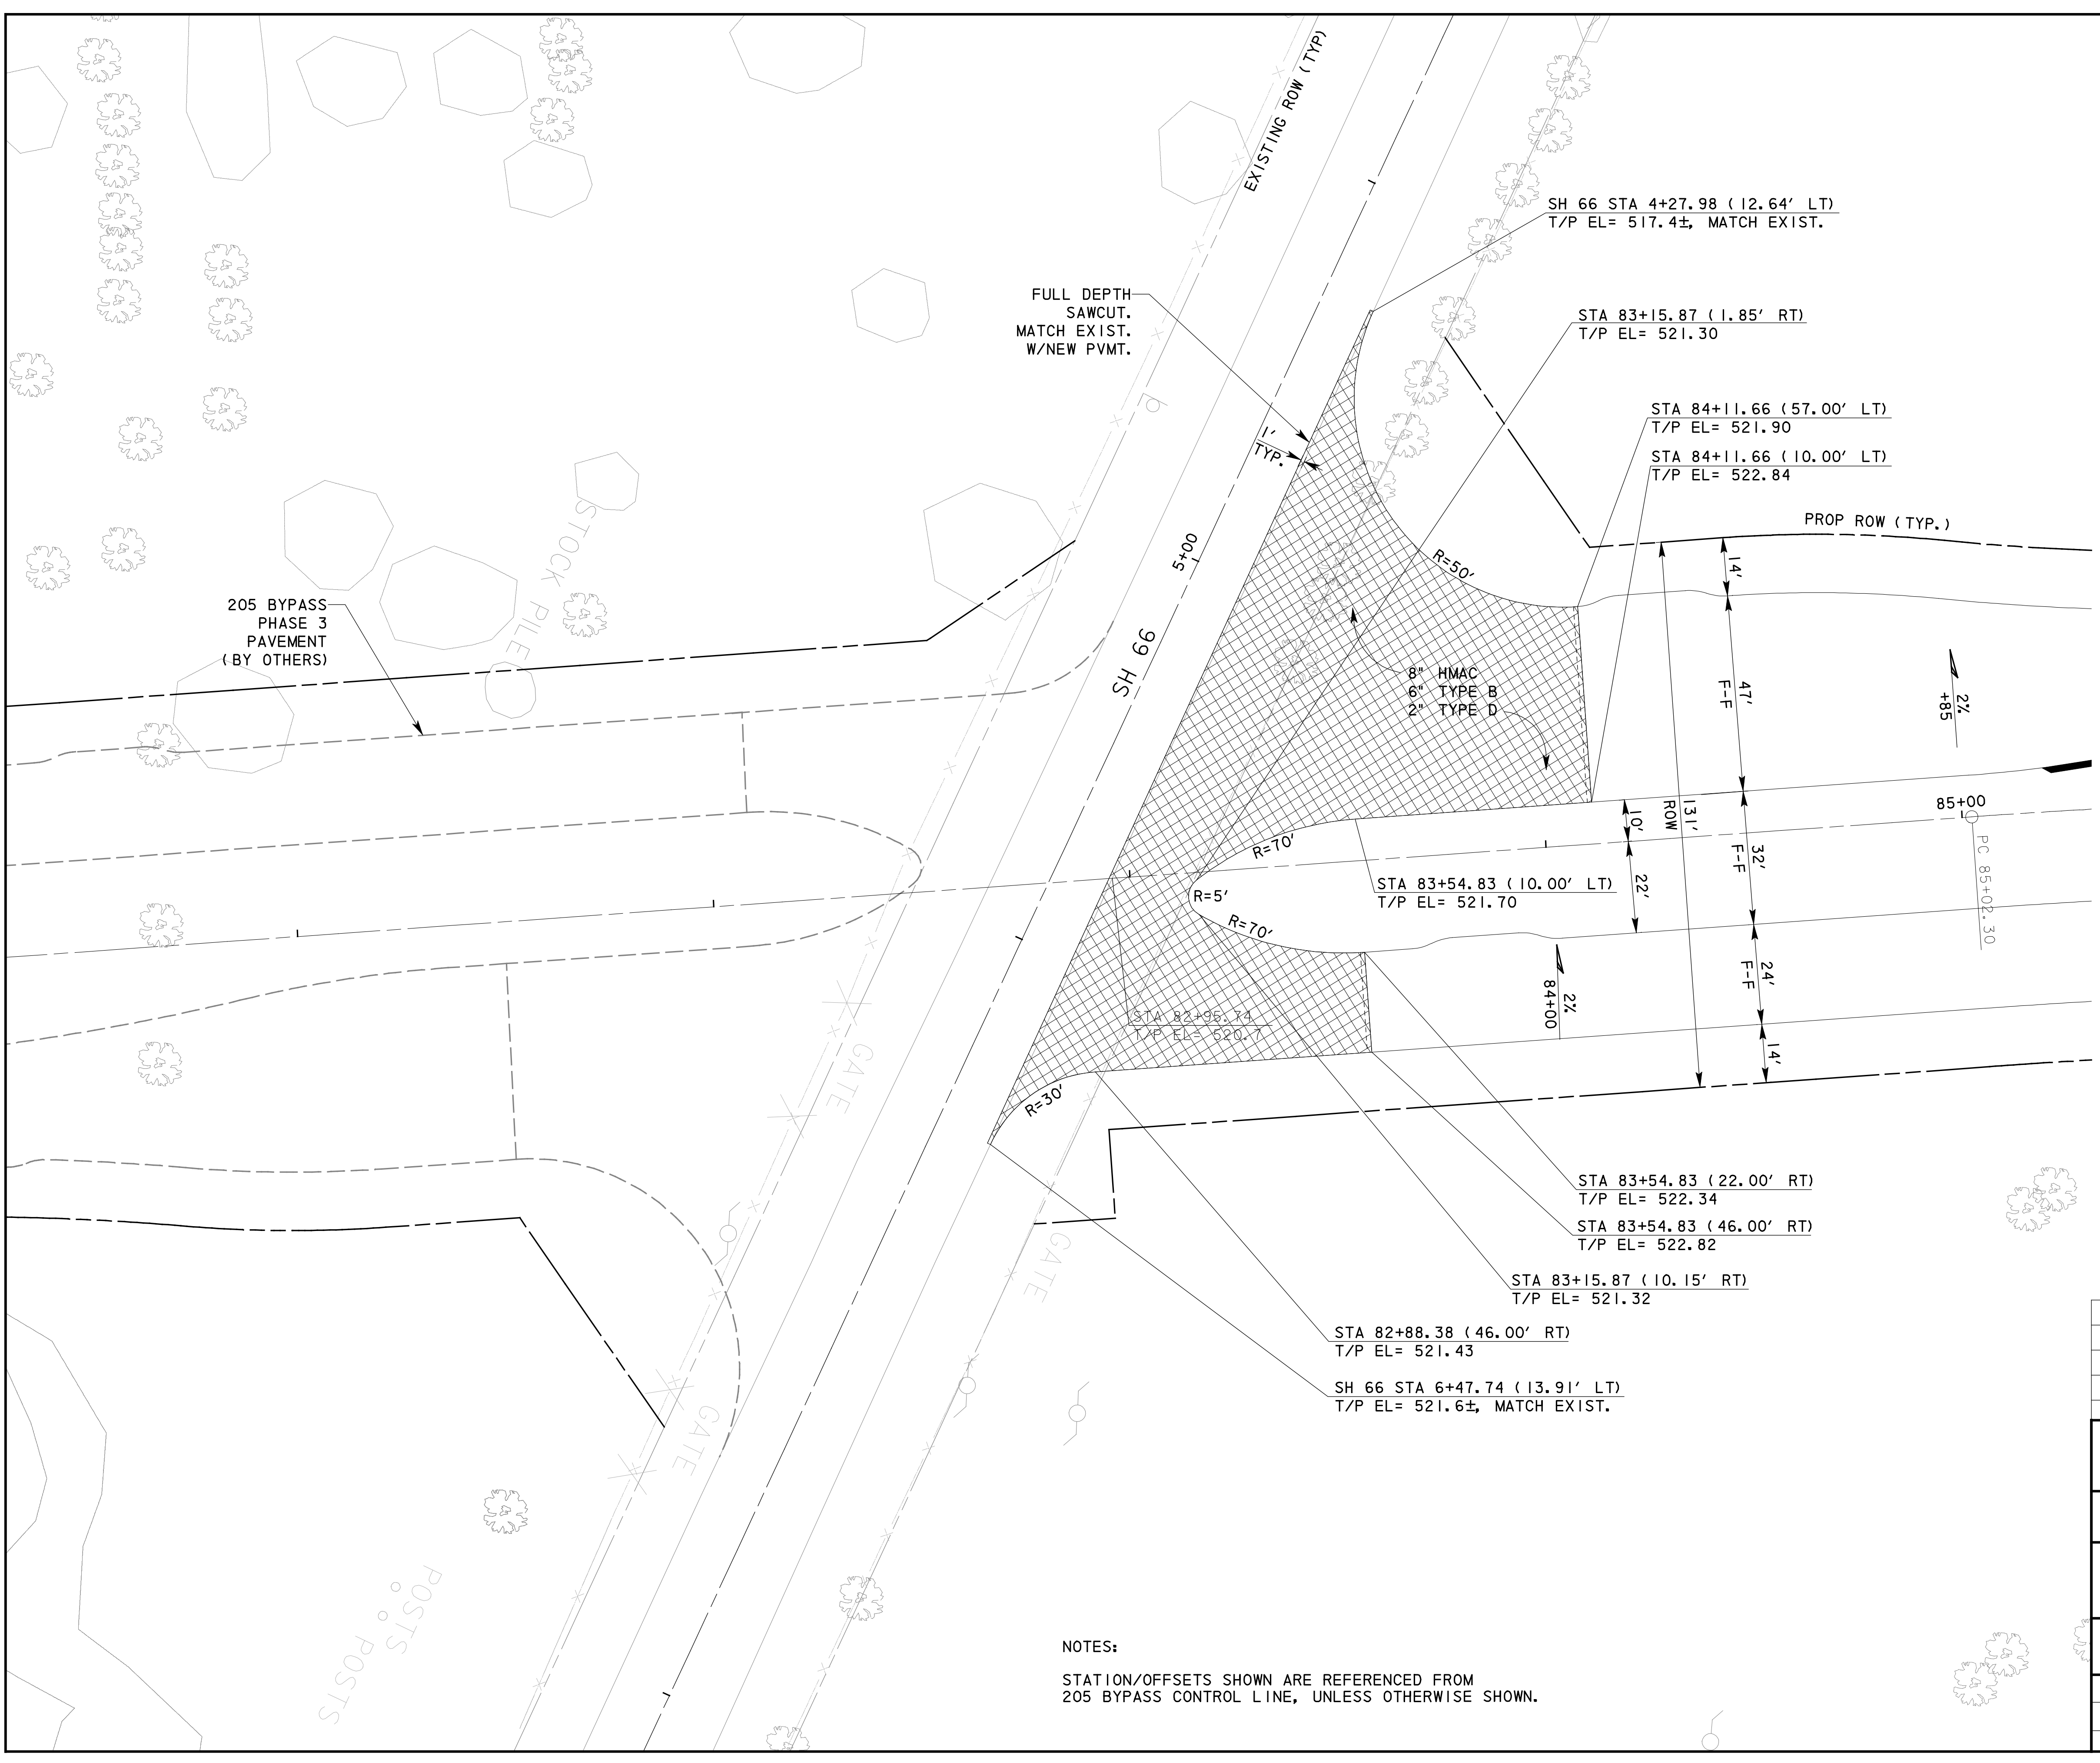


205 BYPASS
PHASE 3
PAVEMENT
(BY OTHERS)

FULL DEPTH
SAWCUT.
MATCH EXIST.
W/NEW PVMT.

RECORD DRAWING
 This drawing is a compilation of the original sealed engineering drawing and modifications by addenda, change orders and information furnished by the contractor. Information shown that was provided by the contractor and others not associated with the design engineer cannot be verified for accuracy or completeness. Original sealed drawing is on file at the office of AECOM USA Group, Inc., TBPE REG. NO. F-3082

**ORIGINAL DRAWING
SEALED & SIGNED BY**
 T.H. Gaertner, P.E.
 TX NO. 37124

NOTES:
 STATION/OFFSETS SHOWN ARE REFERENCED FROM
 205 BYPASS CONTROL LINE, UNLESS OTHERWISE SHOWN.

NO.	REVISION	BY	DATE
 City of Rockwall, Texas			
205 BYPASS PHASE 2			
SH 66 INTERSECTION LAYOUT			
TCB AECOM		<small>TCB INC. WWW.TCB.AECOM.COM 17300 DALLAS PARKWAY, SUITE 1010 DALLAS, TEXAS 75248</small>	
Unit	PW-DAL-FW	Scale	Horz: AS SHOWN Vert: AS SHOWN
Designed	THG	Checked	TCB
Drawn	FG	Approved	TCB
Date	11/23/2009	Project No.	60004153
Sheet	29	of	142