


LEGEND

- PROPOSED ROW
- ==== PROPOSED STORM DRAIN
- DRAINAGE EASEMENT
- TEMP. CONST. EASEMENT

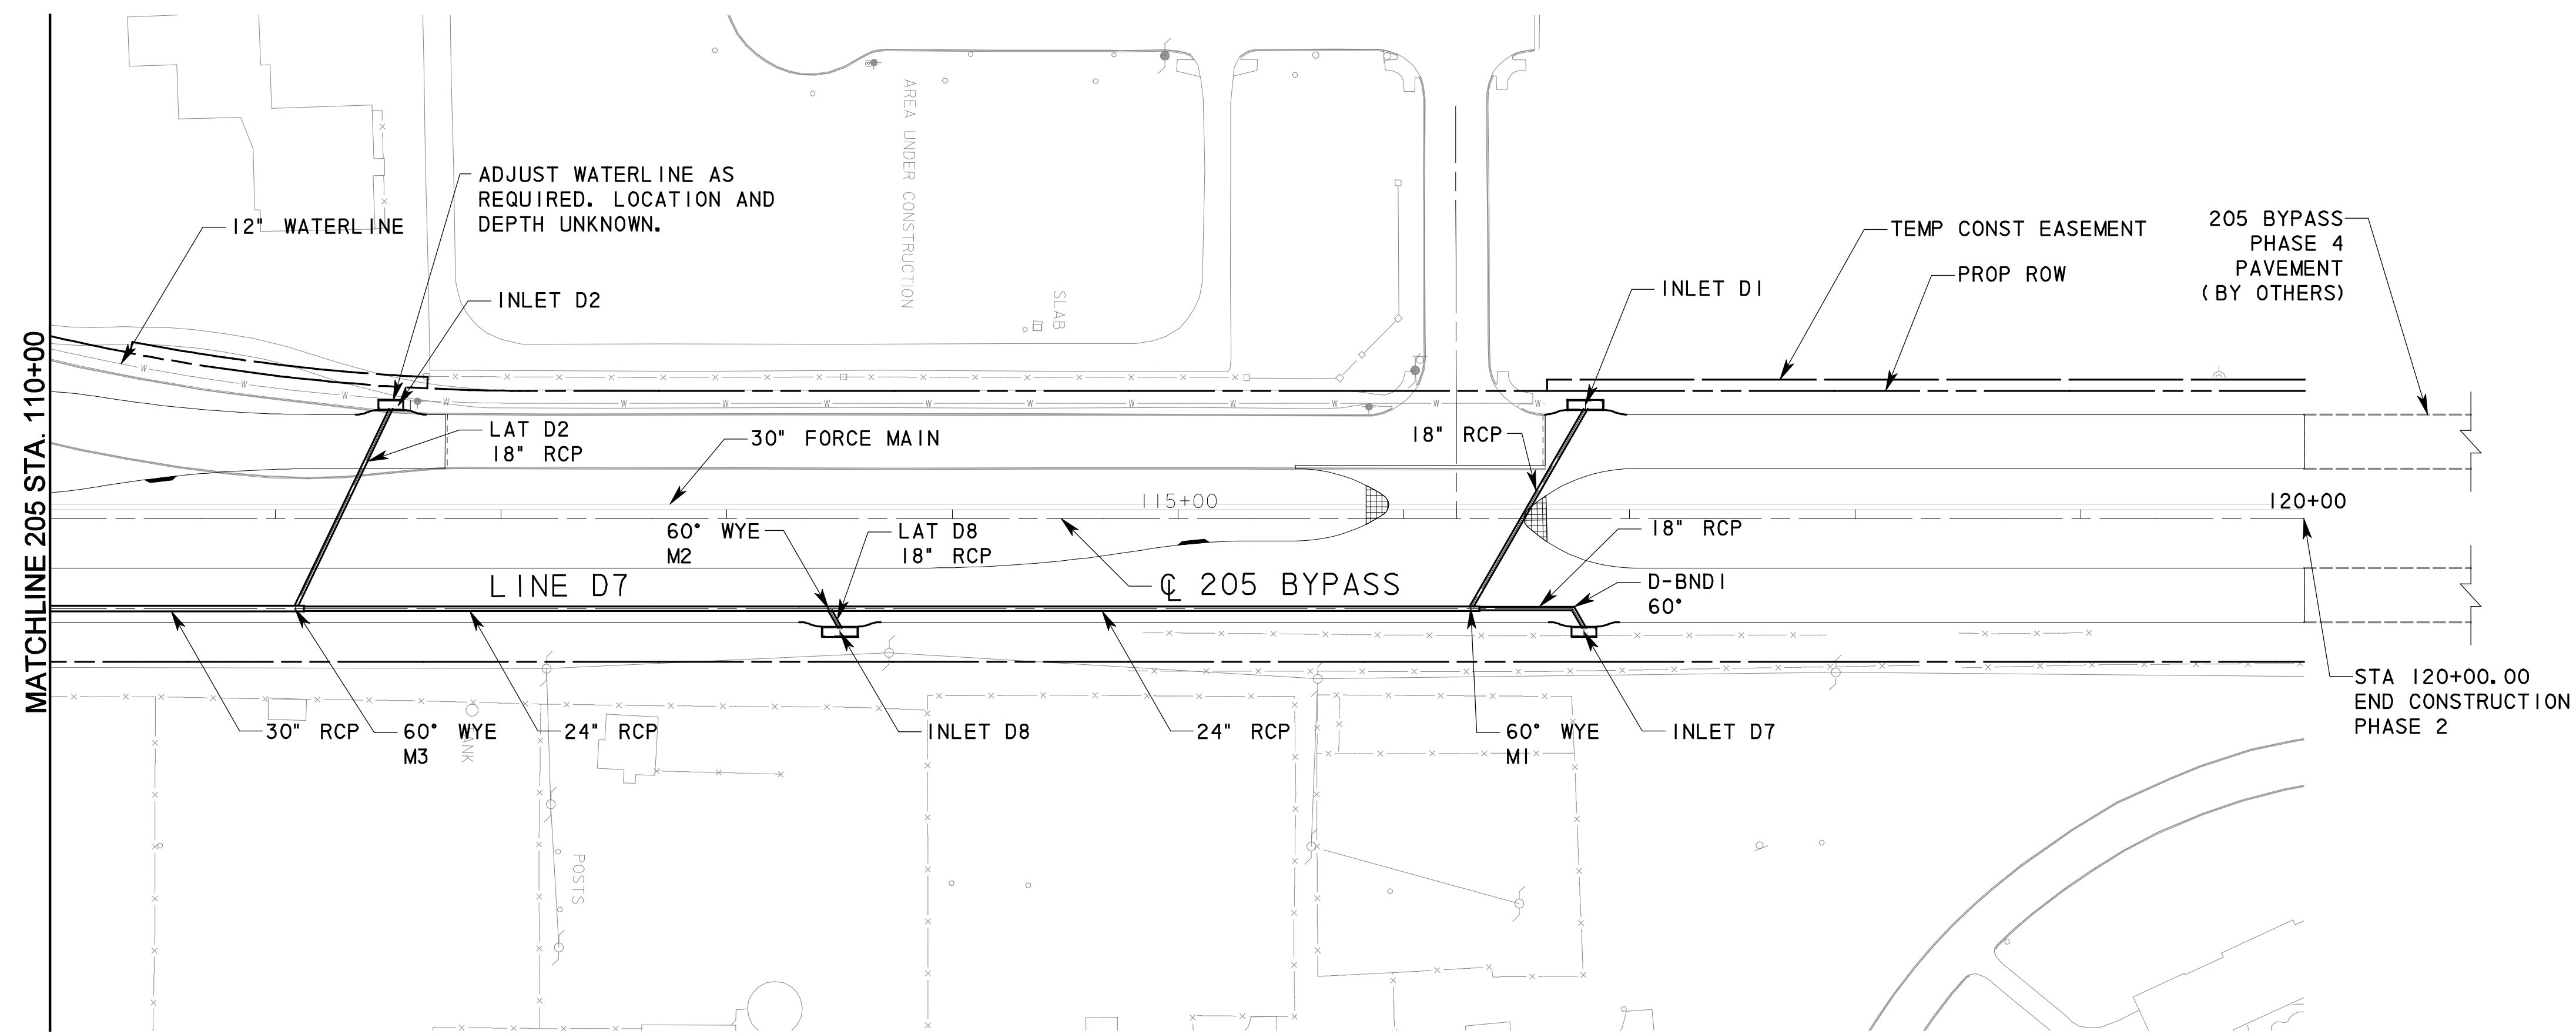

RECORD DRAWING
 This drawing is a compilation of the original sealed engineering drawing and modifications by addenda, change orders and information furnished by the contractor. Information shown that was provided by the contractor and others not associated with the design engineer cannot be verified for accuracy or completeness. Original sealed drawing is on file at the office of AECOM USA Group, Inc., TBPE REG. NO. F-3082

ORIGINAL DRAWING SEALED & SIGNED BY
 T.H. Gaertner, P.E.
 TX NO. 37124

NO.	REVISION	BY	DATE

City of Rockwall, Texas

205 BYPASS PHASE 2

STORM PLAN
 STA. 110+00 TO STA. 120+00

TCB | AECOM
 TCB INC.
 WWW.TCB.AECOM.COM
 17300 DALLAS PARKWAY, SUITE 1010
 DALLAS, TEXAS 75248

Unit	PW-DAL-FW	Scale:	Horz: AS SHOWN Vert: AS SHOWN	Date	11/23/2009
Designed	SDB	Checked	TCB	Project No.	60004153
Drawn	FG	Approved	TCB	Sheet	45 of 142