

LEGEND

- A 4" WHITE SOLID
- (B) WHITE BUTTON TYPE LANE LINE
- WHITE BUTTON TURN BAY LINE.
- (D) 4" YELLOW SOLID
- (E) 4" DOUBLE YELLOW SOLID
- (F) 24" WHITE STOP BAR
- "ONLY" WHITE
- WHITE LEFT TURN ARROW
- WHITE RIGHT TURN ARROW
- 12" WHITE SOLID
- 12" YELLOW SOLID
- (L) WHITE ARROW


NOTE:

SEE MISC. ROADWAY DETAIL SHEET 2 OF 2 FOR MORE PAVEMENT MARKINGS DETAILS.

RECORD DRAWING

This drawing is a compilation of the original sealed engineering drawing and modifications by addenda, change orders and information furnished by the contractor. Information shown that was provided by the contractor and others not associated with the design engineer cannot be verified for accuracy or completeness. Original sealed drawing is on file at the office of AECOM USA Group, Inc., TBPE REG. NO. F-3082

ORIGINAL DRAWING SEALED & SIGNED BY T.H. Gaertner, P.E. TX NO. 37124

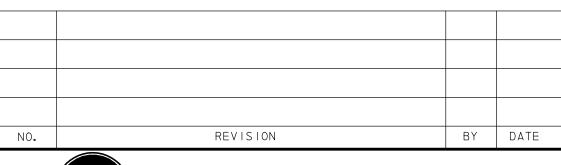



City of Rockwall, Texas

205 BYPASS PHASE 2

PAVEMENT MARKING AND SIGNING STA 110+00 TO STA 120+00

Horz: AS SHOWN	TCB INC. WWW.TCB.AECOM.COM 17300 DALLAS PARKWAY, SUITE 1010 DALLAS, TEXAS 75248					ТСВ		
T FW-DAL-FW scale: Vert: AS SHOWN Date 11/53/5003	3/2009	11/23,	Date			PW-DAL-FW	+ [
igned THG Checked TCB Project No. 60004153	004153	600	Project No.	ked TCB	Checked	THG	igned	
wn FG Approved TCB Sheet 68 of 142	of 142	68	Sheet	oved TCB	Approved	FG	IWN	

STA 112+00