


Parcel	Owner Name
l	Rockwall Property Corporation
J	Burks T. Payne Jr.
K	Regal Realtors
L	Lumbermens Investment Corporation

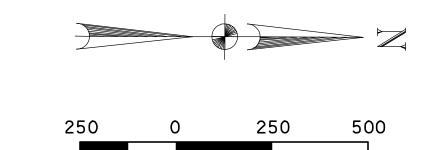


NOTE:
30" FORCE MAIN PIPE HAS BEEN PREVIOUSLY
PURCHASED BY OWNER AND IS STORED AT
MANUFACTURER'S FACILITY. CONTRACTOR
IS RESPONSIBLE FOR DELIVERY AND INSTALLATION OF PIPE MATERIAL, AND IS REPONSIBLE FOR PURCHASE, DELIVERY, AND INSTALLATION OF ALL FITTINGS AND VALVES SHOWN ON THESE PLANS.

RECORD DRAWING

This drawing is a compilation of the original sealed engineering drawing and modifications by addenda, change orders and information furnished by the contractor. Information shown that was provided by the contractor and others not associated with the design engineer cannot be verified for accuracy or completeness. Original sealed drawing is on file at the office of AECOM USA Group, Inc., TBPE REG. NO. F-3082

ORIGINAL DRAWING SEALED & SIGNED BY Nicholas R. Batker, P.E. TX NO. 92749

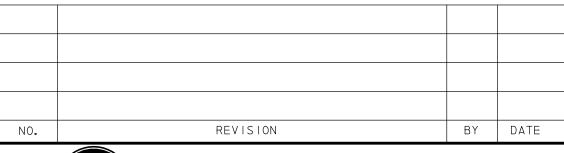



City of Rockwall, Texas

205 BYPASS PHASE 2

PROJECT LAYOUT PLAN & PROFILE SHEET INDEX

TC	B AECO	17300 DA	B.AECOM.COM LLAS PARKWAY TEXAS 75248	, SUITE 101	10		
+ PW-DAL-FW	Horz: Scale: Vert:	: 40 : 0	Date	11/23	3/200	9	
signed JLT/SDB	Checked	NRB	Project No.	600)2378	4	
awn TCB	Approved	NRB	Sheet	72	of	142	
		_	_				