



City of Rockwall, Texas

CONSTRUCTION PLANS FOR JOHN KING BOULEVARD (205 BYPASS) - PHASE 3 FROM I.H. 30 TO S.H. 66

MAY 2008


MAYOR
Bill Cecil

MAYOR PRO-TEM
Stephen Straughan

CITY COUNCIL
Glen Farris
Mathew R. Scott
David Sweet
Cliff Sevier
Margo Nielsen

CITY MANAGER
Julie Couch

CITY ENGINEER
Chuck Todd

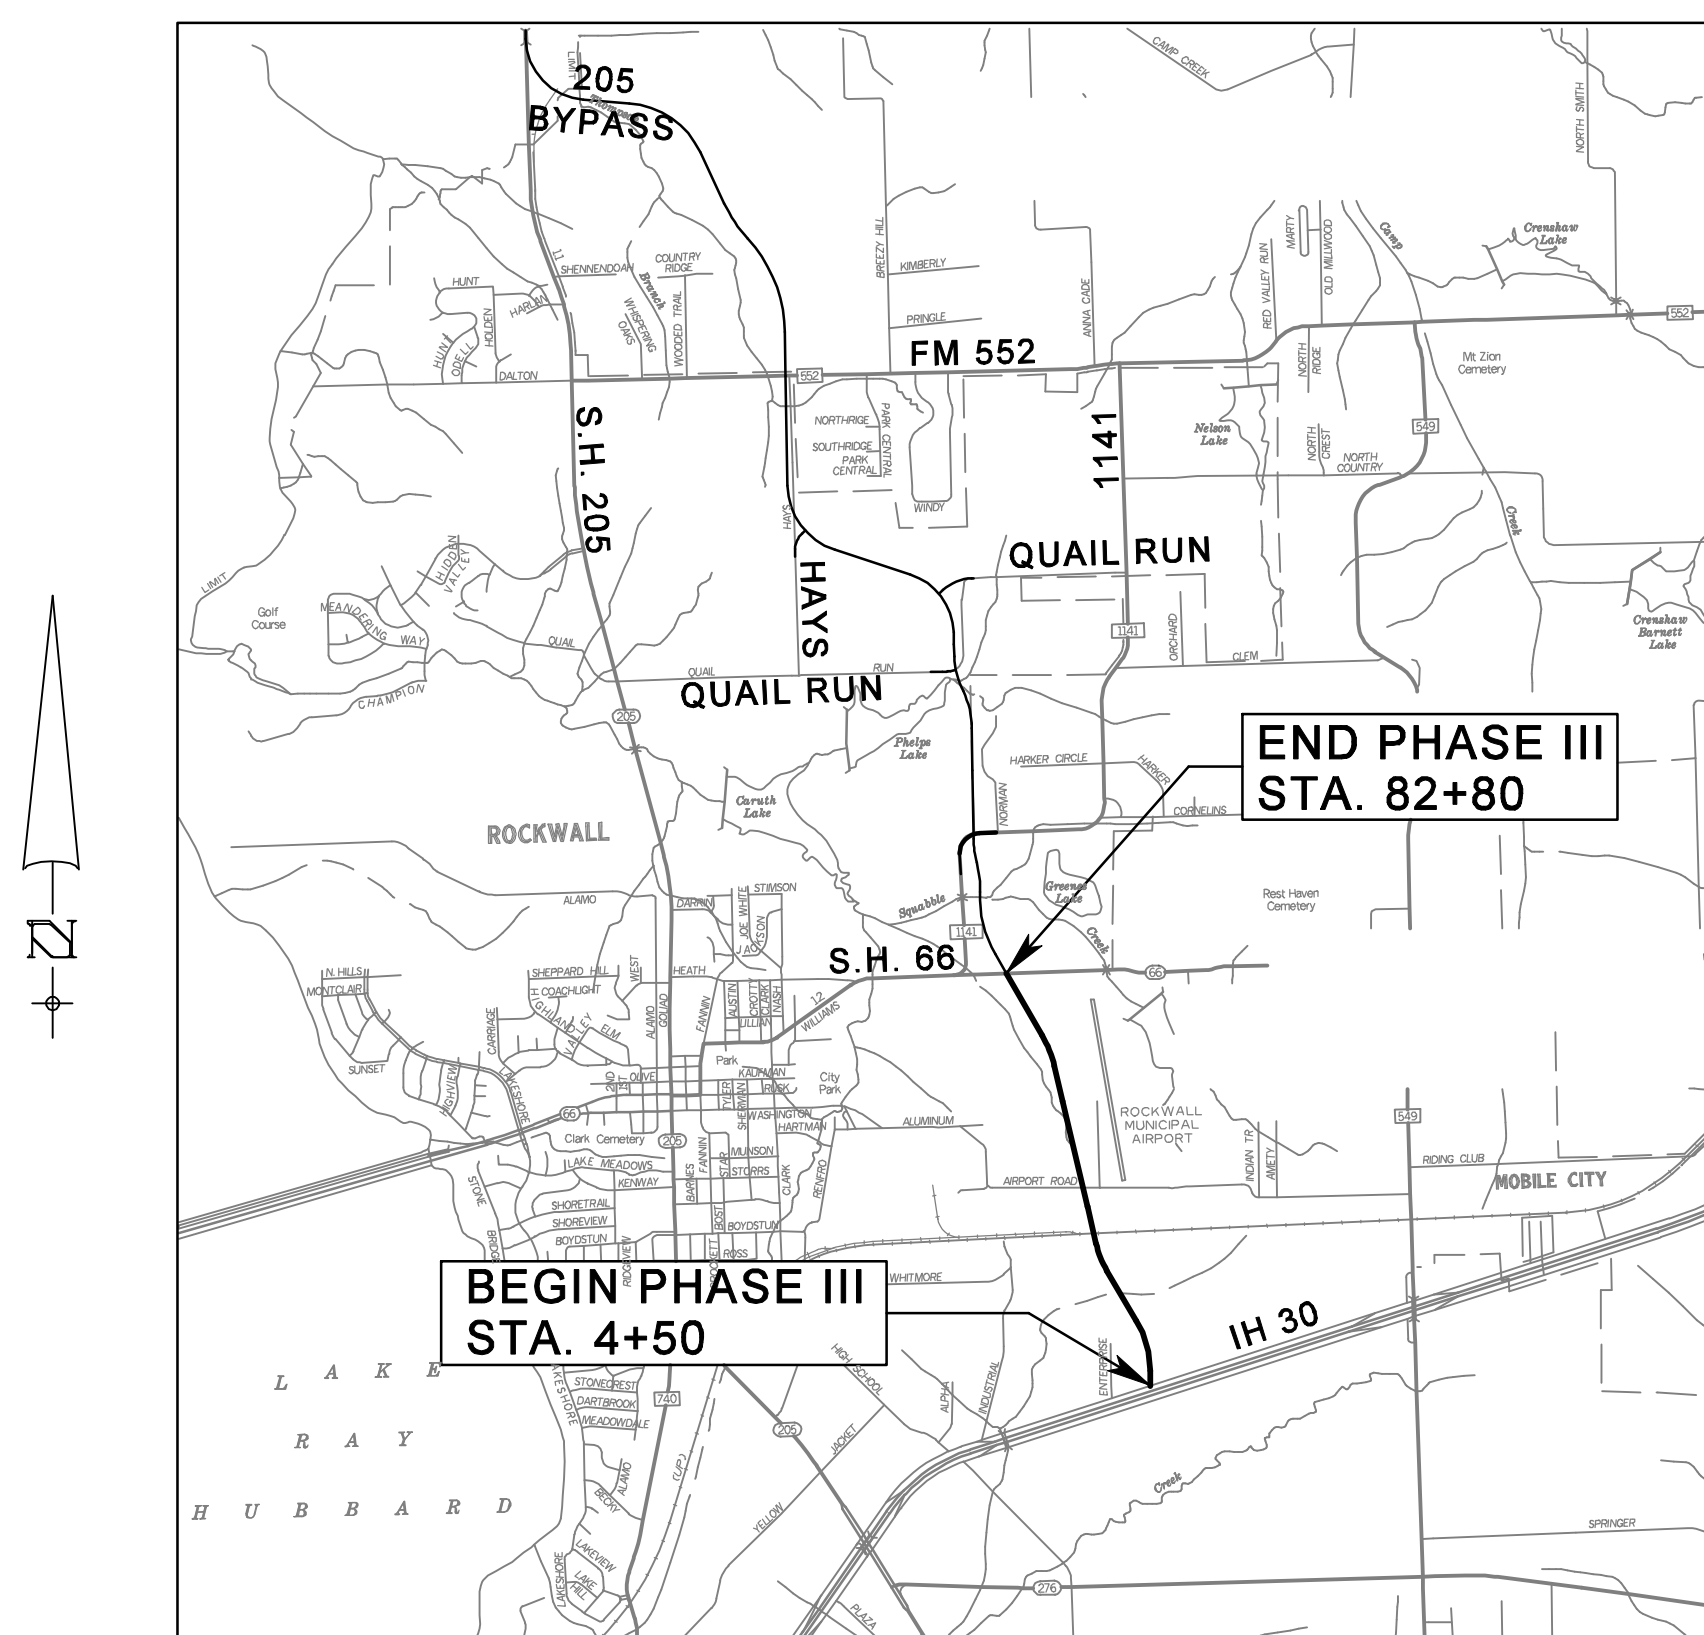

PROJECT LENGTH = 5511 LF

VICINITY MAP
SCALE: N.T.S.

RECORD DRAWING
This drawing is a compilation of the original sealed engineering drawing and modifications by addenda, change orders and information furnished by the contractor. Information shown that was provided by the contractor and others not associated with the design engineer cannot be verified for accuracy or completeness. Original sealed drawing is on file at the office of AECOM USA Group, Inc., TBPE REG. NO. F-3082

ORIGINAL DRAWING
SEALED & SIGNED BY
Gregory G. Hooten, P.E.
TX NO. 83936

ORIGINAL DRAWING
SEALED & SIGNED BY
T.H. Gaertner, P.E.
TX NO. 37124



TCB INC.
17300 DALLAS PARKWAY, SUITE 1010
DALLAS, TEXAS 75248
WWW.TCB.AECOM.COM