



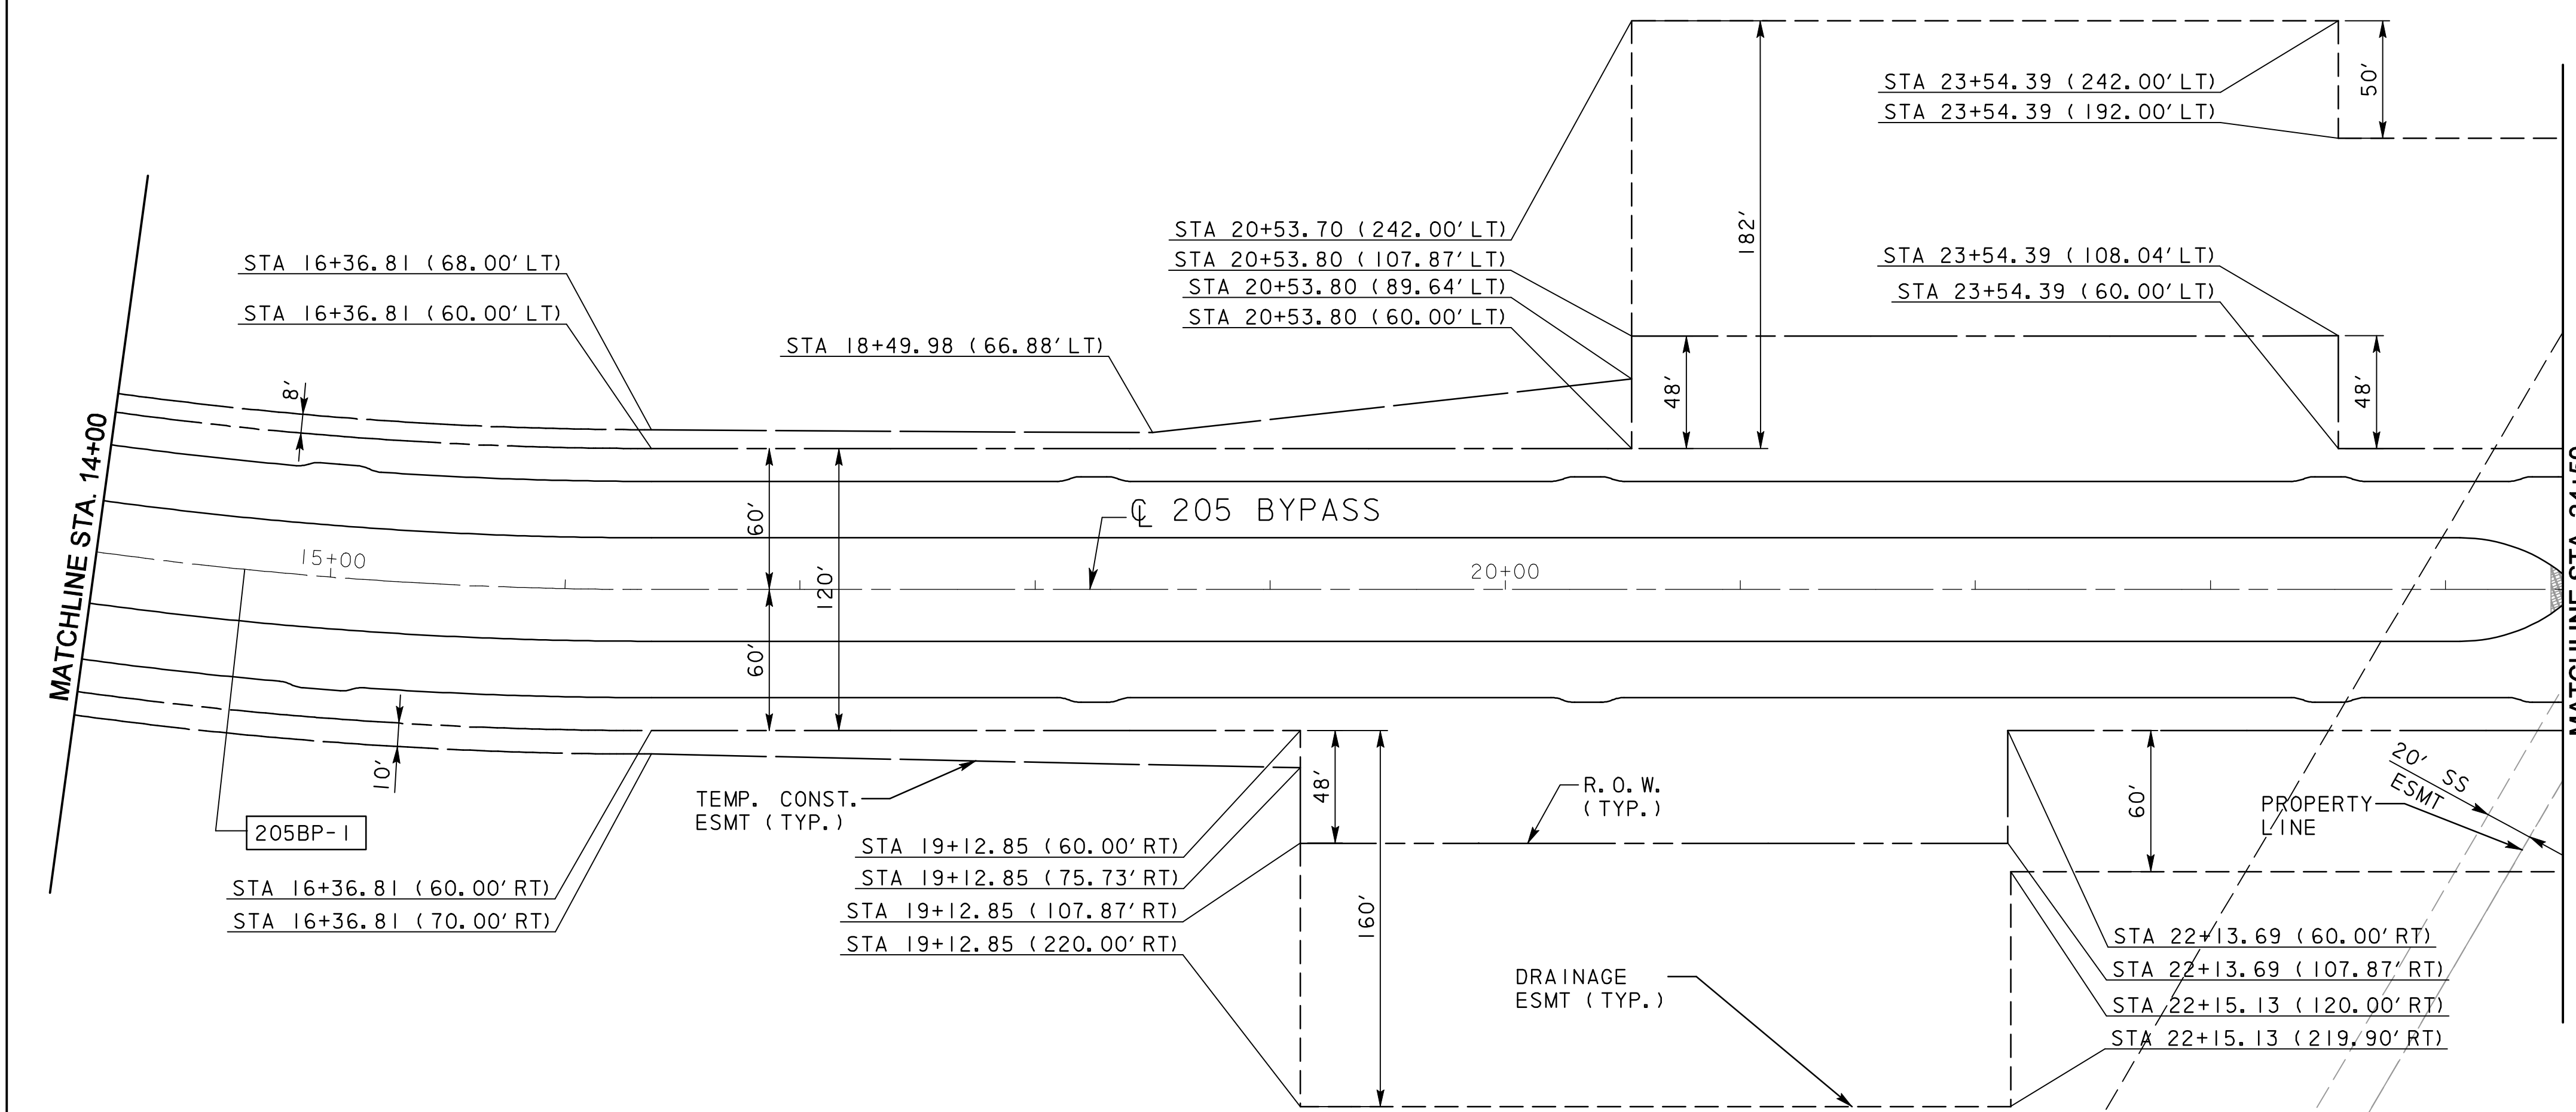

LEGEND

- 205BP-1 CURVE NUMBER
- PROPOSED ROW
- - - DRAINAGE EASEMENT
- - - TEMP SLOPE EASEMENT

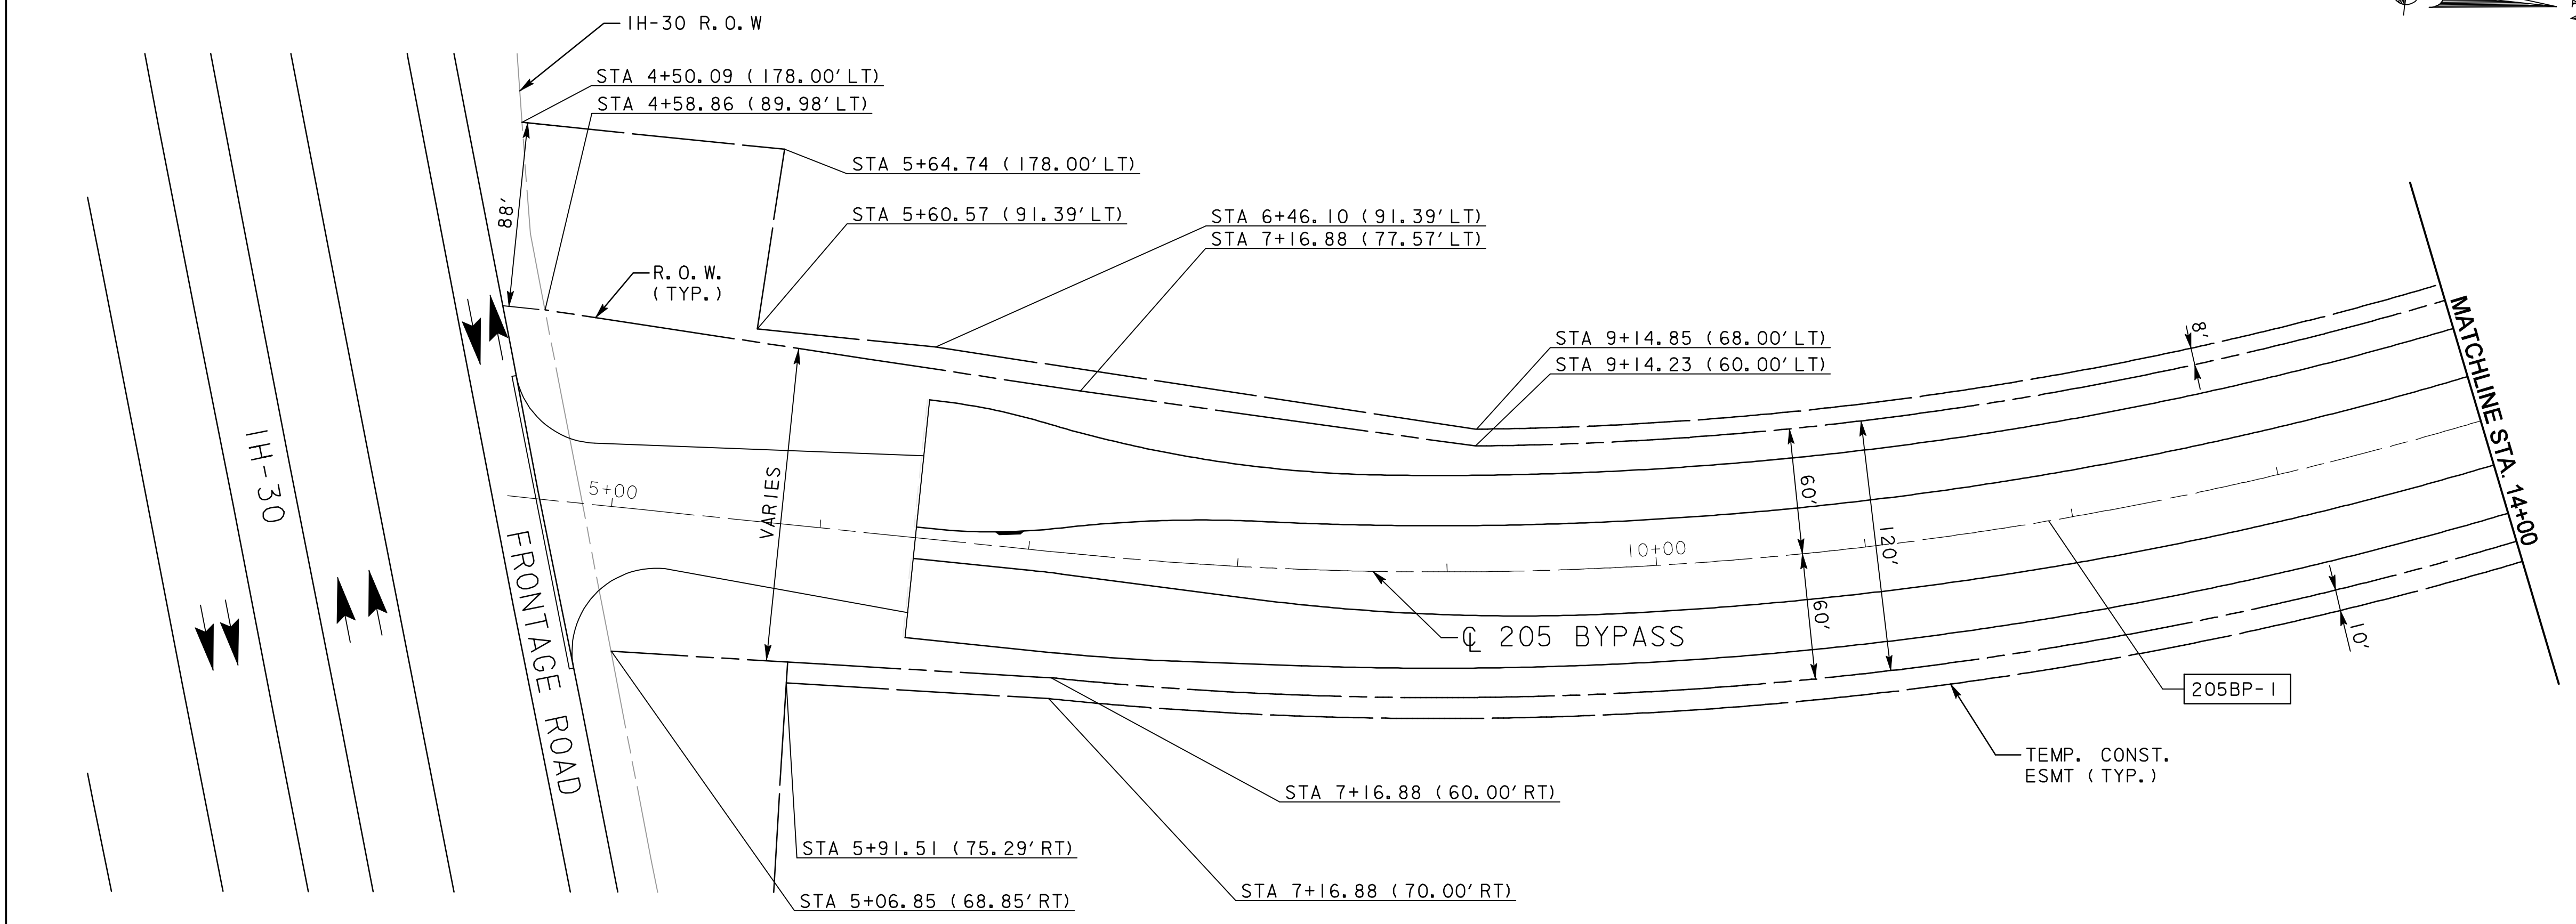

RECORD DRAWING

This drawing is a compilation of the original sealed engineering drawing and modifications by addenda, change orders and information furnished by the contractor. Information shown that was provided by the contractor and others not associated with the design engineer cannot be verified for accuracy or completeness. Original sealed drawing is on file at the office of AECOM USA Group, Inc., TBPE REG. NO. F-3082

ORIGINAL DRAWING SEALED & SIGNED BY
T.H. Gaertner, P.E.
TX NO. 37124

RECORD DRAWING				THG	10/23/09
REVISION				BY	DATE
City of Rockwall, Texas					
205 BYPASS PHASE 3					
HORIZONTAL CONTROL LAYOUT STA. 4+50 TO STA. 24+50					
TCB AECOM				<small>TCB INC. WWW.TCB.AECOM.COM 17300 DALLAS PARKWAY, SUITE 1010 DALLAS, TEXAS 75248</small>	
Unit	PW-DAL-FW	Scale	Horz: AS SHOWN Vert: AS SHOWN	Date	11/23/2009
Designed	THG	Checked	TCB	Project No.	60004153
Drawn	FG	Approved	TCB	Sheet	29 of 215

\\usdell1\p001\pww4328\60004153-205bypass\cadd\sheet\phase 3 - 1 30 to start\on sh 66\record drawing 10_7_09_029hr\1z\layout-01.dgn
 11/23/2009