



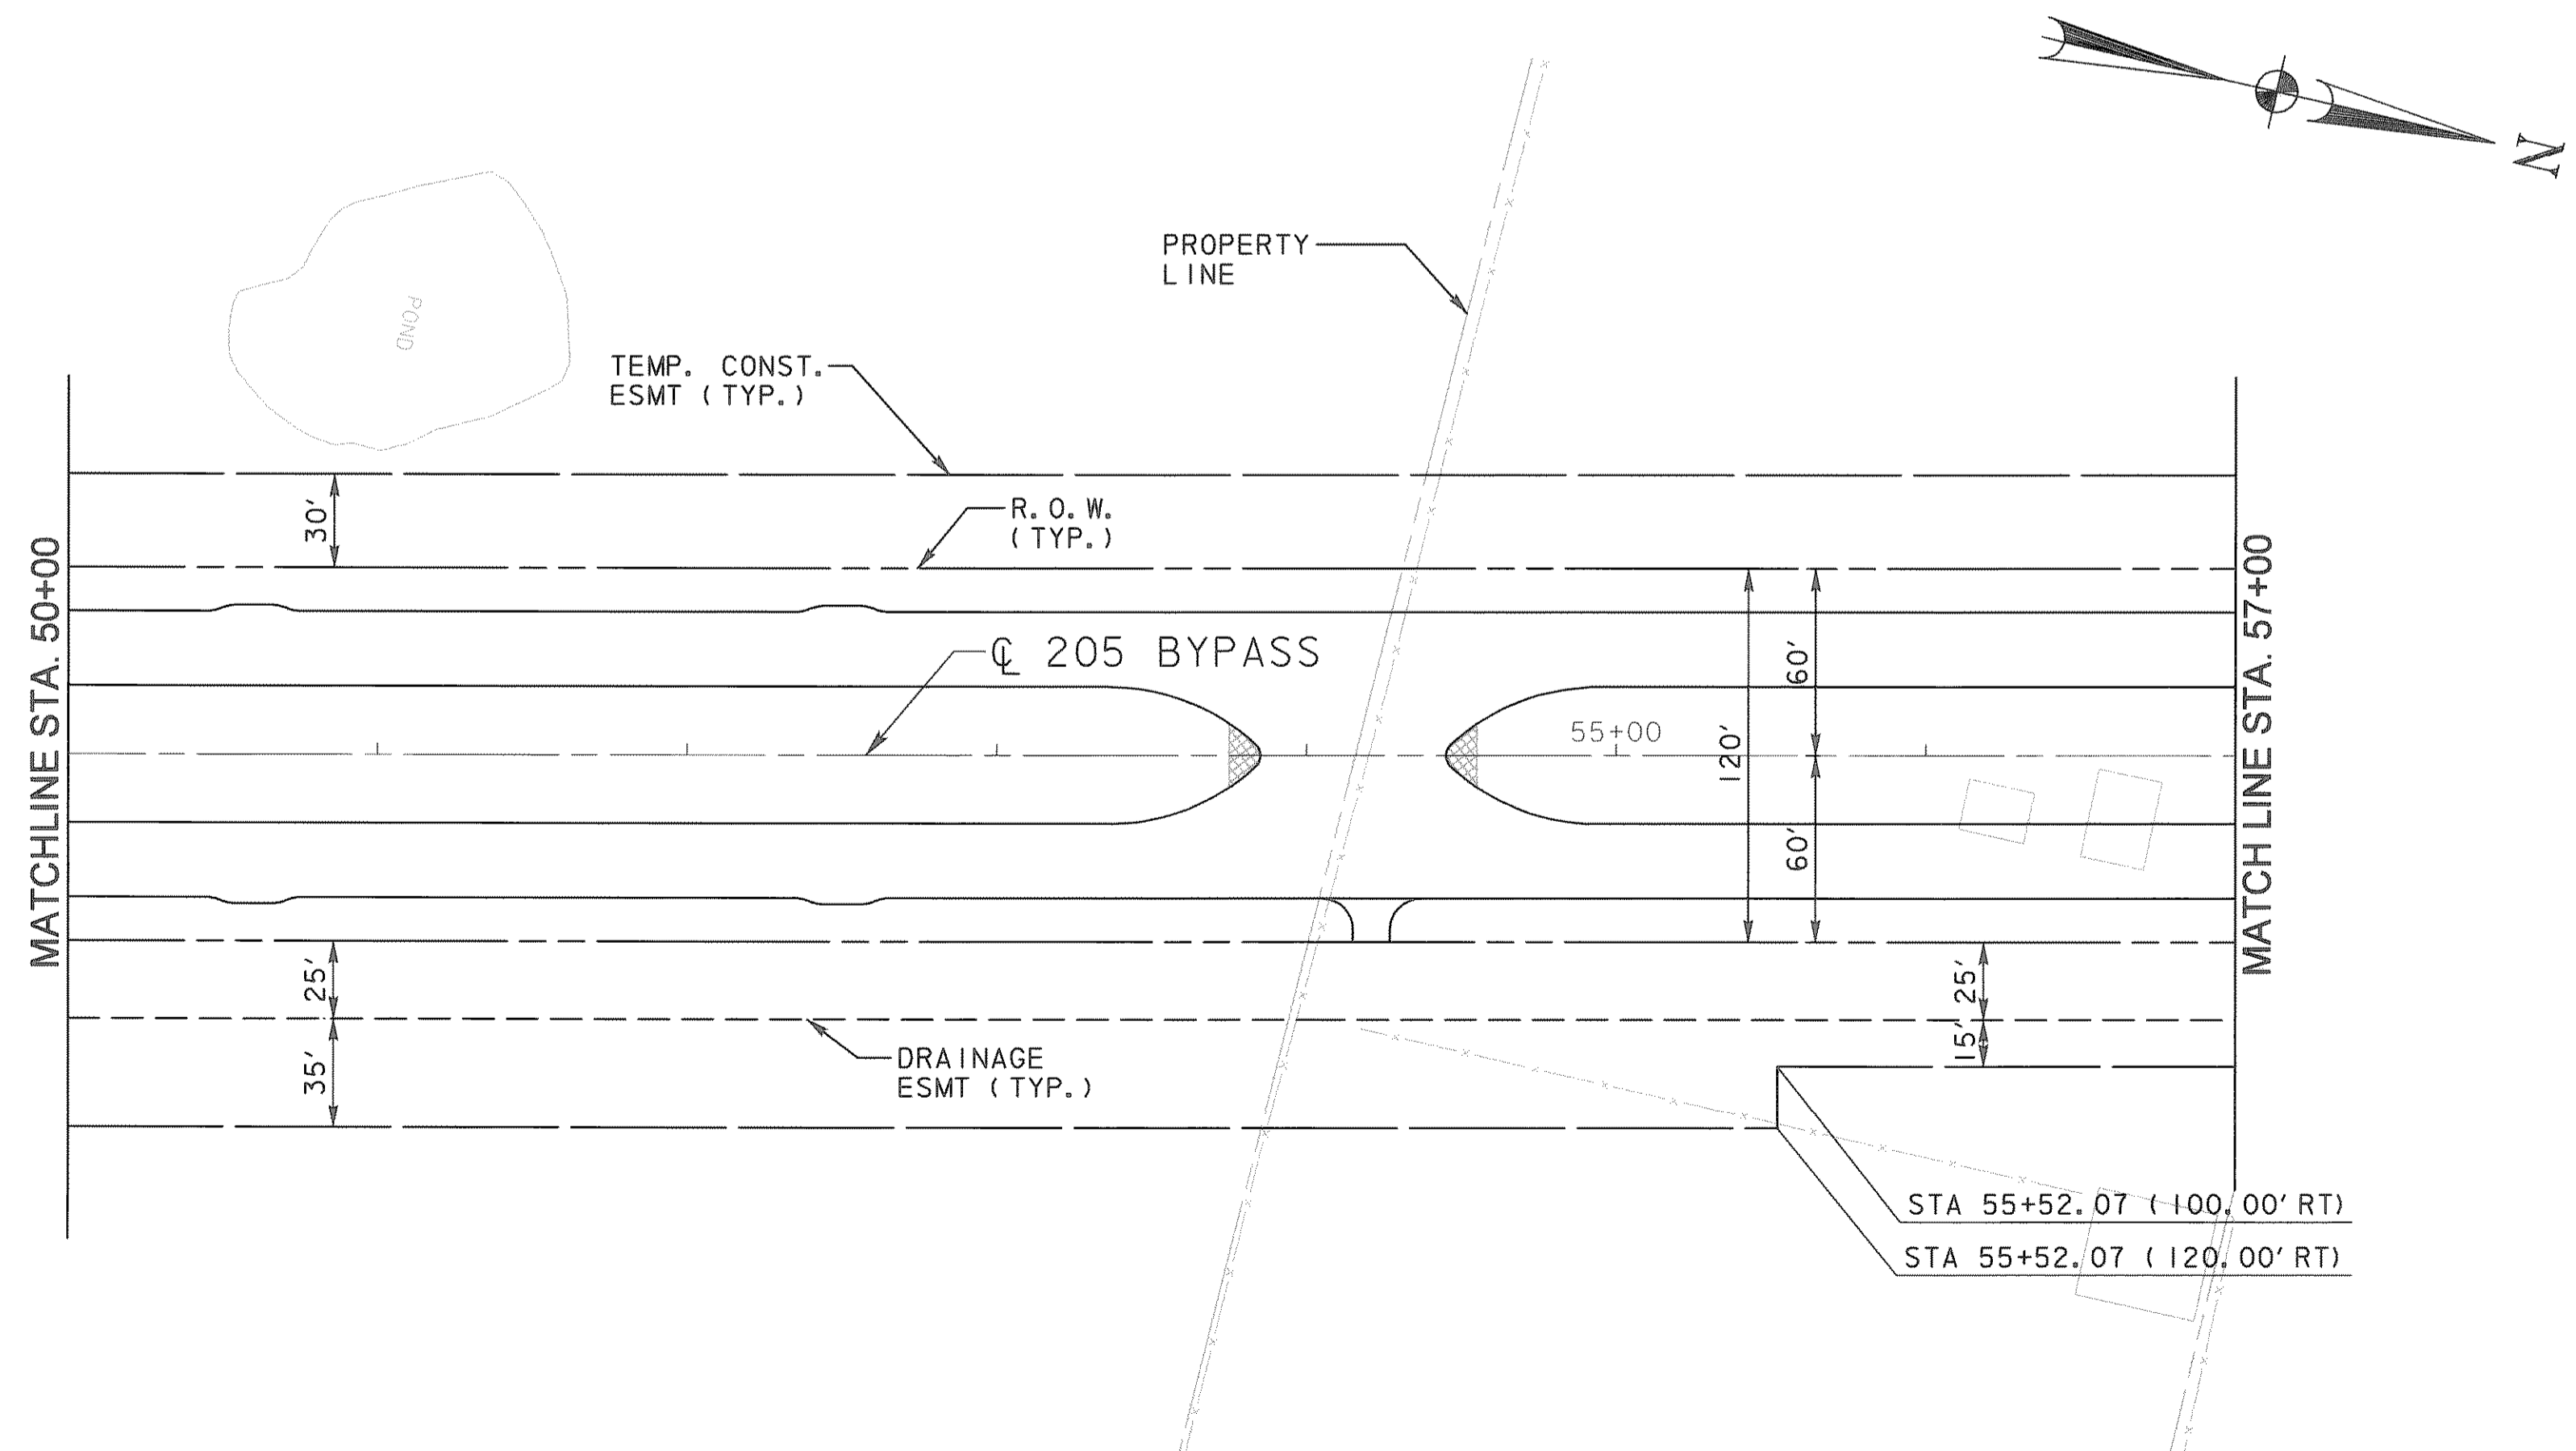

LEGEND

- 205BP-1 CURVE NUMBER
- PROPOSED ROW
- DRAINAGE EASEMENT
- TEMP SLOPE EASEMENT

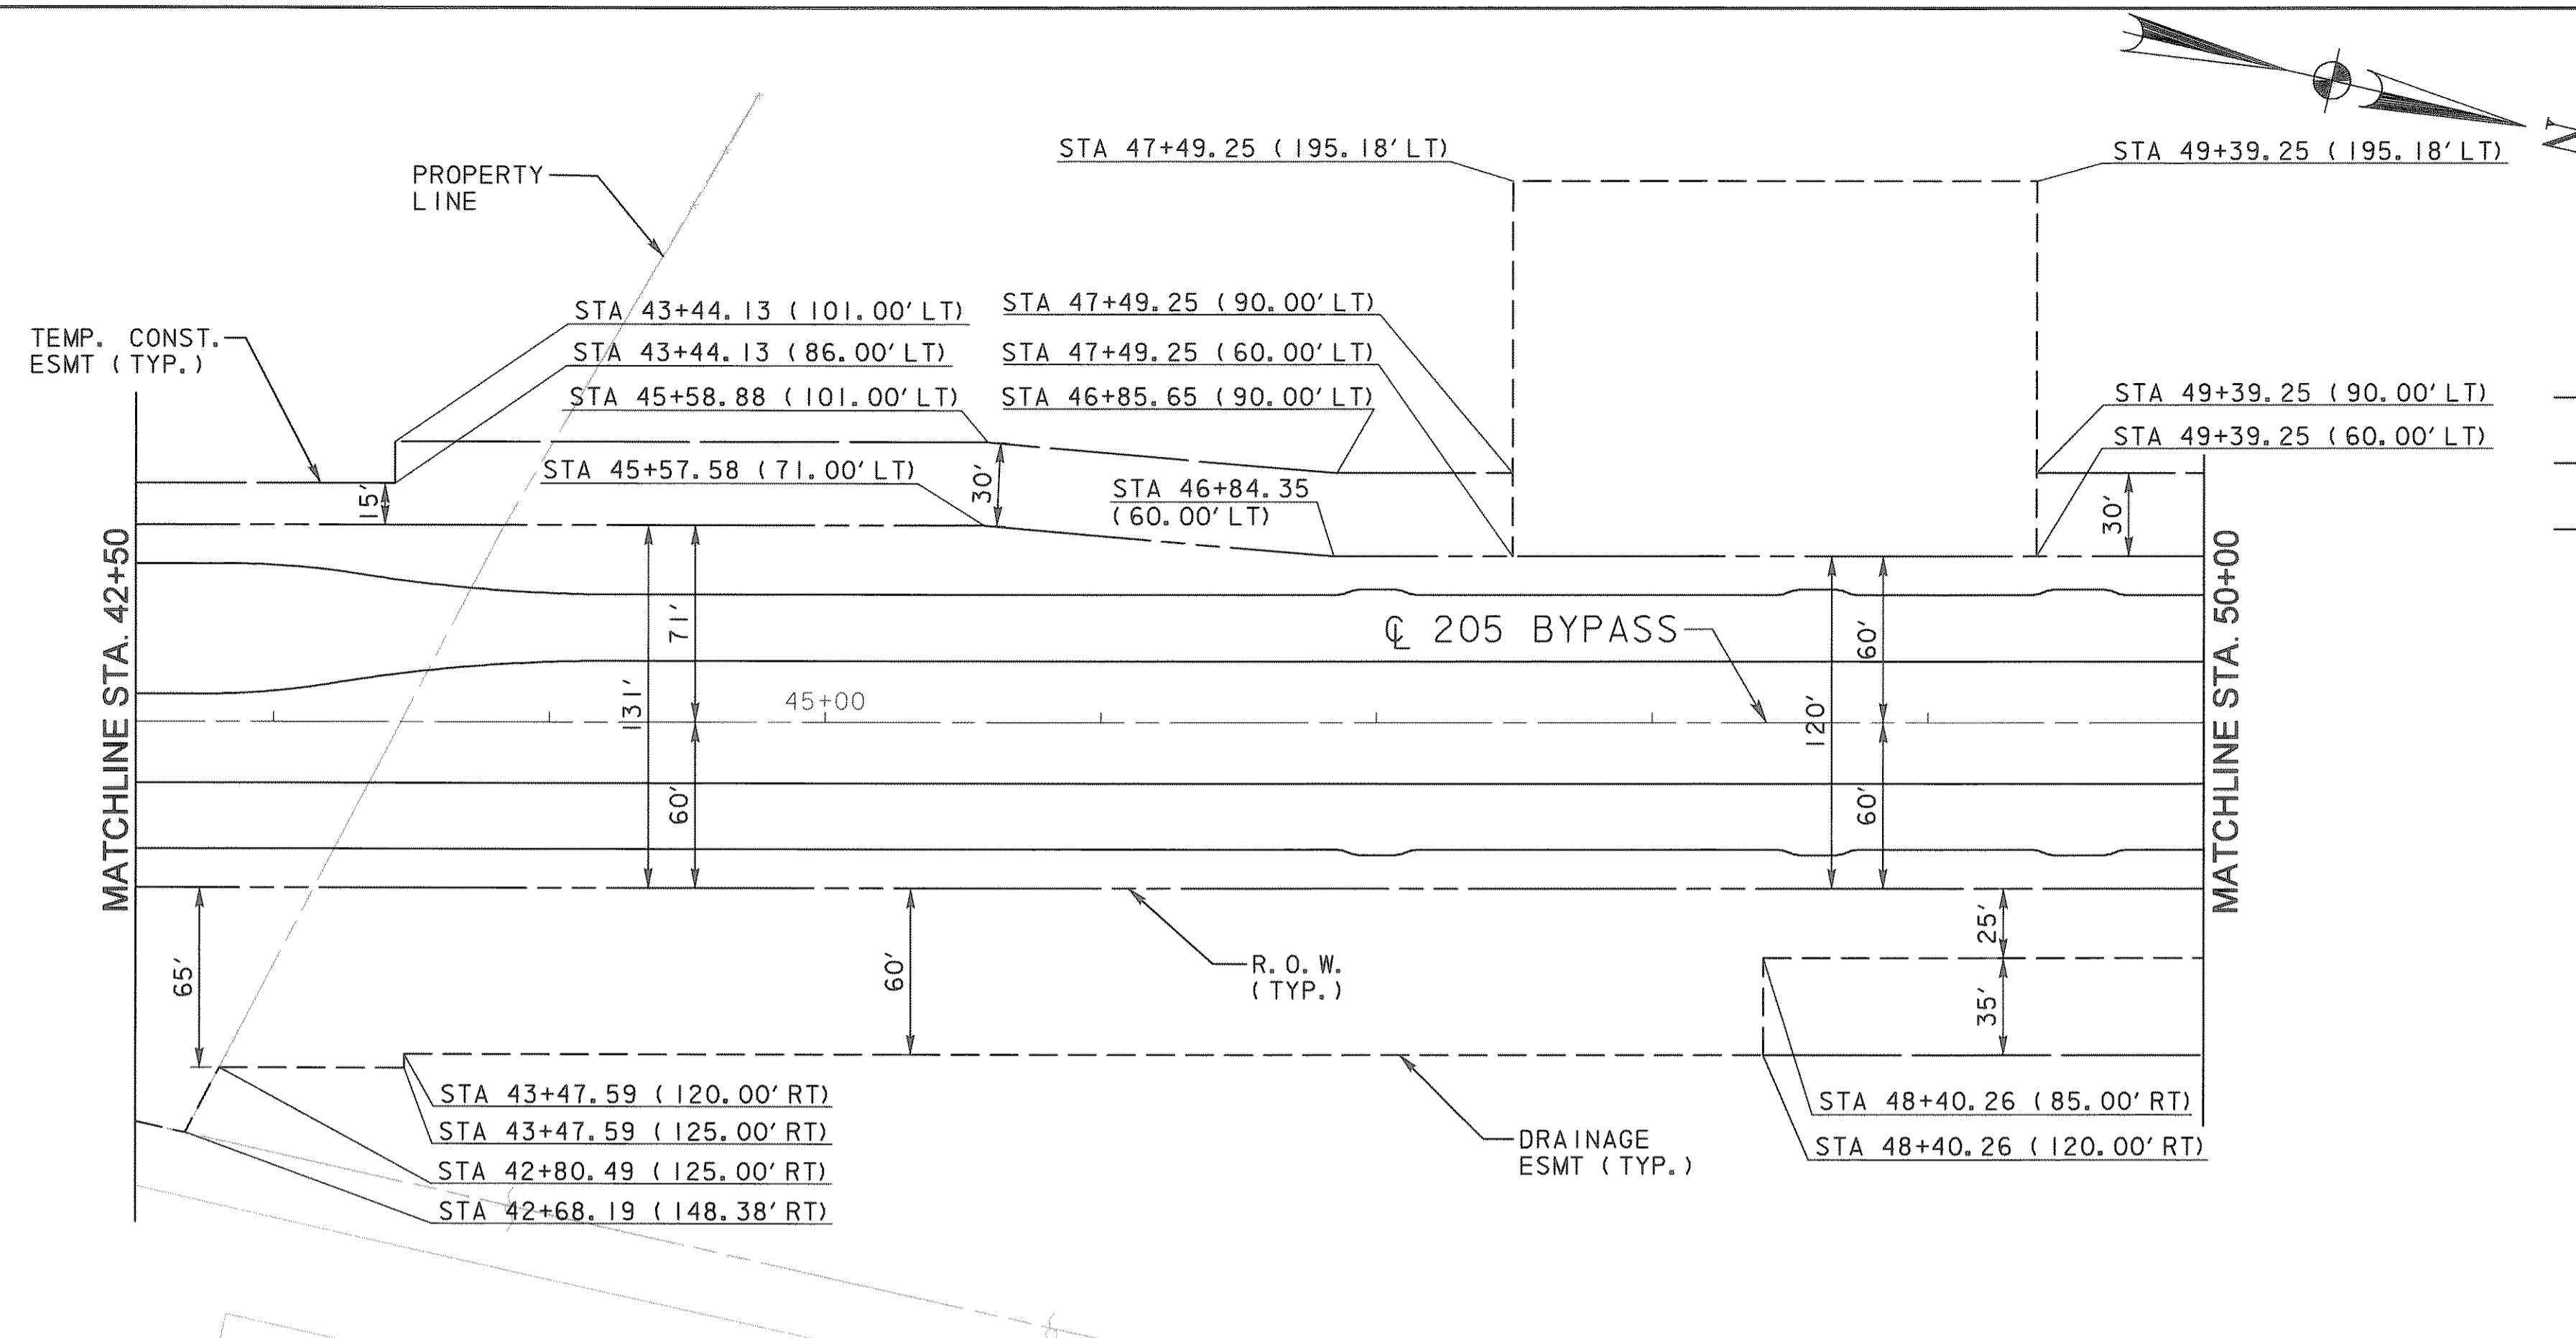

RECORD DRAWING
 This drawing is a compilation of the original sealed engineering drawing and modifications by addenda, change orders and information furnished by the contractor. Information shown that was provided by the contractor and others not associated with the design engineer cannot be verified for accuracy or completeness. Original sealed drawing is on file at the office of AECOM USA Group, Inc., TBPE REG. NO. F-3082

ORIGINAL DRAWING SEALED & SIGNED BY
 T.H. Gaertner, P.E.
 TX NO. 37124

NO.	REVISION	BY	DATE

City of Rockwall, Texas

205 BYPASS PHASE 3

**HORIZONTAL CONTROL LAYOUT
 STA. 42+50 TO STA. 57+00**

TCB | AECOM TCB INC. WWW.TCB.AECOM.COM 17300 DALLAS PARKWAY, SUITE 1010 DALLAS, TEXAS 75248

Unit: PW-DAL-FW	Scale: Horiz: AS SHOWN Vert: AS SHOWN	Date: 11/16/2009
Designed: THG	Checked: TCB	Project No. 60004153
Drawn: FG	Approved: TCB	Sheet 31 of 215

\\usdall1\p001\p001\4328\60004\53-205Bypass\CADD\Sheets\Phase 3 - 1 30 to 57\Station SH 66\Record Drawing 10_7_09\03 Hor\ZLayout-03.dgn
 11/16/2009