


LEGEND

- RIGHT OF WAY
- - - TEMPORARY SLOPE EASEMENT
- - - DRAINAGE EASEMENT
- CONCRETE PAVEMENT

\\sddal1\p001\PM\1328\60004153-205Bypass\CADD\Sheets\Phase 3 - 1 30 to Station SH 66\Record Drawing 10_7_05\04 IPPSheet-08.dgn
 11/16/2009

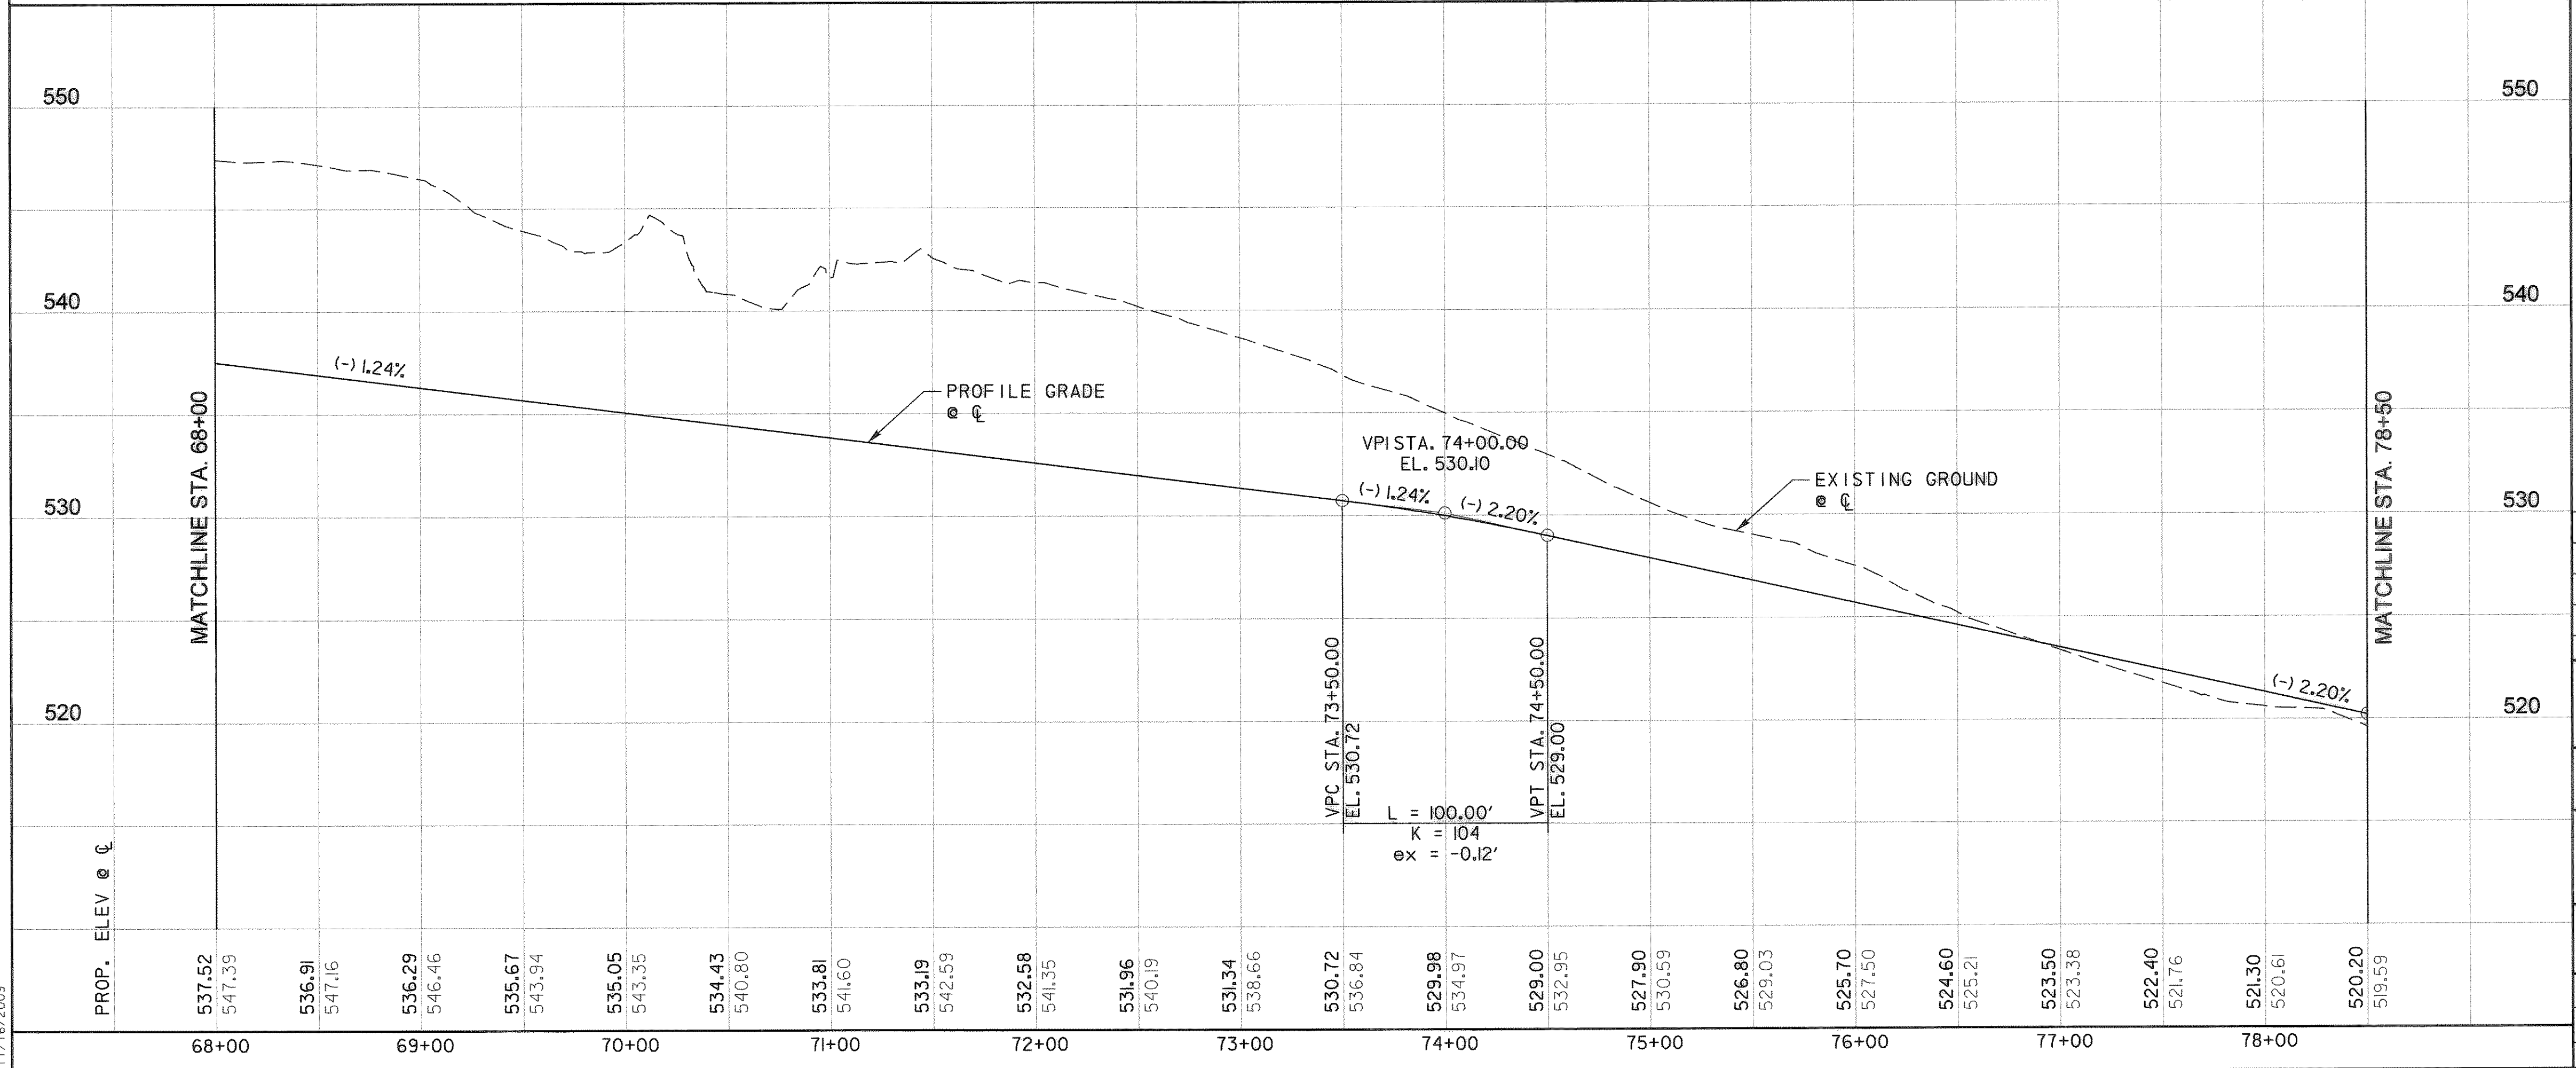

RECORD DRAWING
 This drawing is a compilation of the original sealed engineering drawing and modifications by addenda, change orders and information furnished by the contractor. Information shown that was provided by the contractor and others not associated with the design engineer cannot be verified for accuracy or completeness. Original sealed drawing is on file at the office of AECOM USA Group, Inc., TBPE REG. NO. F-3082.

ORIGINAL DRAWING
 SEALED & SIGNED BY
 T.H. Gaertner, P.E.
 TX NO. 37124

NO.	REVISION	BY	DATE
I	FENCE ADDED	THG	05/20/08



City of Rockwall, Texas

**205 BYPASS
 PHASE 3**

**PLAN & PROFILE
 STA. 68+00 TO STA. 78+50**

Unit	PW-DAL-FW	Scale	Horz: AS SHOWN Vert: AS SHOWN	Date	11/16/2009
Designed	THG	Checked	TCB	Project No.	60004153
Drawn	FG	Approved	TCB	Sheet	41 of 215