

LEGEND

- RIGHT OF WAY
- - - - - TEMPORARY SLOPE EASEMENT
- - - - - DRAINAGE EASEMENT
- ▒ 10' CONCRETE PAVEMENT
- ▒ HMAC PAVEMENT
- ▒ 9' CONCRETE PAVEMENT
- CURB INLET TYPE C
- ◻ DROP INLET TYPE H

RECORD DRAWING

This drawing is a compilation of the original sealed engineering drawing and modifications by addenda, change orders and information furnished by the contractor. Information shown that was provided by the contractor and others not associated with the design engineer cannot be verified for accuracy or completeness. Original sealed drawing is on file at the office of AECOM USA Group, Inc., TBPE REG. NO. F-3082

ORIGINAL DRAWING SEALED & SIGNED BY

T.H. Gaertner, P.E.
TX NO. 37124

NO.	REVISION	BY	DATE
1	AIRPORT ROAD INTERSECTION REVISION	THG	05/20/08




City of Rockwall, Texas

**205 BYPASS
PHASE 3**

**INTERSECTION LAYOUT
205 BYPASS @ AIRPORT ROAD**

TCB | AECOM TCB INC. WWW.TCB.AECOM.COM
17300 DALLAS PARKWAY, SUITE 1010
DALLAS, TEXAS 75246

Unit	PW-DAL-FW	Scale	Horz: AS SHOWN Vert: AS SHOWN	Date	11/16/2009
Designed	THG	Checked	TCB	Project No.	60004153
Drawn	FG	Approved	TCB	Sheet	46 of 215

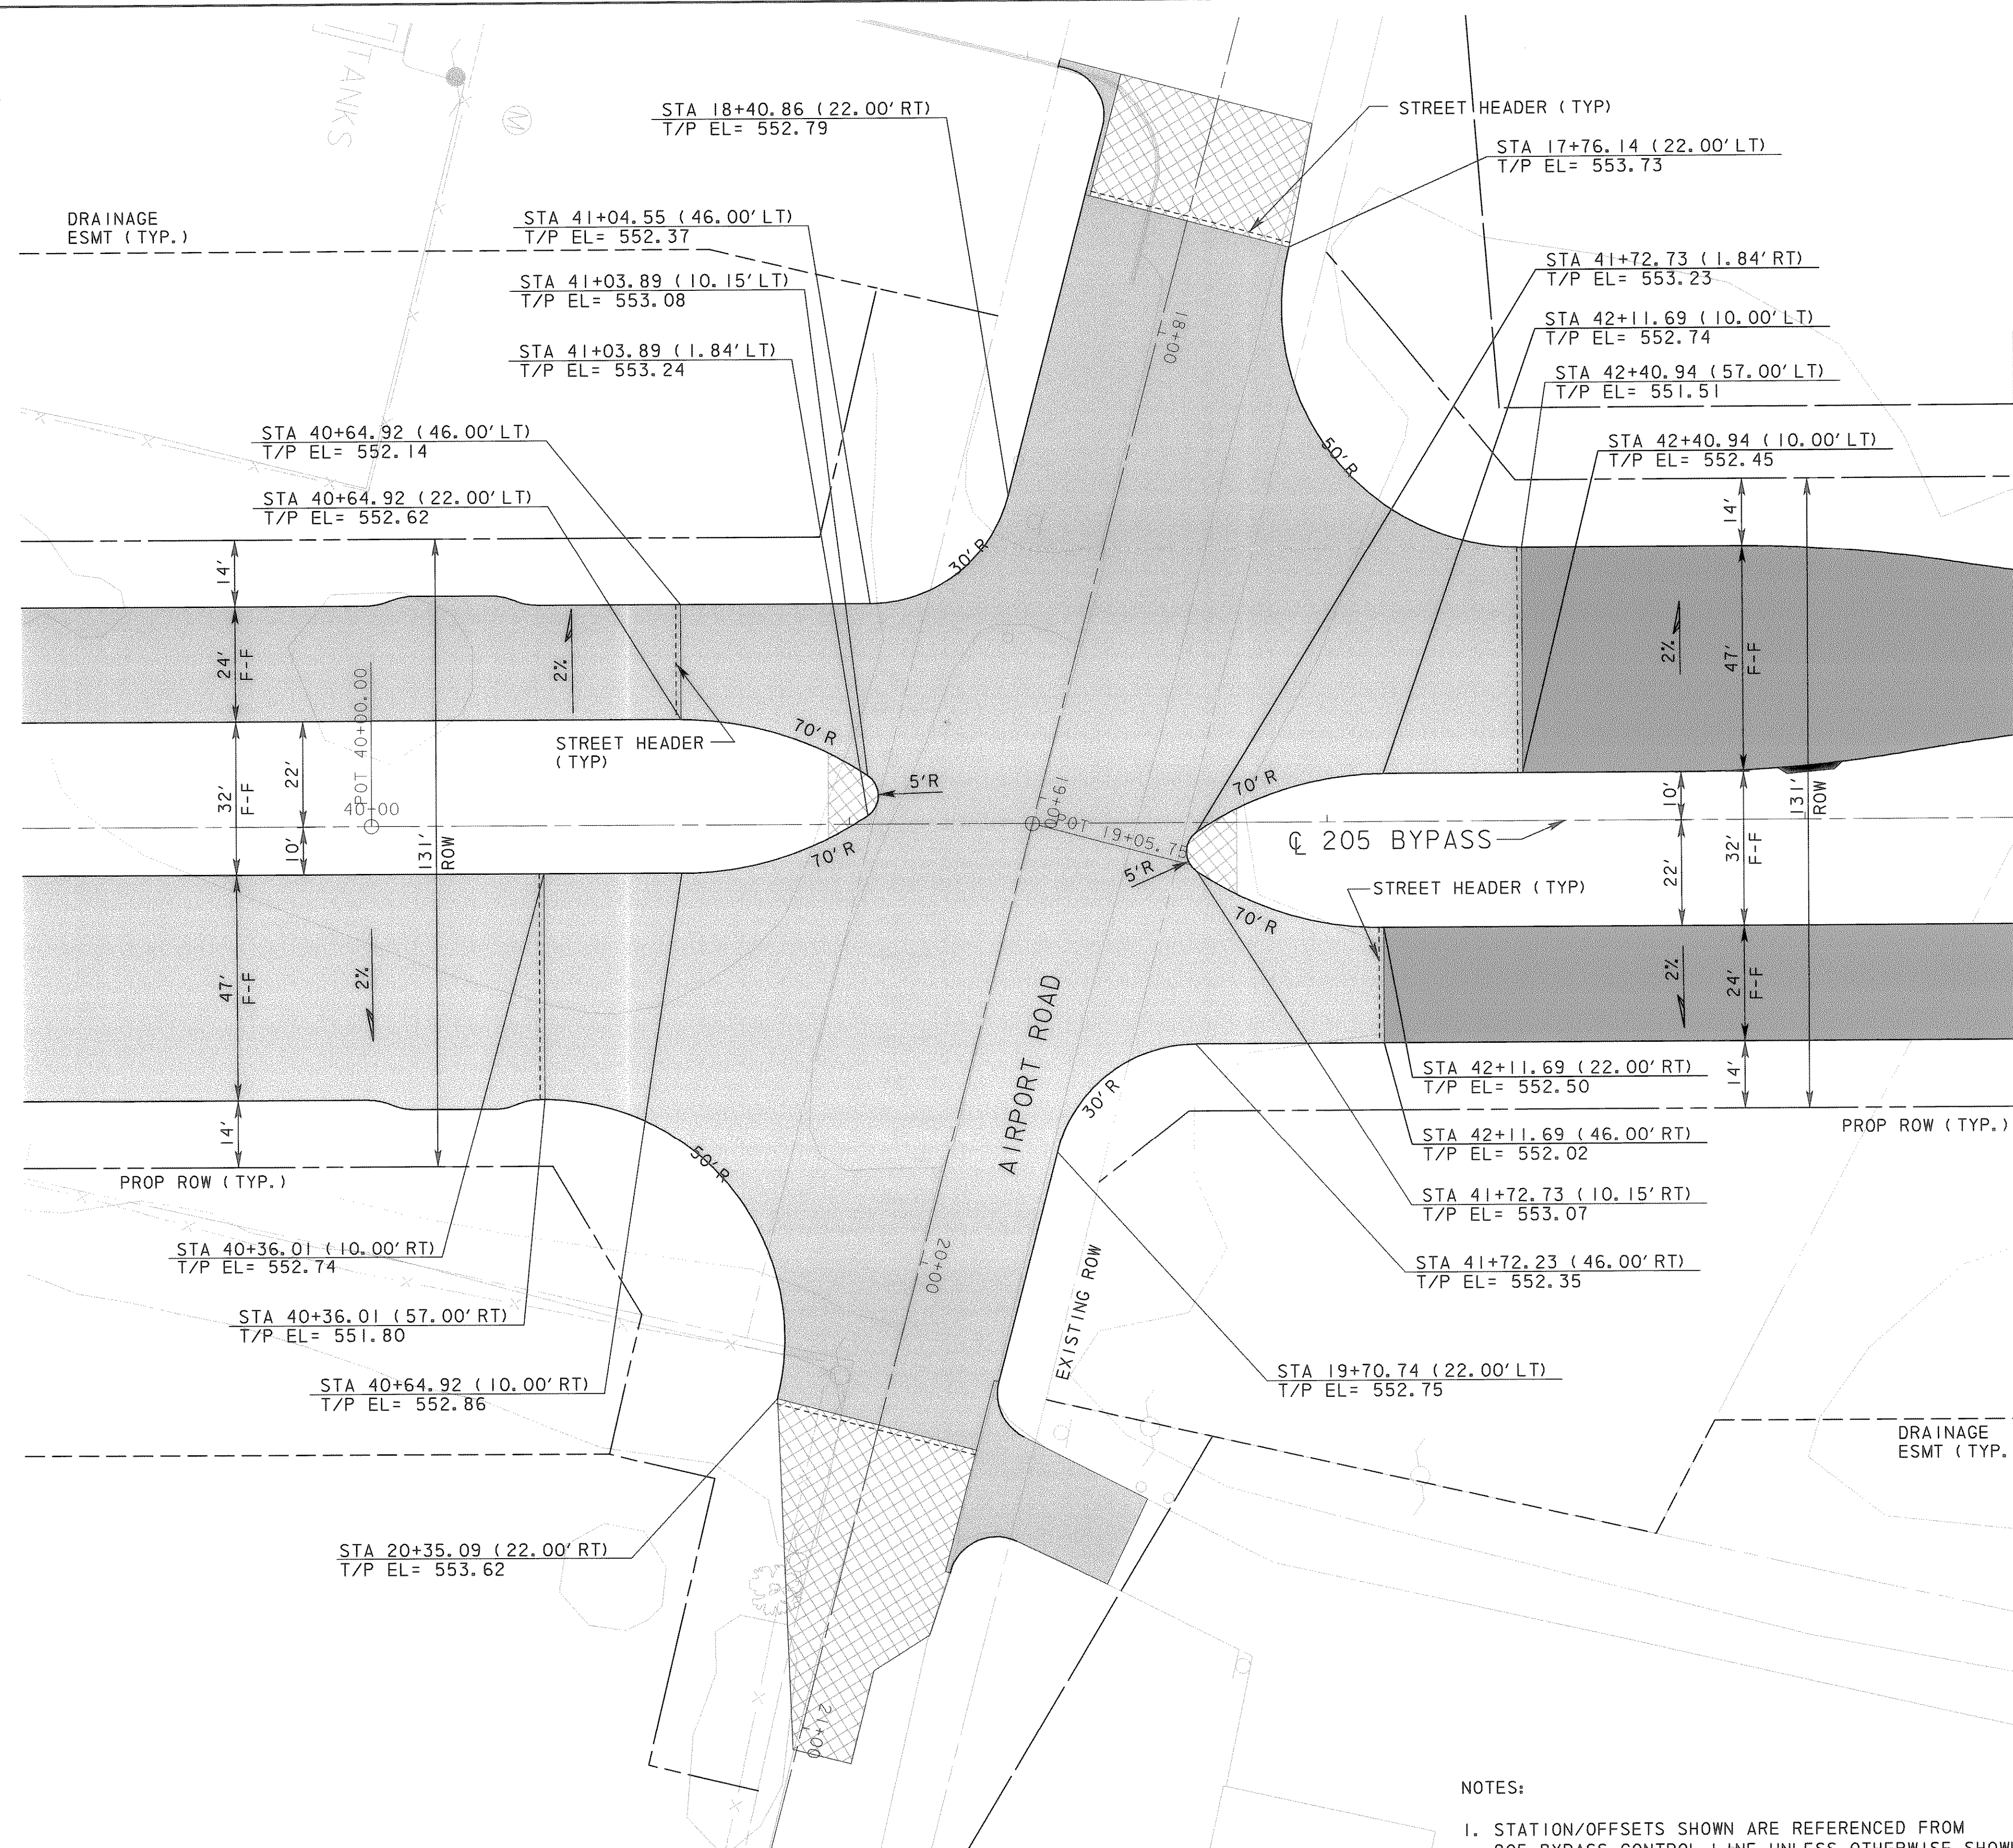

NOTES:

1. STATION/OFFSETS SHOWN ARE REFERENCED FROM 205 BYPASS CONTROL LINE UNLESS OTHERWISE SHOWN.
2. REFER TO AIRPORT ROAD PLAN/PROFILES FOR ADDITIONAL INFORMATION.

\\uedal1\p001\pww\4326\60004153-205Bypass\CADD\Sheets\Phase 3 - 1.30 to Station Sh 66\Record Drawing 10.7.09\046IntersectLay-Airport Rd-01.dgn
 11/16/2009