



DITCH RST1			
205BP STATION	CL OFFSET	DITCH CL EL.	SLOPE
21+50	106.3	553.0	-
22+00	103.2	553.5	1.0%
22+50	100.2	554.0	1.0%
23+00	97.1	554.5	1.0%
23+50	94.1	555.0	1.0%
24+00	91.0	555.5	1.0%
24+50	88.6	556.0	1.0%
25+00	87.4	556.5	1.0%
25+50	86.8	557.0	1.0%
26+00	86.3	557.5	1.0%
26+50	85.7	558.0	1.0%
27+00	85.1	558.5	1.0%
27+50	84.5	559.0	1.0%
28+00	83.9	559.5	1.0%
28+50	83.3	560.0	1.0%
29+00	82.7	560.5	1.0%
29+50	82.1	560.8	0.6%
30+00	83.1	561.1	0.6%
30+50	83.3	561.4	0.6%
31+00	83.5	561.7	0.6%
31+50	83.7	562.0	0.6%
32+00	83.9	562.3	0.6%
32+50	83.7	562.6	0.6%

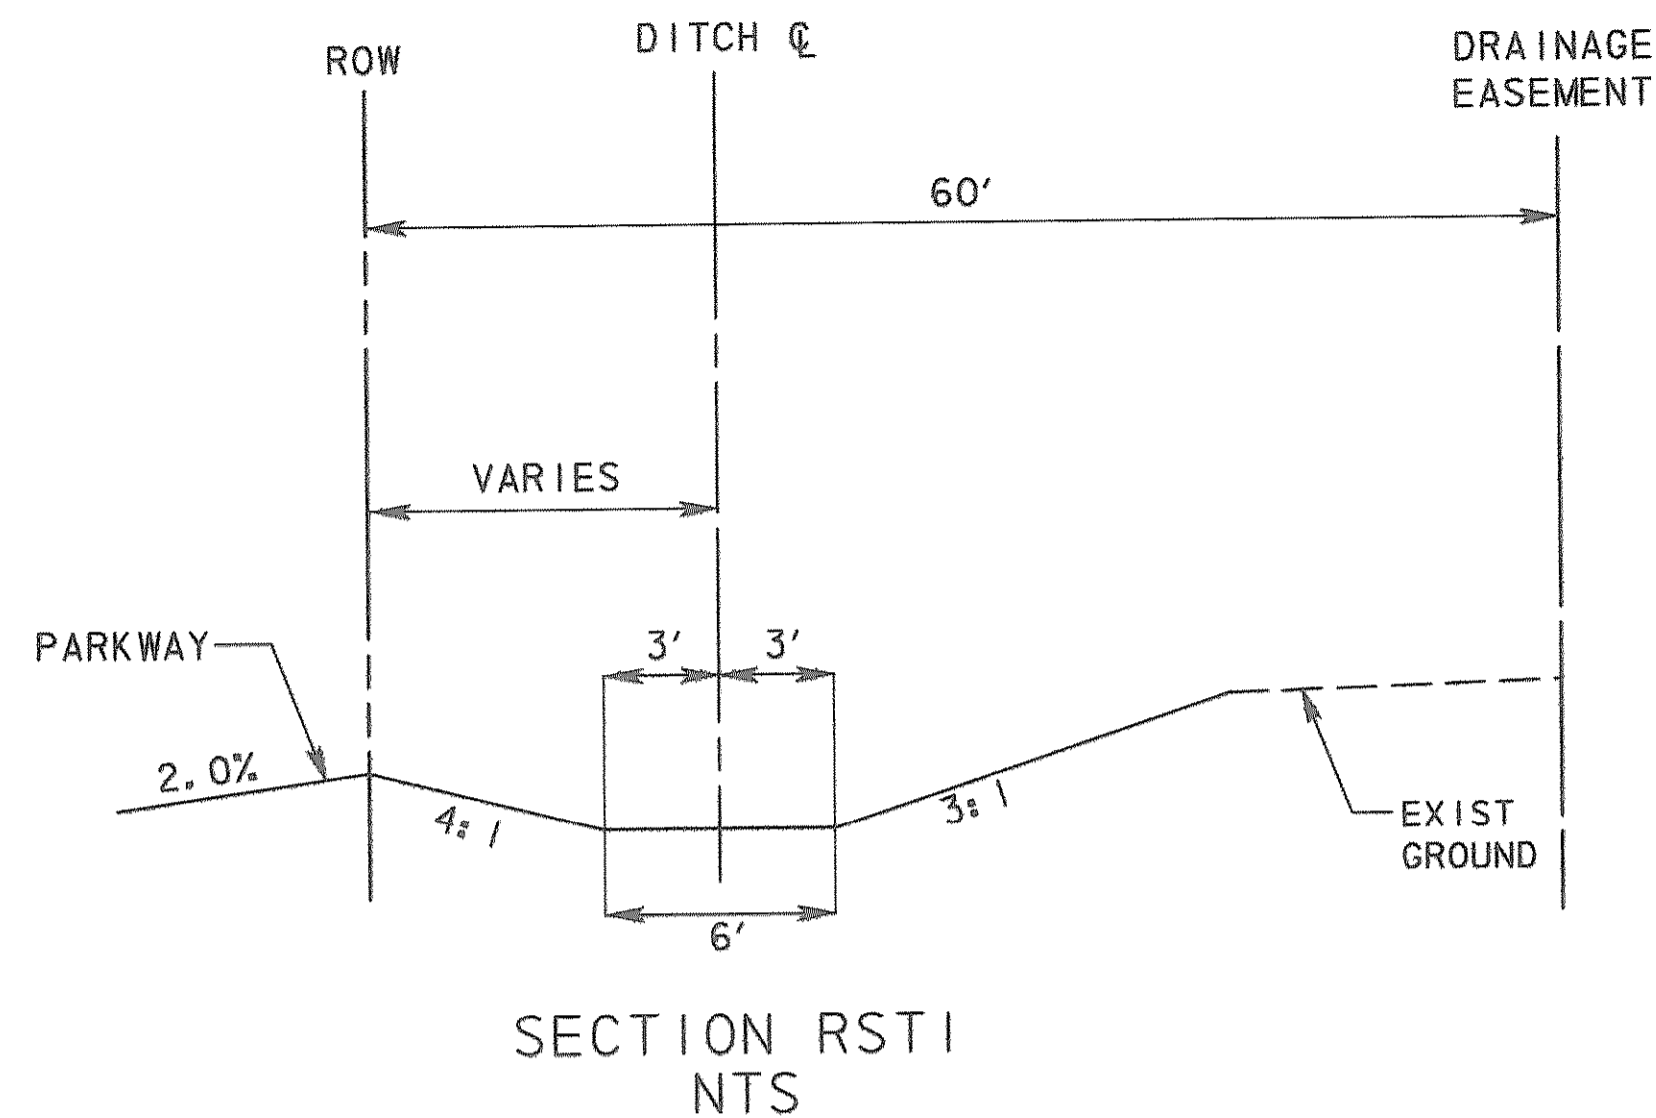

DITCH RST1- OPEN CHANNEL HYDRAULIC CALCULATIONS							
100 YR FLOW MAX *	n	SLOPE MIN	DESIGN FLOW DEPTH	VELOCITY	CHANNEL DEPTH	MIN FREE BOARD	WS TOP WIDTH
46.12	0.035	1.00%	1.23	3.64	2.50	1.27	14.61

* SEE HYDRAULIC DATA SHEETS FOR CALCULATION OF 100 YR FLOWS.

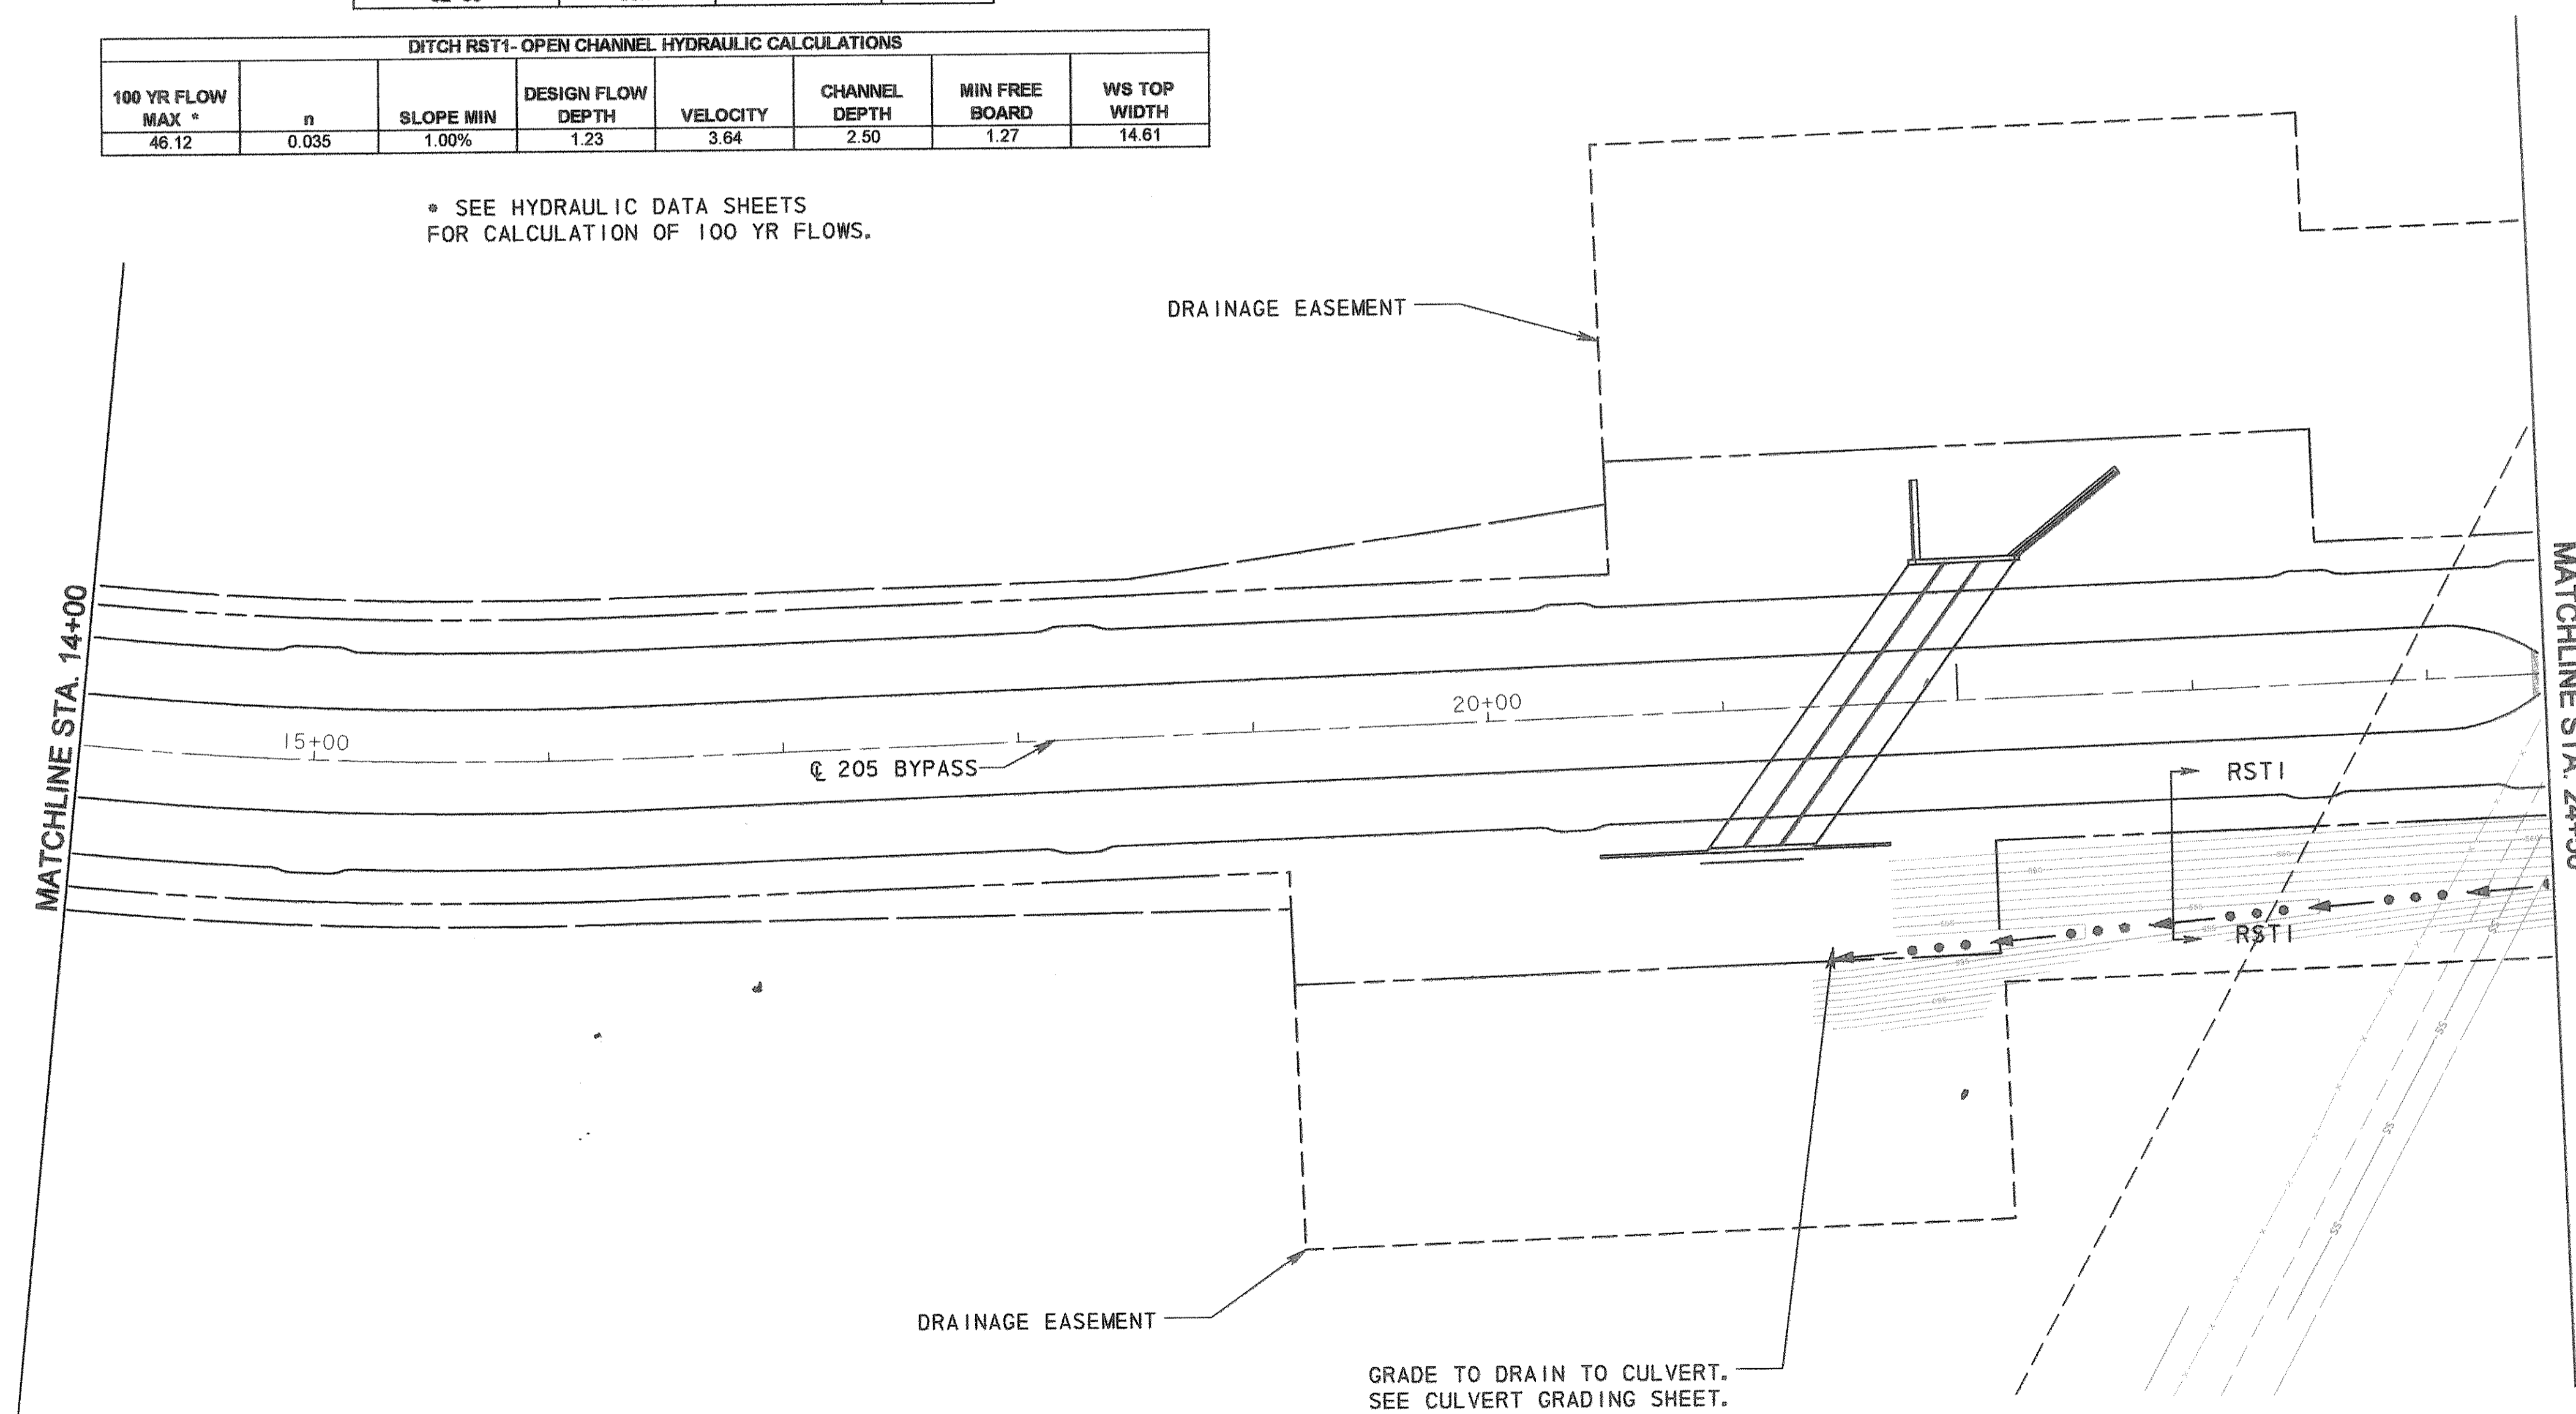

- PROPOSED ROW
- PROPOSED DITCH LINE
- - - - - TEMP SLOPE EASEMENT
- - - - - DRAINAGE EASEMENT

NOTES:

1. USE IMPORTED TOP SOIL WITHIN THE ROW AND ON EARTHEN CHANNEL SLOPES. USE TOP SOIL FROM THE PROJECT SITE FOR ALL OTHER AREAS OUTSIDE OF ROW. THE IMPORTED TOP SOIL SHALL MEET THE REQUIREMENTS OF C.O.G. SPEC 3.8.1 AND BE A CLAY SILT OR SILTY CLAY TYPE SOIL MEETING THE APPROVAL OF THE CITY FOR USE ON THIS PROJECT.

RECORD DRAWING
 This drawing is a compilation of the original sealed engineering drawing and modifications by addenda, change orders and information furnished by the contractor. Information shown that was provided by the contractor and others not associated with the design engineer cannot be verified for accuracy or completeness. Original sealed drawing is on file at the office of AECOM USA Group, Inc., TBPE REG. NO. F-3082

ORIGINAL DRAWING SEALED & SIGNED BY
 T.H. Gaertner, P.E.
 TX NO. 37124

NO.	REVISION	BY	DATE



205 BYPASS PHASE 3

DITCH LAYOUT STA. 14+00 TO STA. 24+50

TCB AECOM
 TCB INC. WWW.TCB.AECOM.COM
 17300 DALLAS PARKWAY, SUITE 1010
 DALLAS, TEXAS 75248

Unit	PW-DAL-FW	Scale	Horz: AS SHOWN Vert: AS SHOWN	Date	11/16/2009
Designed	SDB	Checked	TCB	Project No.	60004153
Drawn	EG	Approved	TCB	Sheet	48 of 215

\\usdell1\p001\pww\4328\60004153-205Bypass\CADD\Sheets\Phase 3 - 1 30 to Station SH 66\Record Drawing 10_7_09\048D1rth P.lan01.dgn
 11/16/2009