


- PROPOSED ROW
- ..... PROPOSED DITCH LINE
- TEMP SLOPE EASEMENT
- DRAINAGE EASEMENT

- NOTES:
- SEE DITCH PLAN SHEET 1 FOR RST1 DITCH STATIONS AND OFFSETS AND HYDRAULIC INFORMATION.
  - USE IMPORTED TOP SOIL WITHIN THE ROW AND ON EARTHEN CHANNEL SLOPES. USE TOP SOIL FROM THE PROJECT SITE FOR ALL OTHER AREAS OUTSIDE OF ROW. THE IMPORTED TOP SOIL SHALL MEET THE REQUIREMENTS OF C.O.G. SPEC 3.8.1 AND BE A CLAY SILT OR SILTY CLAY TYPE SOIL MEETING THE APPROVAL OF THE CITY FOR USE ON THIS PROJECT.

**RECORD DRAWING**  
 This drawing is a compilation of the original sealed engineering drawing and modifications by addenda, change orders and information furnished by the contractor. Information shown that was provided by the contractor and others not associated with the design engineer cannot be verified for accuracy or completeness. Original sealed drawing is on file at the office of AECOM USA Group, Inc., TBPE REG. NO. F-3082.

ORIGINAL DRAWING SEALED & SIGNED BY  
 T.H. Gaertner, P.E.  
 TX NO. 37124

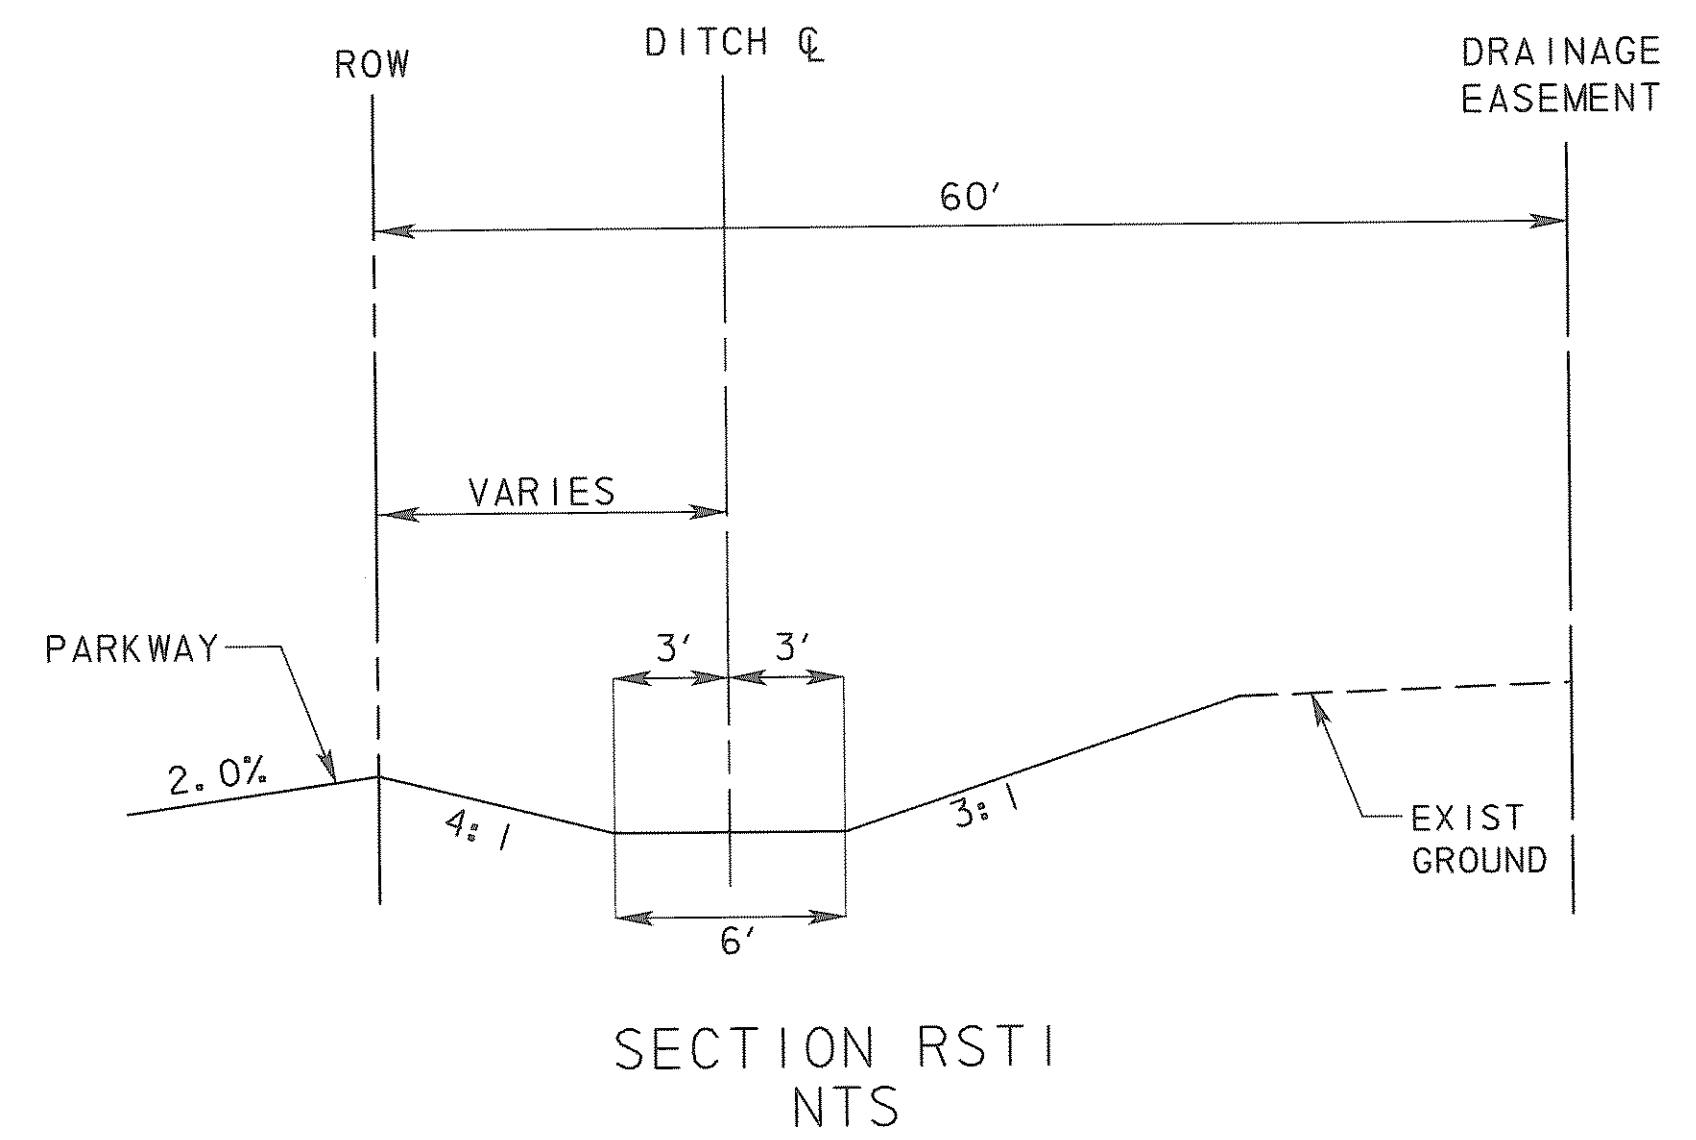

BEGIN DITCH  
 STA 32+50 (83.7' RT)  
 0.6% DITCH SLOPE  
 FL EL. 562.6

\\usdc011\p001\p001\FW-4128\60004153-205Bypass\CADD\Sheets\Phase 3 - 1 30 to Station SH 66\Record Drawing 10\_1\_09\04901tch P 1a02.dgn  
 11/16/2009

NO.				REVISION				BY		DATE	
<b>205 BYPASS</b> <b>PHASE 3</b>											
<b>DITCH LAYOUT</b> <b>STA. 24+50 TO STA. 35+00</b>											
<b>TCB AECOM</b>						<small>TCB INC          WWW.TCB.AECOM.COM          17300 DALLAS PARKWAY, SUITE 1010          DALLAS, TEXAS 75248</small>					
Unit	PW-DAL-FW		Scale	Horz: AS SHOWN Vert: AS SHOWN		Date	11/16/2009				
Designed	SDB		Checked	TCB		Project No.	60004153				
Drawn	FG		Approved	TCB		Sheet	49 of 215				