



50 0 50 100
SCALE IN FEET
HORIZONTAL

LEGEND

- INLET DESIGNATION
AREA (AC)
- INLET DRAINAGE BOUNDARY
- ← SURFACE FLOW DIRECTION

NOTES:

1. SEE HYDRAULIC DATA SHEETS FOR GUTTER FLOW CALCULATIONS.
2. AREA R FLOWS INTO TEMPORARY CULVERT UNDER THE TRANSITION ASPHALT.


RECORD DRAWING

This drawing is a compilation of the original sealed engineering drawing and modifications by addenda, change orders and information furnished by the contractor. Information shown that was provided by the contractor and others not associated with the design engineer cannot be verified for accuracy or completeness. Original sealed drawing is on file at the office of AECOM USA Group, Inc., TBPE REG. NO. F-3082

ORIGINAL DRAWING
SEALED & SIGNED BY

T.H. Gaertner, P.E.
TX NO. 37124

NO.	REVISION	BY	DATE

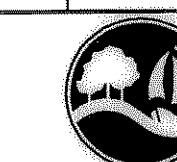

City of Rockwall, Texas

205 BYPASS
PHASE 3

DRAINAGE SYSTEM MAP
STA. 5+00 TO STA. 14+00

TCB | AECOM
TCB INC.
WWW.TCB.AECOM.COM
17300 DALLAS PARKWAY, SUITE 1010
DALLAS, TEXAS 75248

Unit	PW-DAL-FW	Scale	Horz AS SHOWN Vert AS SHOWN	Date	11/16/2009
Designed	SDB	Checked	TCB	Project No.	60004153
Drawn	FG	Approved	TCB	Sheet	58 of 215

\\usda111f0001\PM\4328\60004153-205Bypass\CADD\Sheets\Phase 3 - 1-30 to Station SH 66\Record Drawing 10-7-09\0586Drain_syst-205BPO1.dgn 11/16/2009

