

LEGEND

- B | 9
0.68 INLET DESIGNATION
AREA (AC)
- INLET DRAINAGE BOUNDARY
- ← SURFACE FLOW DIRECTION

NOTES:


1. SEE HYDRAULIC DATA SHEETS FOR GUTTER FLOW CALCULATIONS.
2. DITCHES ARE SIZED FOR EXISTING RUNOFF CONDITIONS.

RECORD DRAWING

This drawing is a compilation of the original sealed engineering drawing and modifications by addenda, change orders and information furnished by the contractor. Information shown that was provided by the contractor and others not associated with the design engineer cannot be verified for accuracy or completeness. Original sealed drawing is on file at the office of AECOM USA Group, Inc., TBPE REG. NO. F-3082

ORIGINAL DRAWING SEALED & SIGNED BY

T.H. Gaertner, P.E.
TX NO. 37124

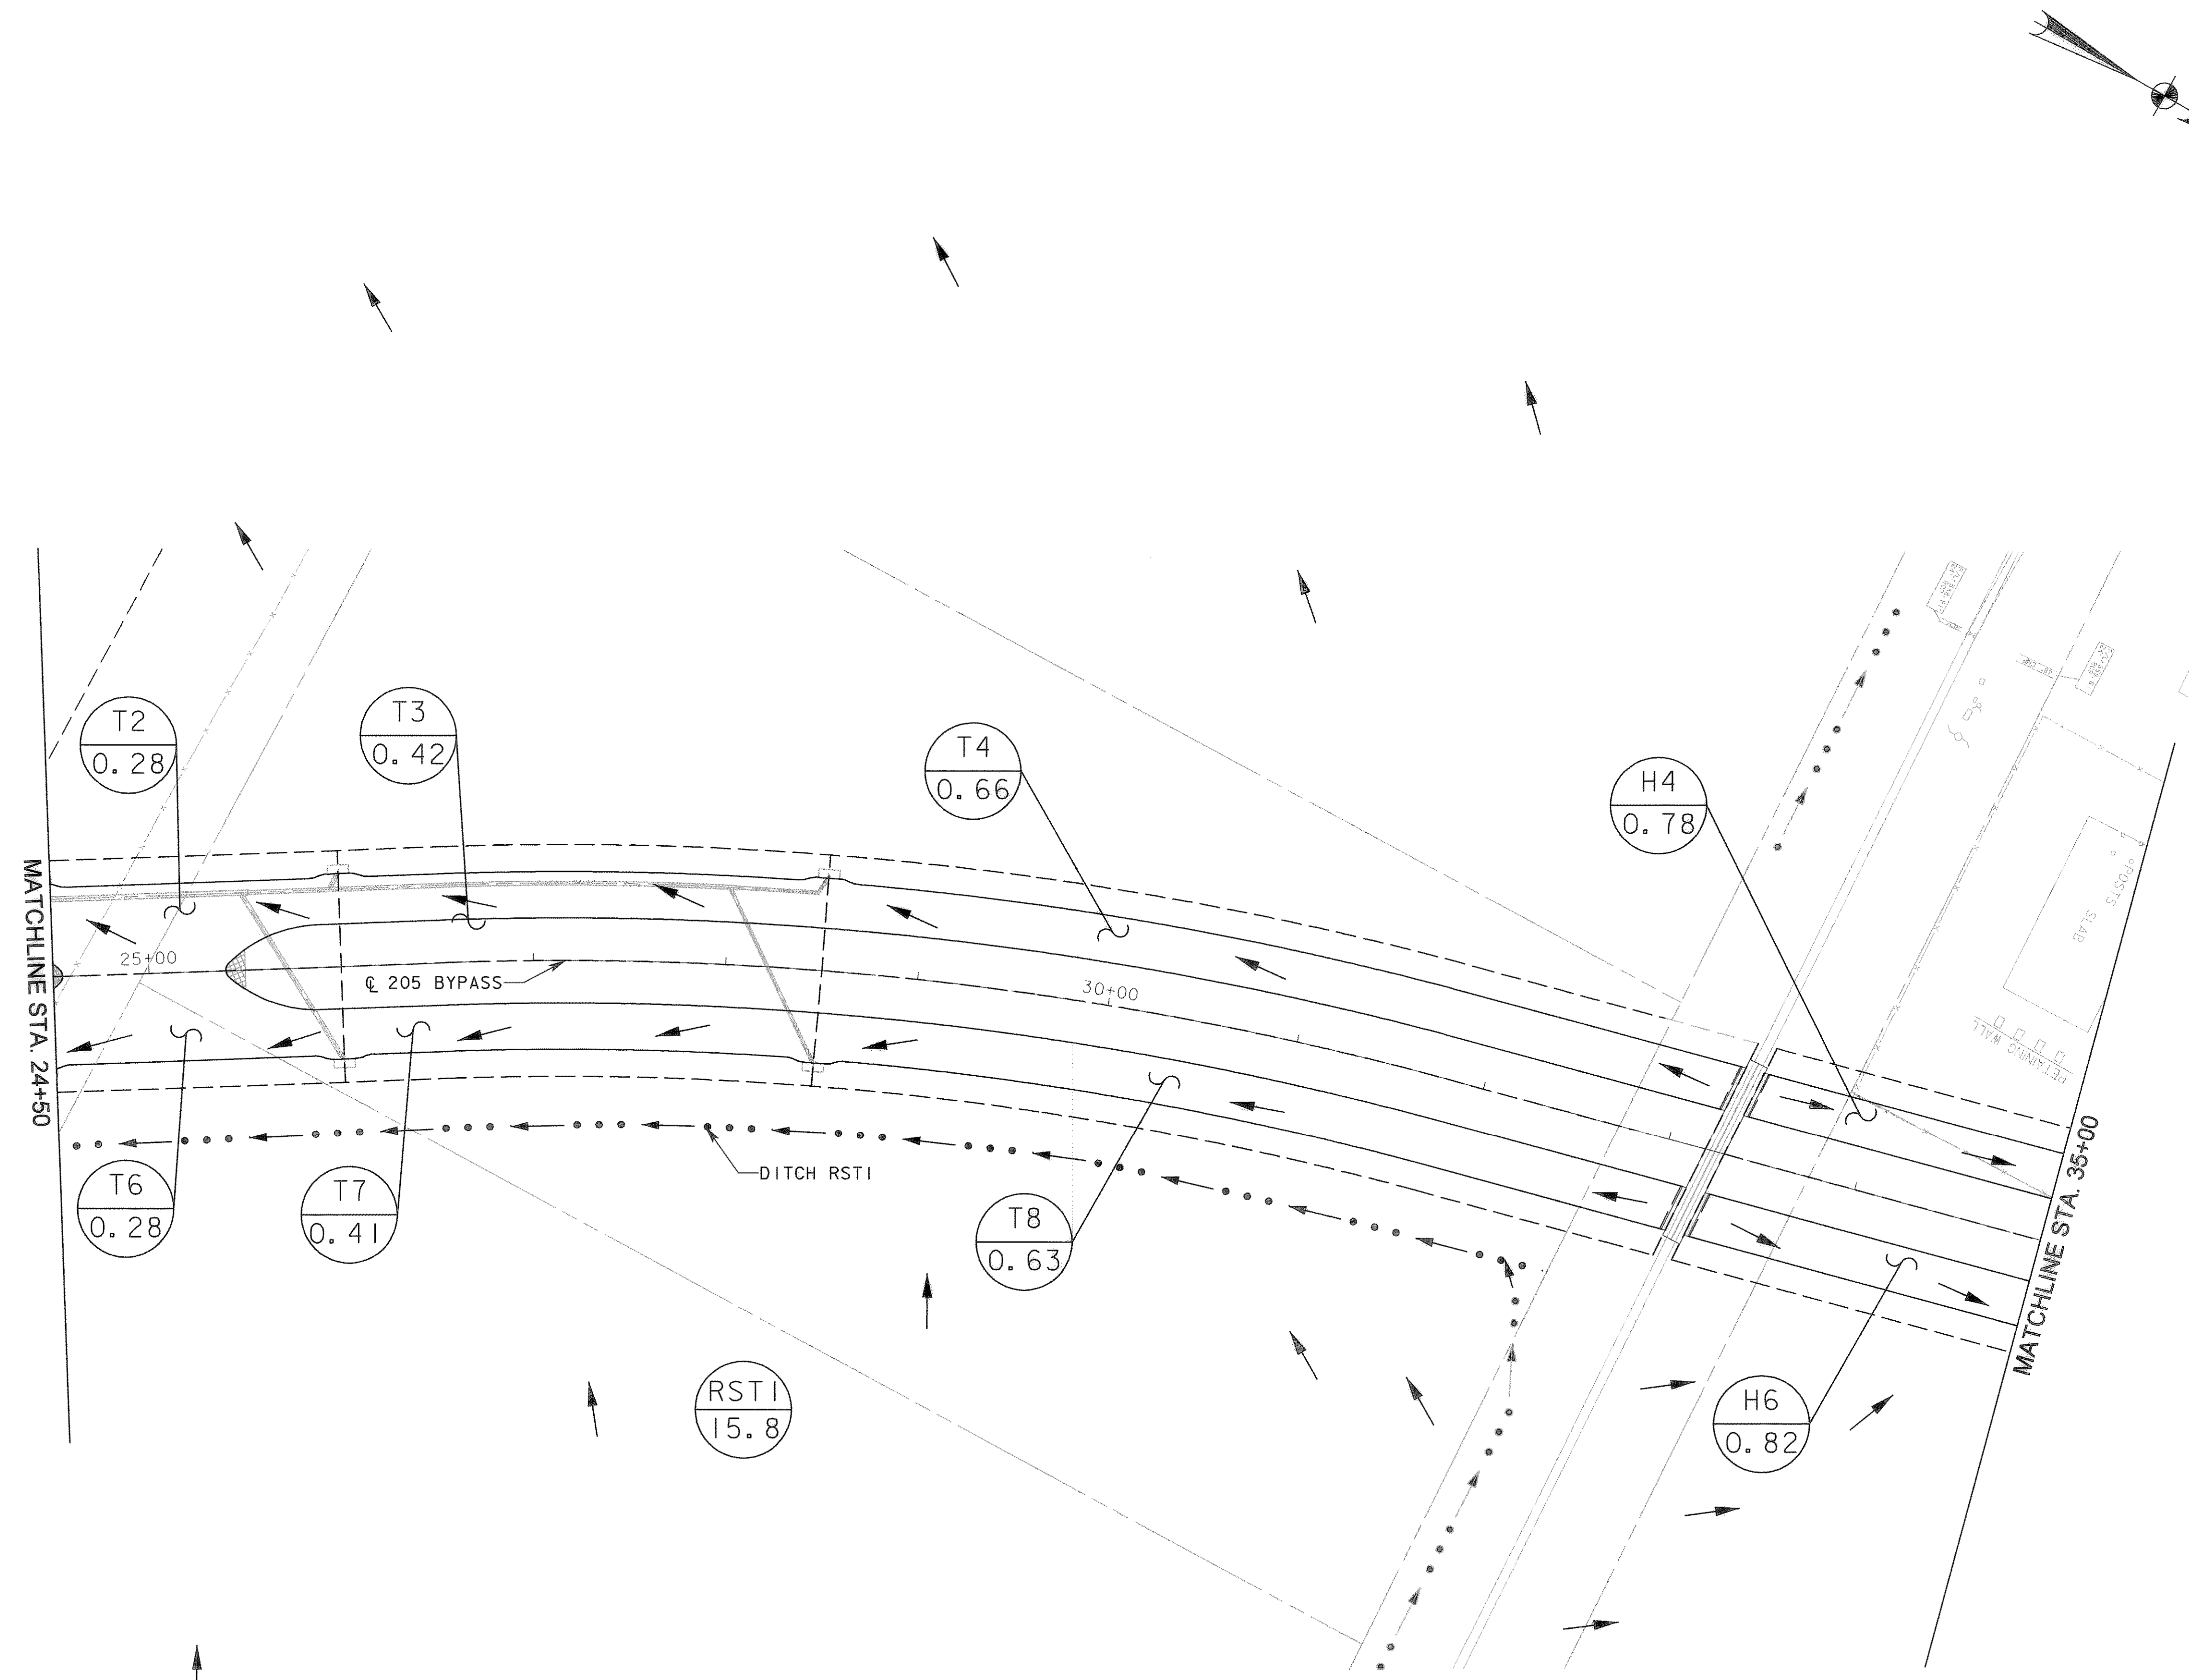

\\usdd11fp001\PM\4328\60004153-205Bypass\CADD\Sheets\Phase 3 - 1 30 to Station SH 66\Record Drawing 10.7.09\0600-01-in-8y8t-205BP03.dgn
 11/16/2009

NO.	REVISION	BY	DATE



City of Rockwall, Texas

**205 BYPASS
PHASE 3**

**DRAINAGE SYSTEM MAP
STA. 24+50 TO STA. 35+00**

TCB | AECOM
 TCB INC. WWW.TCB.AECOM.COM
 17300 DALLAS PARKWAY, SUITE 1010
 DALLAS, TEXAS 75248

Unit	PW-DAL-FW	Scale:	Horz: AS SHOWN Vert: AS SHOWN	Date	11/16/2009
Designed	SDB	Checked	TCB	Project No.	60004153
Drawn	FG	Approved	TCB	Sheet	60 of 215