


- LEGEND**
- INLET DESIGNATION AREA (AC)
 - INLET DRAINAGE BOUNDARY
 - SURFACE FLOW DIRECTION

- NOTES:**
1. SEE HYDRAULIC DATA SHEETS FOR GUTTER FLOW CALCULATIONS.
 2. DROP INLETS AND THE STORM DRAINS ARE SIZED FOR COLLECTING EXISTING FLOWS FROM OFFSITE AREAS OSE1. DEVELOPED FLOWS FROM THESE AREAS MUST BE DETAINED ACCORDING TO CURRENT CITY OF ROCKWALL CRITERIA.

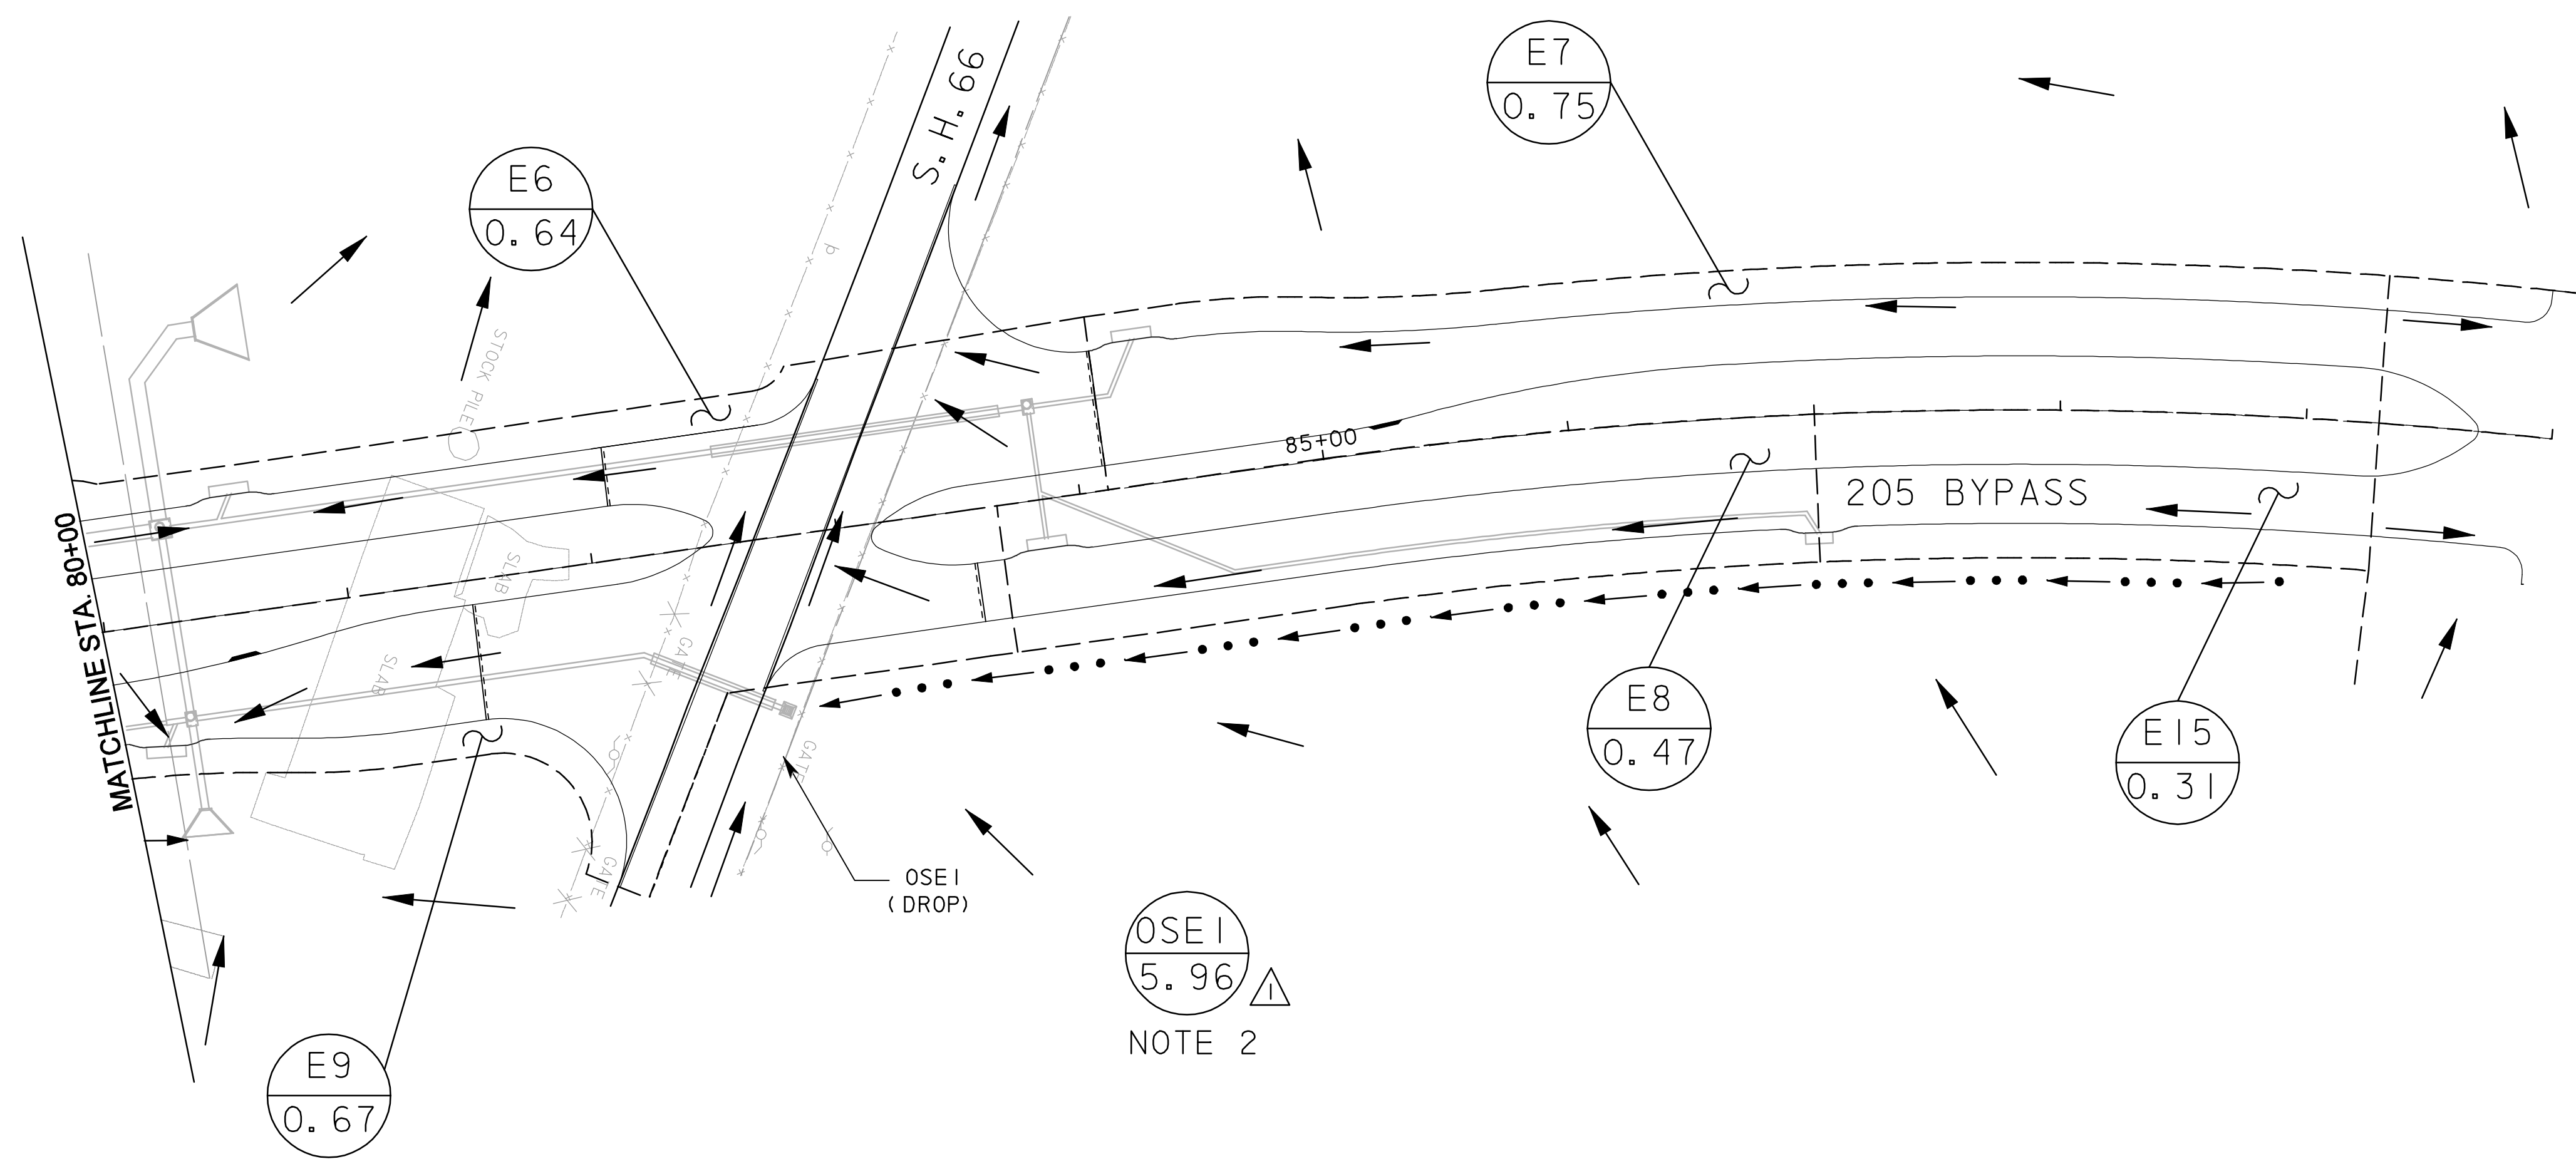

OSE1
5.96
NOTE 2

RECORD DRAWING
This drawing is a compilation of the original sealed engineering drawing and modifications by addenda, change orders and information furnished by the contractor. Information shown that was provided by the contractor and others not associated with the design engineer cannot be verified for accuracy or completeness. Original sealed drawing is on file at the office of AECOM USA Group, Inc., TBPE REG. NO. F-3082

ORIGINAL DRAWING SEALED & SIGNED BY
T.H. Gaertner, P.E.
TX NO. 37124

NO.	REVISION	BY	DATE
1	OSE1 DRAINAGE AREA	THG	5/20/08

City of Rockwall, Texas
205 BYPASS
PHASE 3
DRAINAGE SYSTEM MAP
STA. 80+00 TO STA. 83+00

TCB | AECOM
TCB INC.
WWW.TCB.AECOM.COM
17300 DALLAS PARKWAY, SUITE 1010
DALLAS, TEXAS 75248

Unit	PW-DAL-FW	Scale	Horz: AS SHOWN Vert: AS SHOWN	Date	11/23/2009
Designed	SDB	Checked	TCB	Project No.	60004153
Drawn	TCB	Approved	TCB	Sheet	66 of 215

\\usdel11p001\pww4328\60004153-205bypass\cadd\sheets\phase 3 - 1 30 to station sh 66\record drawing 10_7_09\066DraIn_syst-205BP09.dgn 11/23/2009