



SECTION A-A

RECORD DRAWING

This drawing is a compilation of the original sealed engineering drawing and modifications by addenda, change orders and information furnished by the contractor. Information shown that was provided by the contractor and others not associated with the design engineer cannot be verified for accuracy or completeness. Original sealed drawing is on file at the office of AECOM USA Group, Inc., TBPE REG. NO. F-3082

ORIGINAL DRAWING SEALED & SIGNED BY

T.H. Gaertner, P.E.
TX NO. 37124

| NO. | REVISION | BY | DATE |
|-----|----------|----|------|
| | | | |
| | | | |
| | | | |



City of Rockwall, Texas


205 BYPASS
PHASE 3

GRADING PLAN
AT STA 48+00

TCB AECOM
TCB INC.
WWW.TCB.AECOM.COM
17300 DALLAS PARKWAY, SUITE 1010
DALLAS, TEXAS 75248

| | | | | | |
|----------|-----------|----------|----------------------------------|-------------|------------|
| Unit | PW-DAL-FW | Scale | Horz: AS SHOWN Vert: AS SHOWN | Date | 11/23/2009 |
| Designed | SDB | Checked | TCB | Project No. | 60004153 |
| Drawn | FG | Approved | TCB | Sheet | 80 of 215 |

\\usdell1p001\pww4328\60004153-205bypass\cadd\sheets\phase 3 - 1 30 to station sh 66\record drawing 10_7_09\0800\grading-Cul-1- Sta 48+00.dgn
11/23/2009

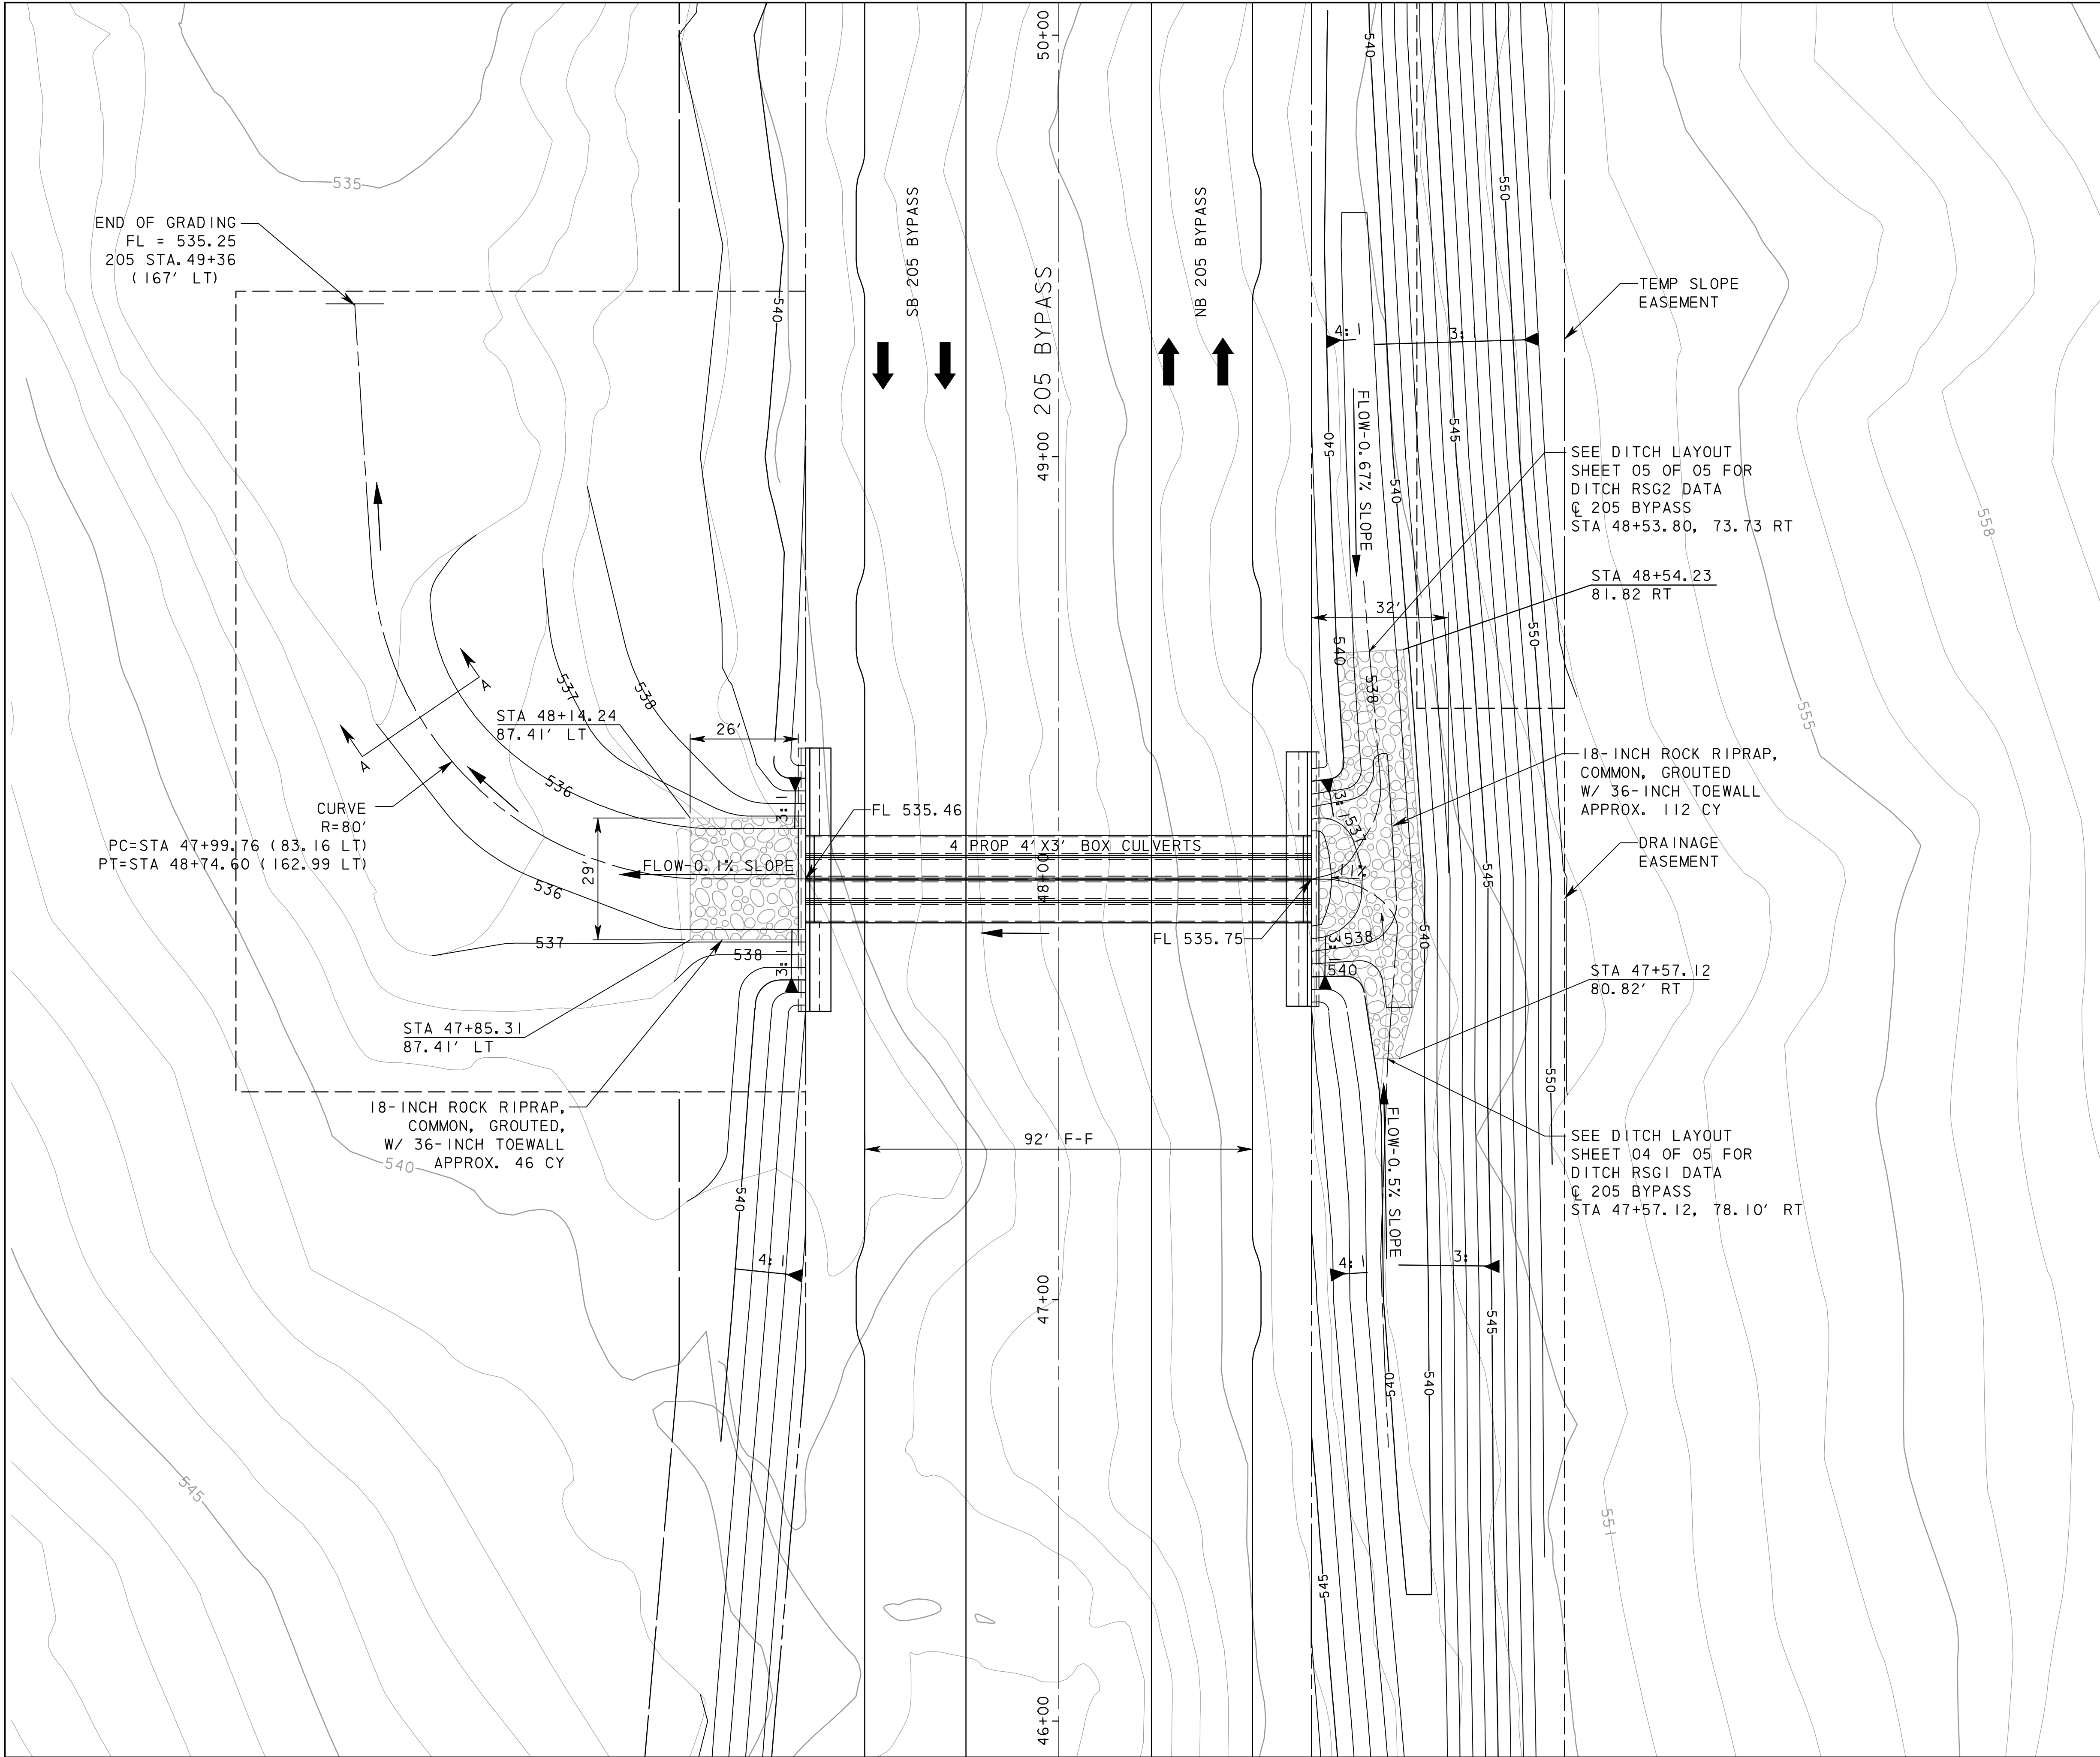

END OF GRADING
FL = 535.25
205 STA. 49+36
(167' LT)

CURVE
R=80'
PC=STA 47+99.76 (83.16 LT)
PT=STA 48+74.60 (162.99 LT)

STA 48+14.24
87.41' LT

18-INCH ROCK RIPRAP,
COMMON, GROUTED,
W/ 36-INCH TOEWALL
APPROX. 46 CY

4 PROP 4' X 3' BOX CULVERTS

TEMP SLOPE
EASEMENT

SEE DITCH LAYOUT
SHEET 05 OF 05 FOR
DITCH RSC2 DATA
@ 205 BYPASS
STA 48+53.80, 73.73 RT

STA 48+54.23
81.82 RT

18-INCH ROCK RIPRAP,
COMMON, GROUTED
W/ 36-INCH TOEWALL
APPROX. 112 CY

DRAINAGE
EASEMENT

STA 47+57.12
80.82' RT

SEE DITCH LAYOUT
SHEET 04 OF 05 FOR
DITCH RSG1 DATA
@ 205 BYPASS
STA 47+57.12, 78.10' RT