


**LEGEND**

- PROPOSED ROW
- ===== PROPOSED STORM DRAIN
- DRAINAGE EASEMENT
- TEMP. CONST. EASEMENT

**NOTES:**

- I. SEE STORM DRAIN PROFILES FOR LOCATION OF INLETS, MANHOLES, WYE CONNECTIONS, AND BENDS.

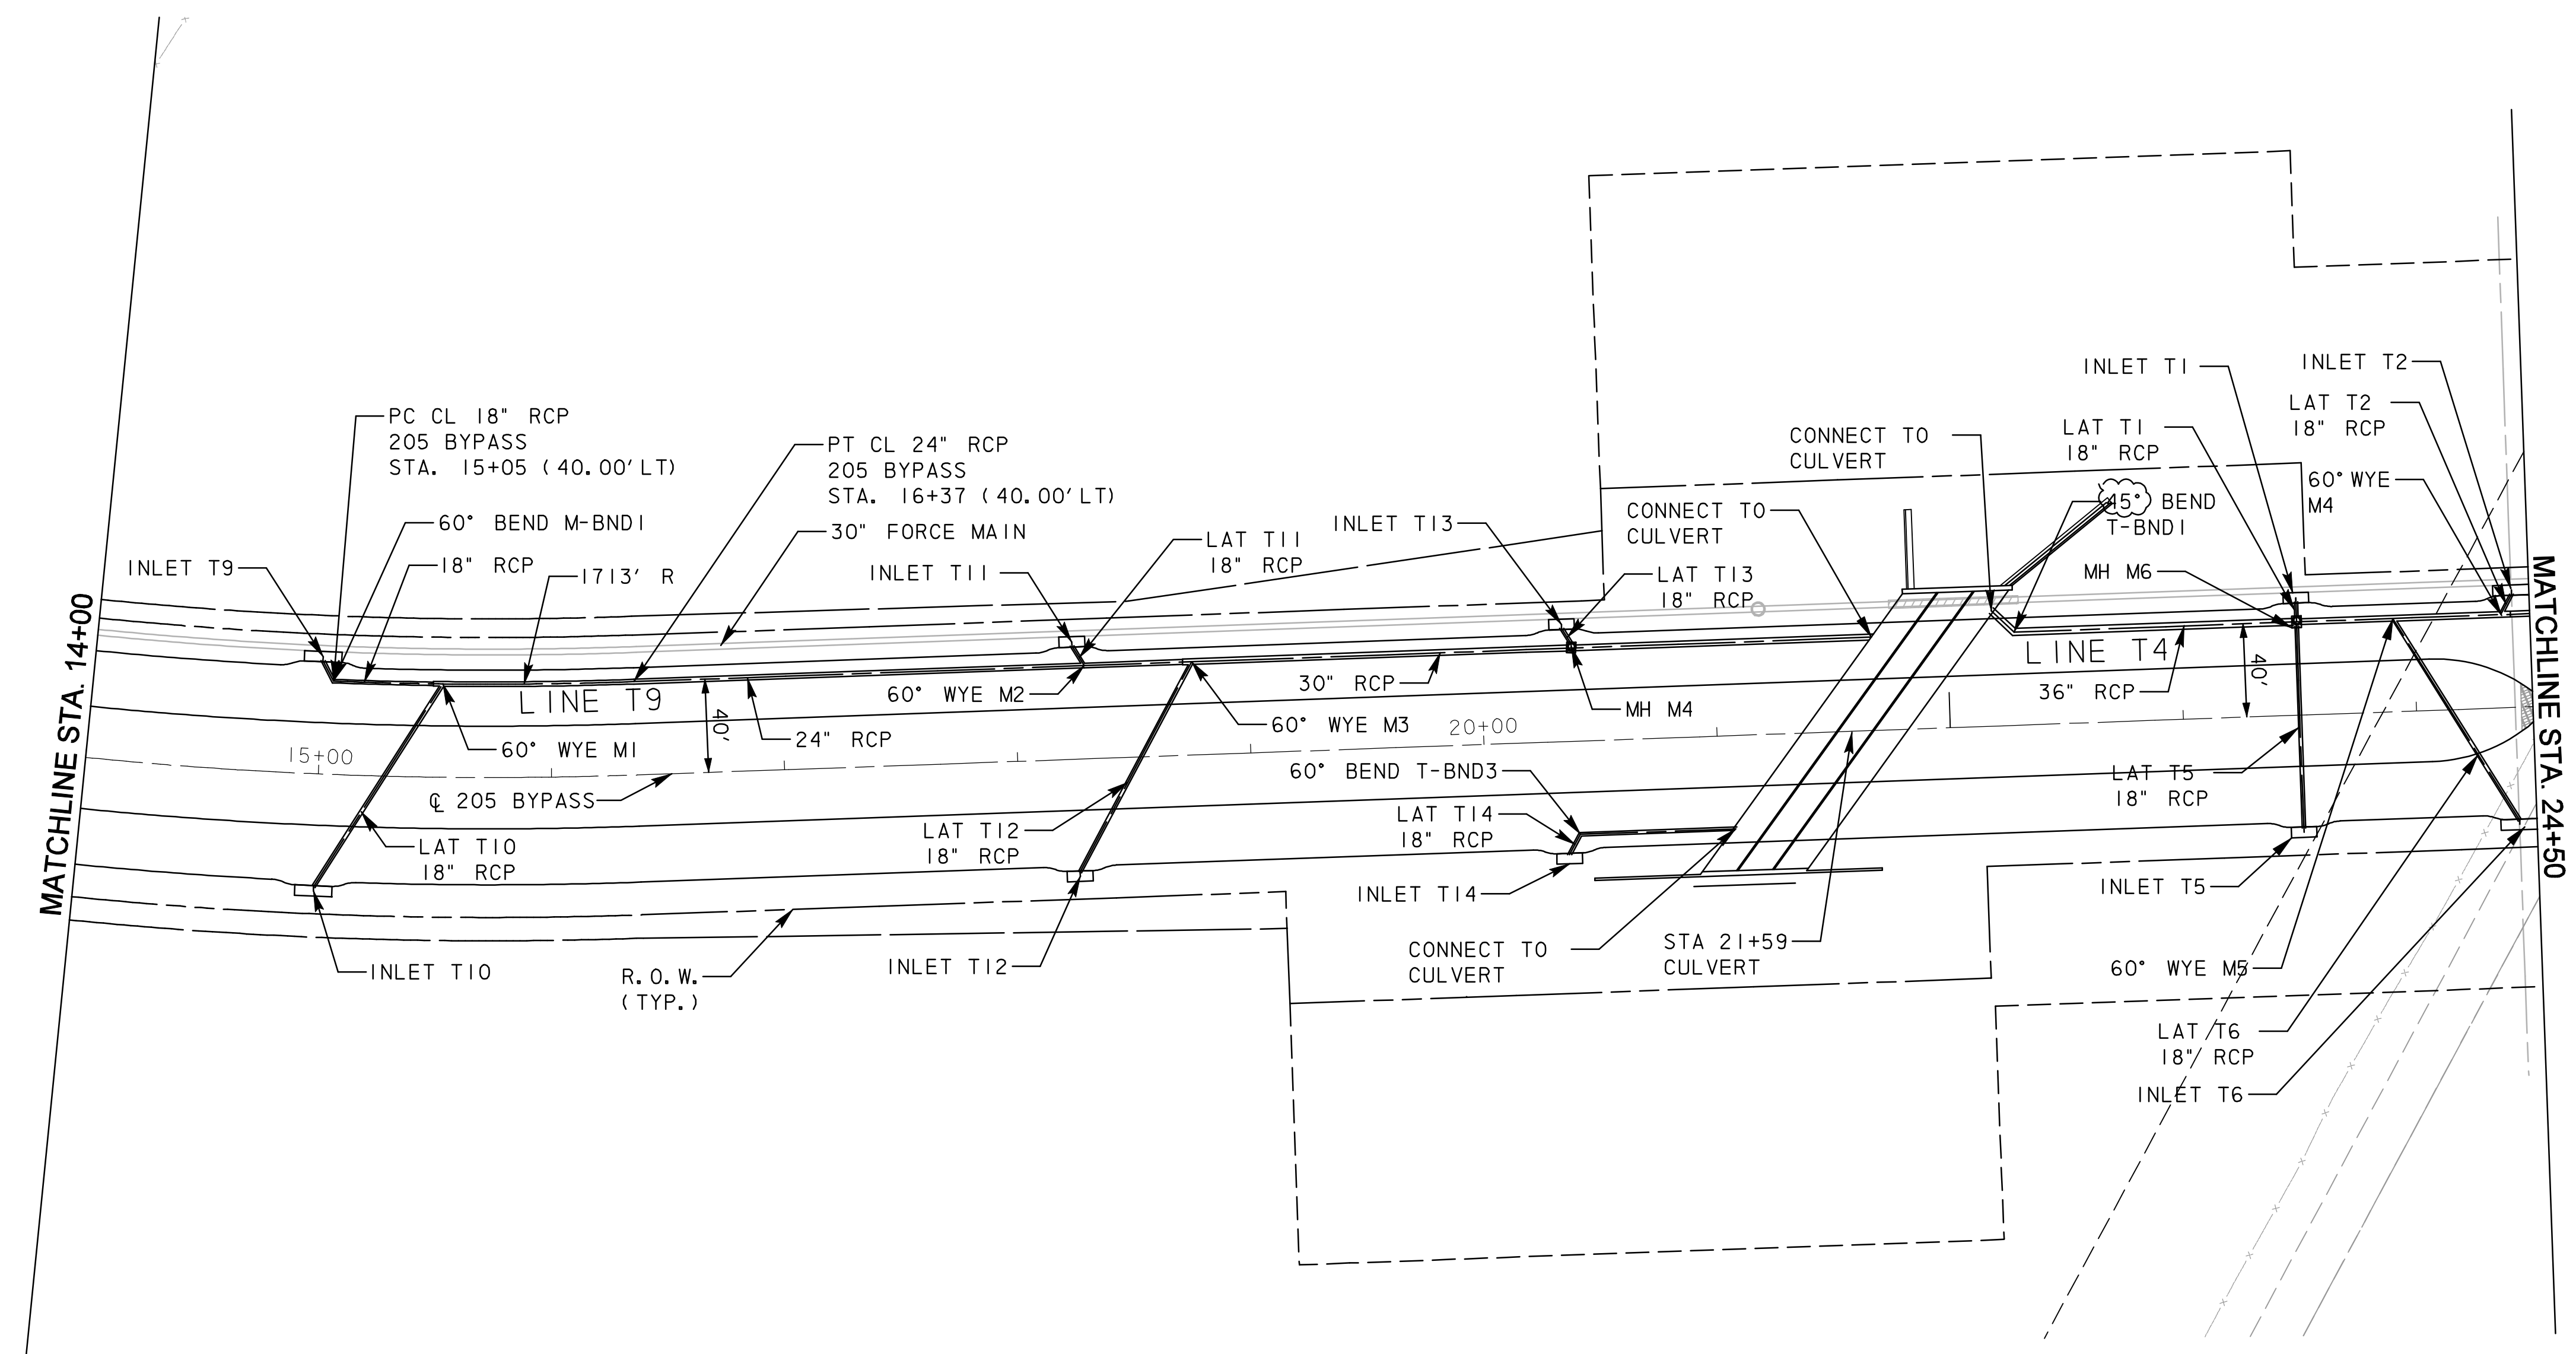

**RECORD DRAWING**  
 This drawing is a compilation of the original sealed engineering drawing and modifications by addenda, change orders and information furnished by the contractor. Information shown that was provided by the contractor and others not associated with the design engineer cannot be verified for accuracy or completeness. Original sealed drawing is on file at the office of AECOM USA Group, Inc., TBPE REG. NO. F-3082

ORIGINAL DRAWING  
 SEALED & SIGNED BY  
 T.H. Gaertner, P.E.  
 TX NO. 37124

|     |          |     |         |
|-----|----------|-----|---------|
| NO. | REVISION | BY  | DATE    |
| I   | T-BND1   | THG | 5/20/08 |



**205 BYPASS  
 PHASE 3  
 STORM DRAIN PLAN  
 STA. 14+00 TO STA. 24+50**

**TCB AECOM**  
 TCB INC.  
 WWW.TCB.AECOM.COM  
 17300 DALLAS PARKWAY, SUITE 1010  
 DALLAS, TEXAS 75248

|          |           |          |                                  |             |            |
|----------|-----------|----------|----------------------------------|-------------|------------|
| Unit     | PW-DAL-FW | Scale    | Horz: AS SHOWN<br>Vert: AS SHOWN | Date        | 11/23/2009 |
| Designed | SDB       | Checked  | TCB                              | Project No. | 60004153   |
| Drawn    | FG        | Approved | TCB                              | Sheet       | 82 of 215  |

\\usdel11p001\pww4328\60004153-205bypass\cadd\sheets\phase 3 - 1 30 to start\on sh 66\record drawing 10\_7\_09\0825Storm\_Plan-02.dgn  
 11/23/2009