


CAUTION: EXISTING UTILITIES.  
SEE UTILITY LAYOUT SHEETS.




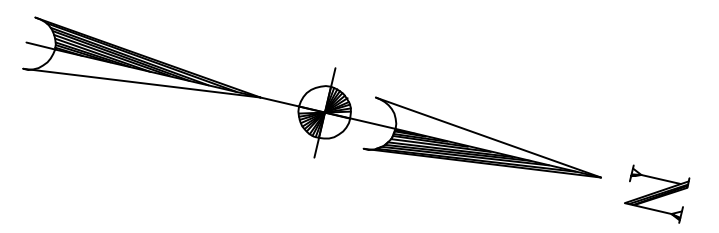


LEGEND

- PROPOSED ROW
- PROPOSED STORM DRAIN
- DRAINAGE EASEMENT
- TEMP. CONST. EASEMENT

NOTES:

1. SEE STORM DRAIN PROFILES FOR LOCATION OF INLETS, MANHOLES, WYE CONNECTIONS, AND BENDS.

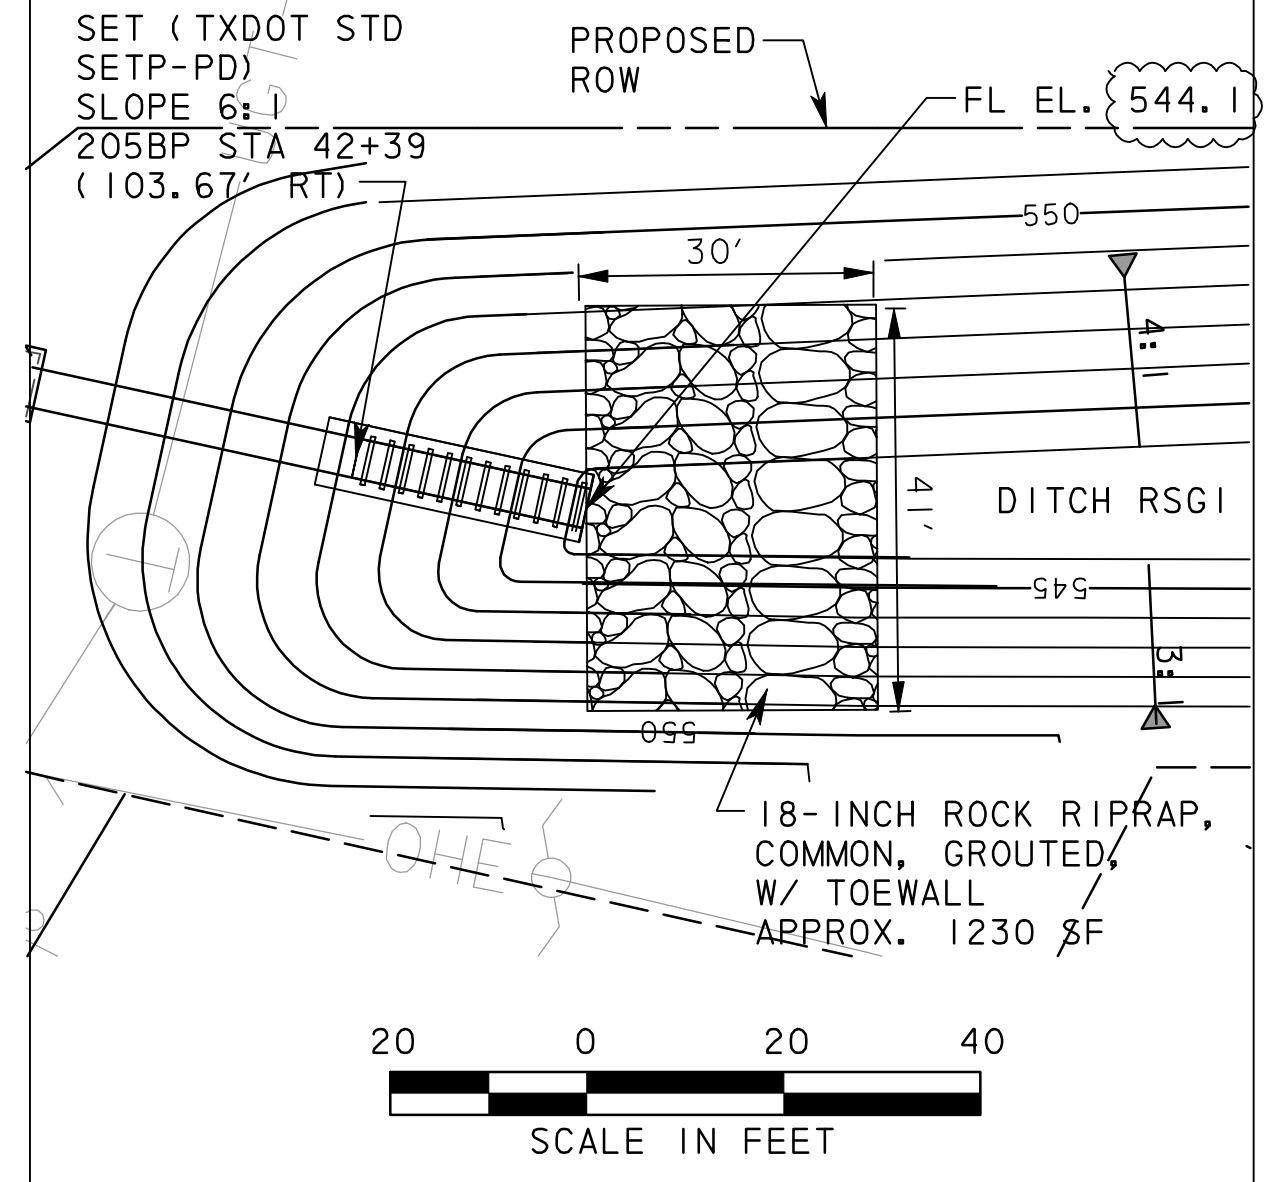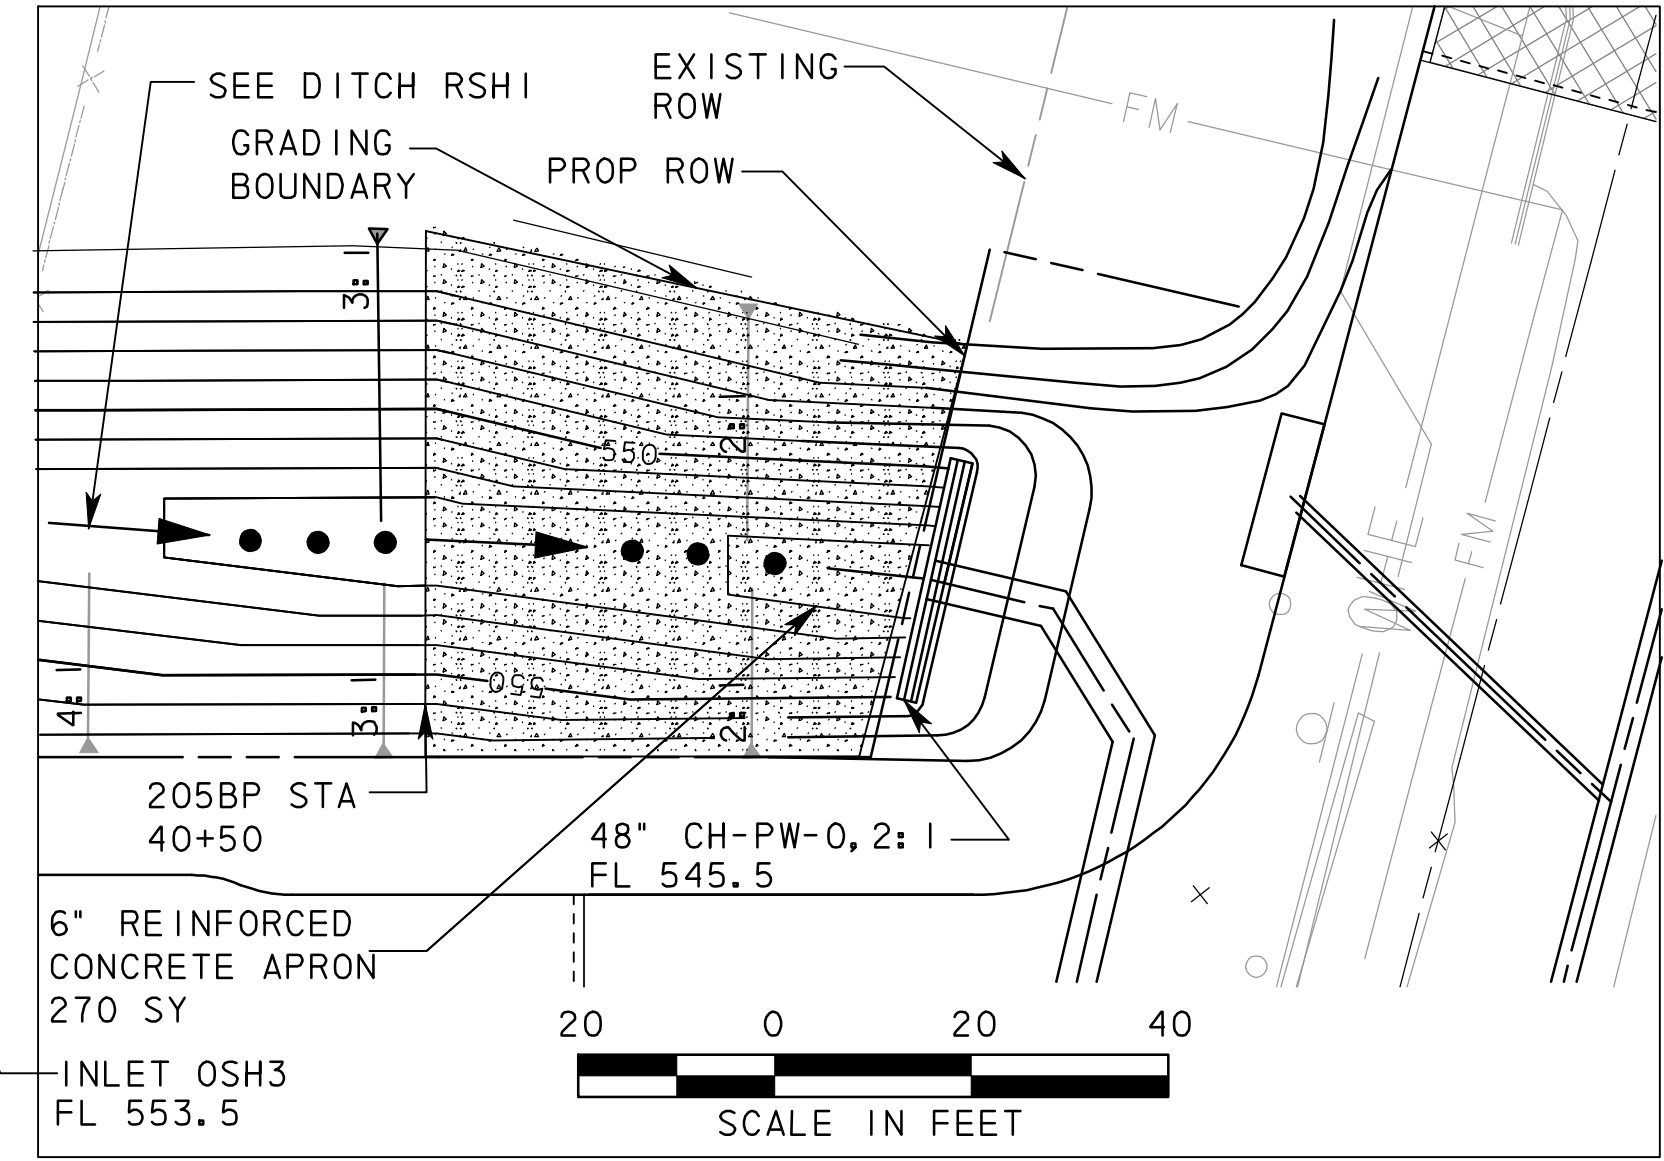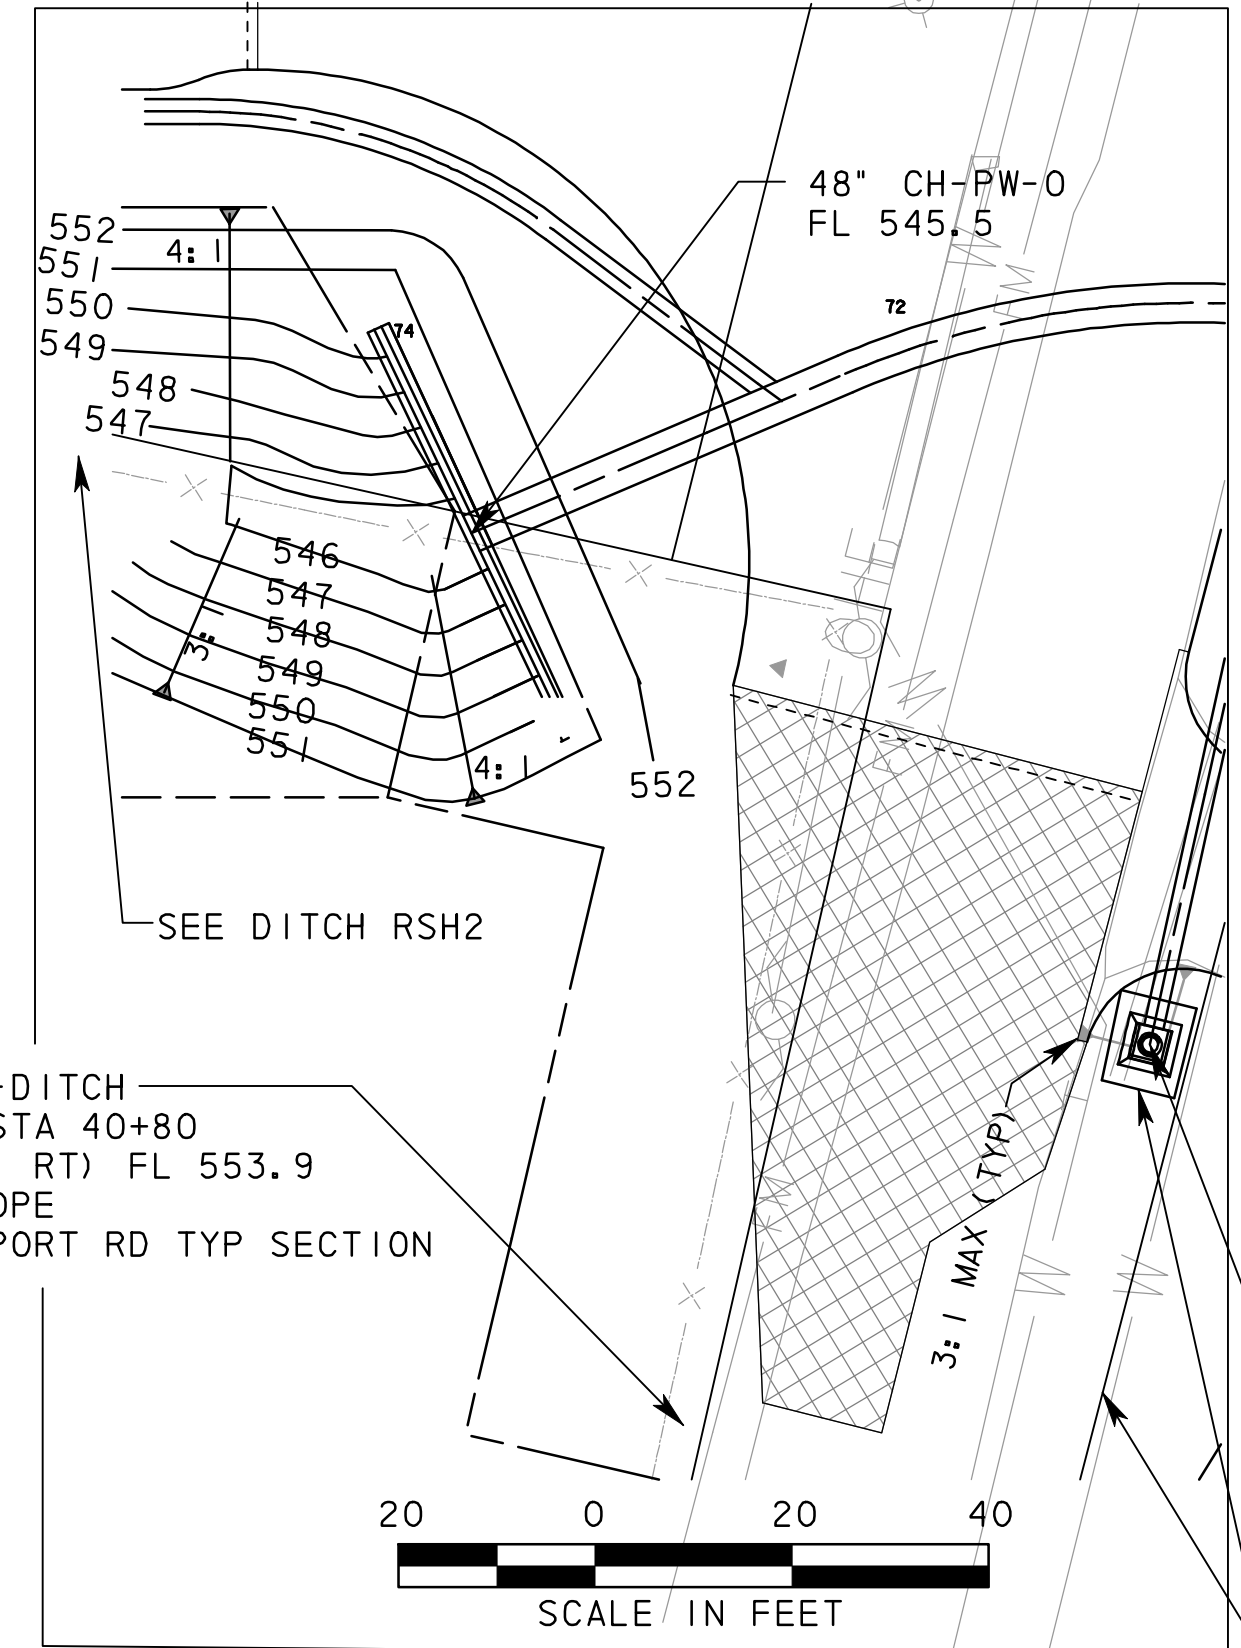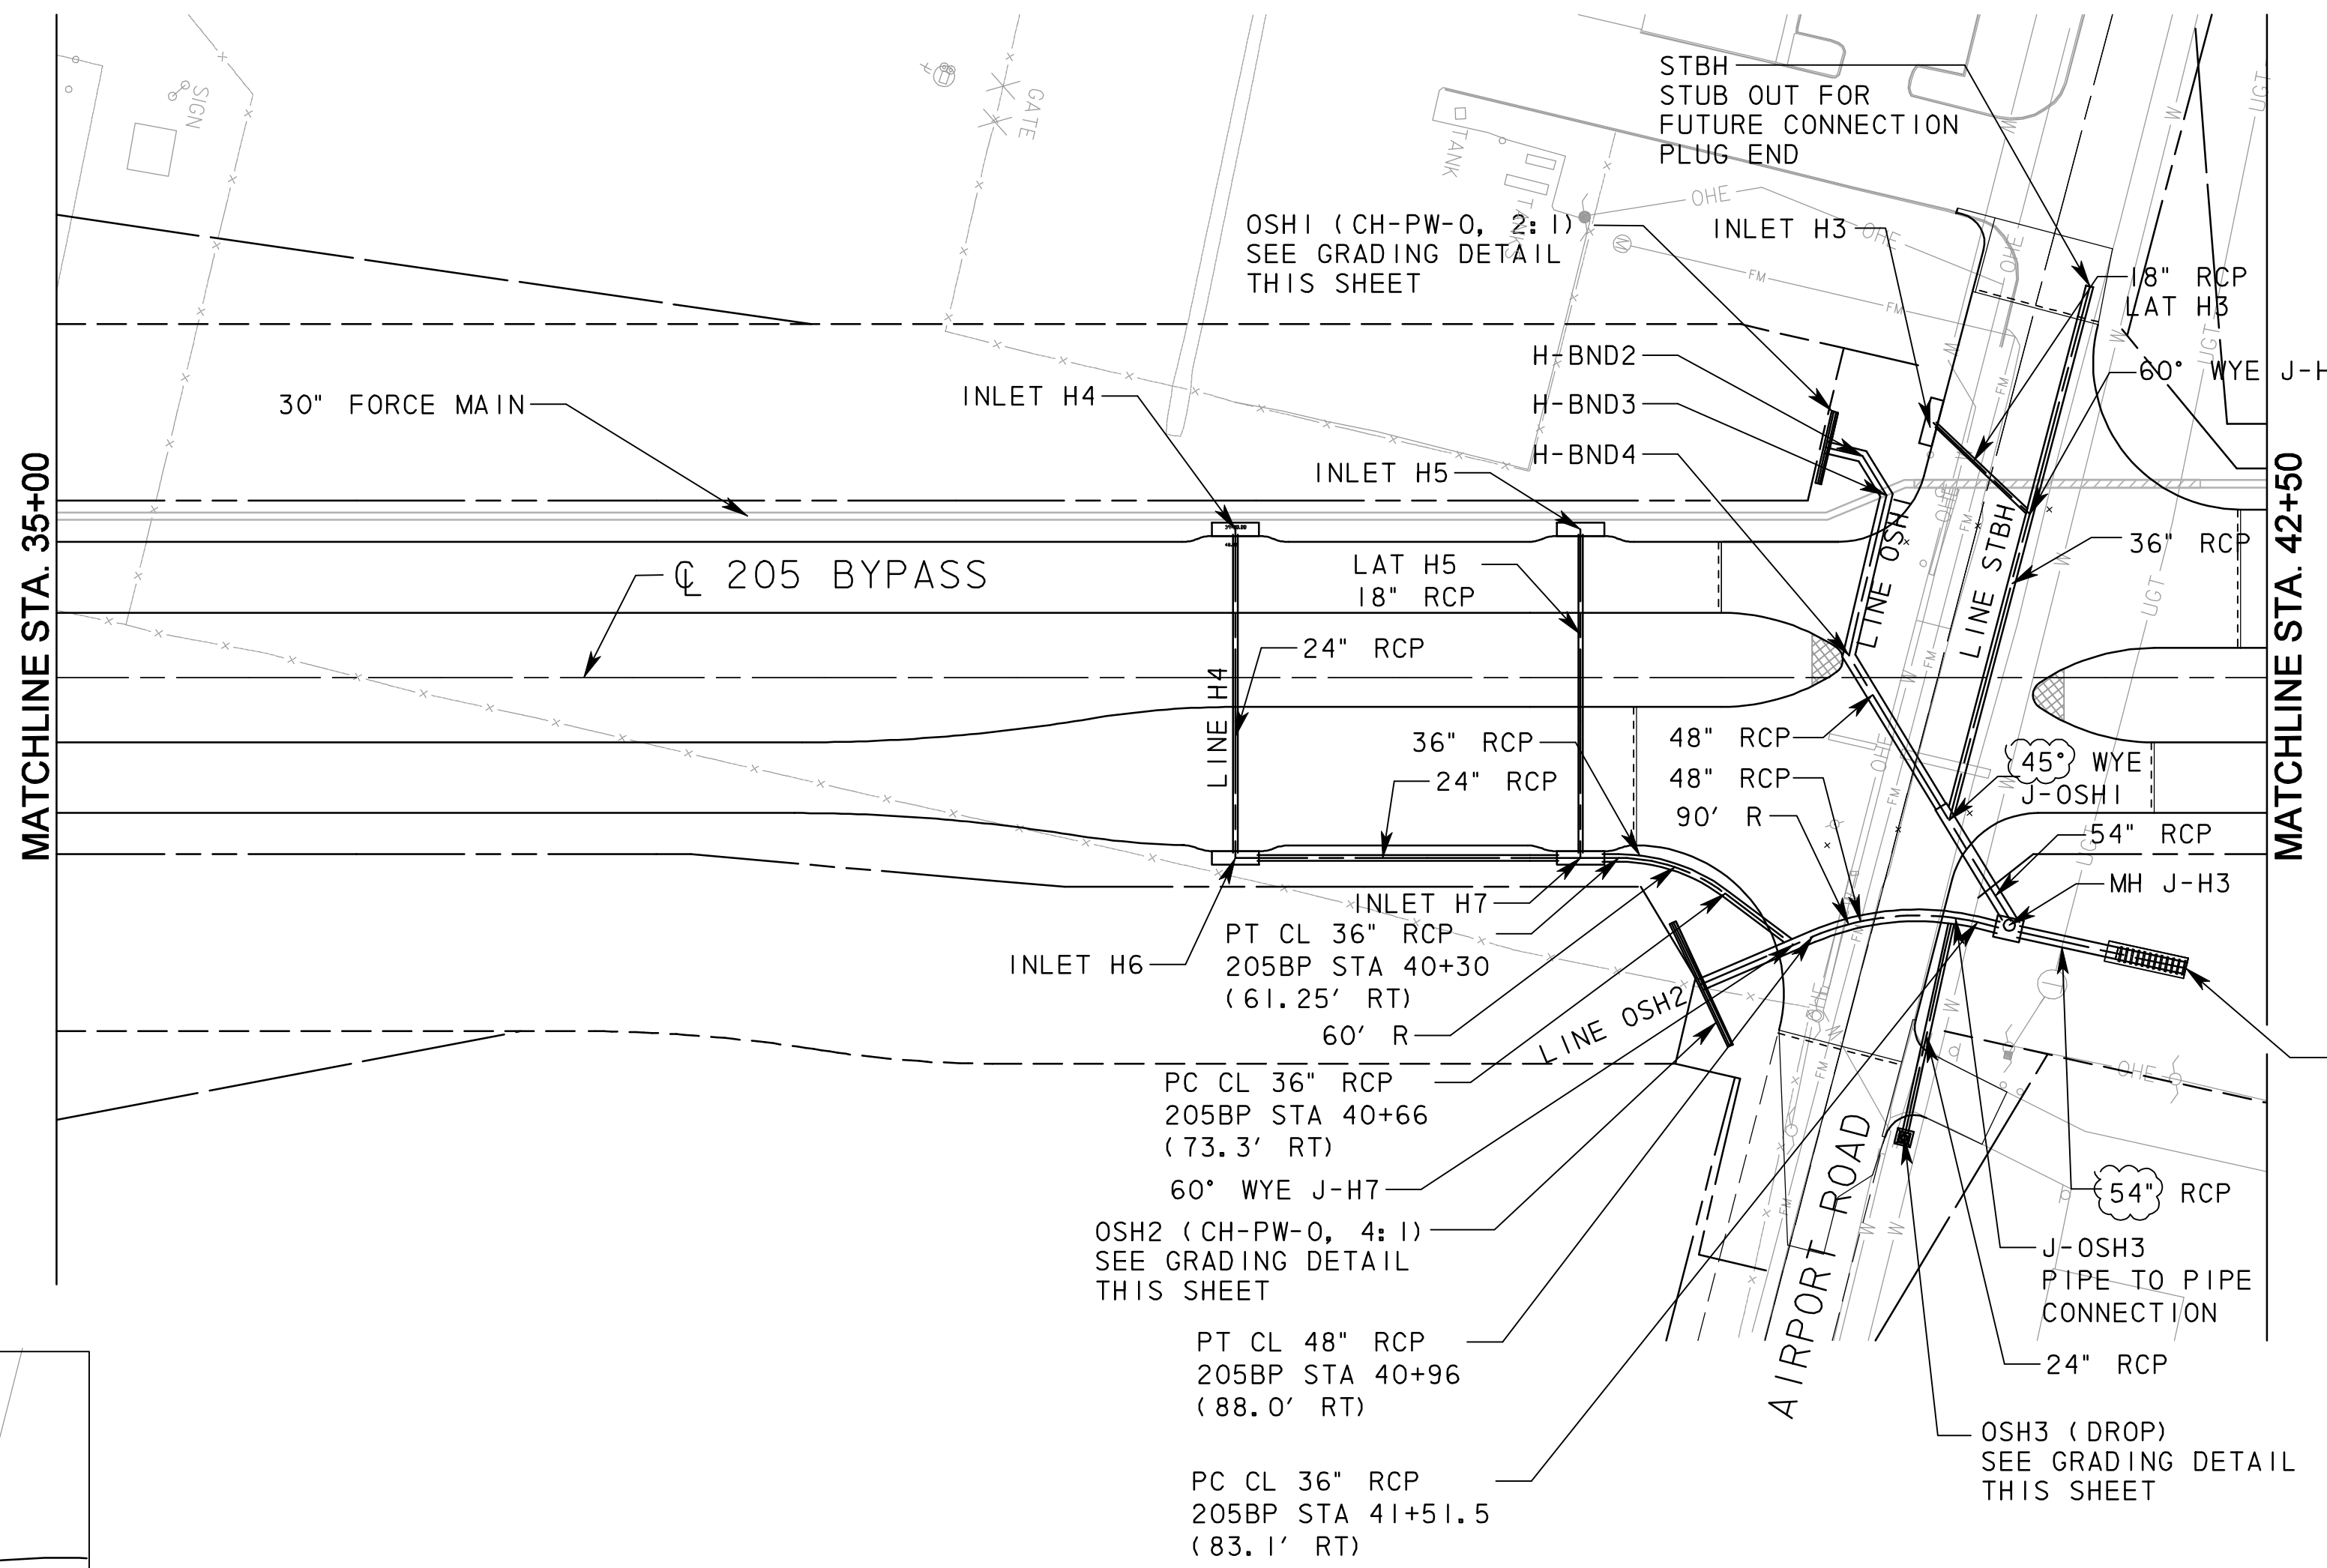

BEGIN V-DITCH  
205 BP STA 40+80  
(201.17' RT) FL 553.9  
5.1% SLOPE  
SEE AIRPORT RD TYP SECTION

**RECORD DRAWING**  
This drawing is a compilation of the original sealed engineering drawing and modifications by addenda, change orders and information furnished by the contractor. Information shown that was provided by the contractor and others not associated with the design engineer cannot be verified for accuracy or completeness. Original sealed drawing is on file at the office of AECOM USA Group, Inc., TBPE REG. NO. F-3082

ORIGINAL DRAWING  
SEALED & SIGNED BY  
T.H. Gaertner, P.E.  
TX NO. 37124

MISCELLANEOUS		THG	5/20/08
NO.	REVISION	BY	DATE
<b>205 BYPASS PHASE 3</b>			
<b>STORM DRAIN PLAN STA. 35+00 TO STA. 42+50</b>			
		TCB INC. WWW.TCB.AECOM.COM 17300 DALLAS PARKWAY, SUITE 1010 DALLAS, TEXAS 75248	
Unit	PW-DAL-FW	Scale	Horz: AS SHOWN Vert: AS SHOWN
Designed	SDB	Checked	TCB
Drawn	FG	Approved	TCB
Date	11/23/2009		Project No. 60004153
Sheet	84	of	215

\\usdell1p001\pww4328\60004153-205bypass\cadd\sheet\phase 3 - 1 30 to start\on sh 66\record drawing 10\_7\_09\_0845\storm.p lan-04.dgn  
 11/23/2009