


LEGEND

- PROPOSED ROW
- ===== PROPOSED STORM DRAIN
- - - - - DRAINAGE EASEMENT
- - - - - TEMP. CONST. EASEMENT

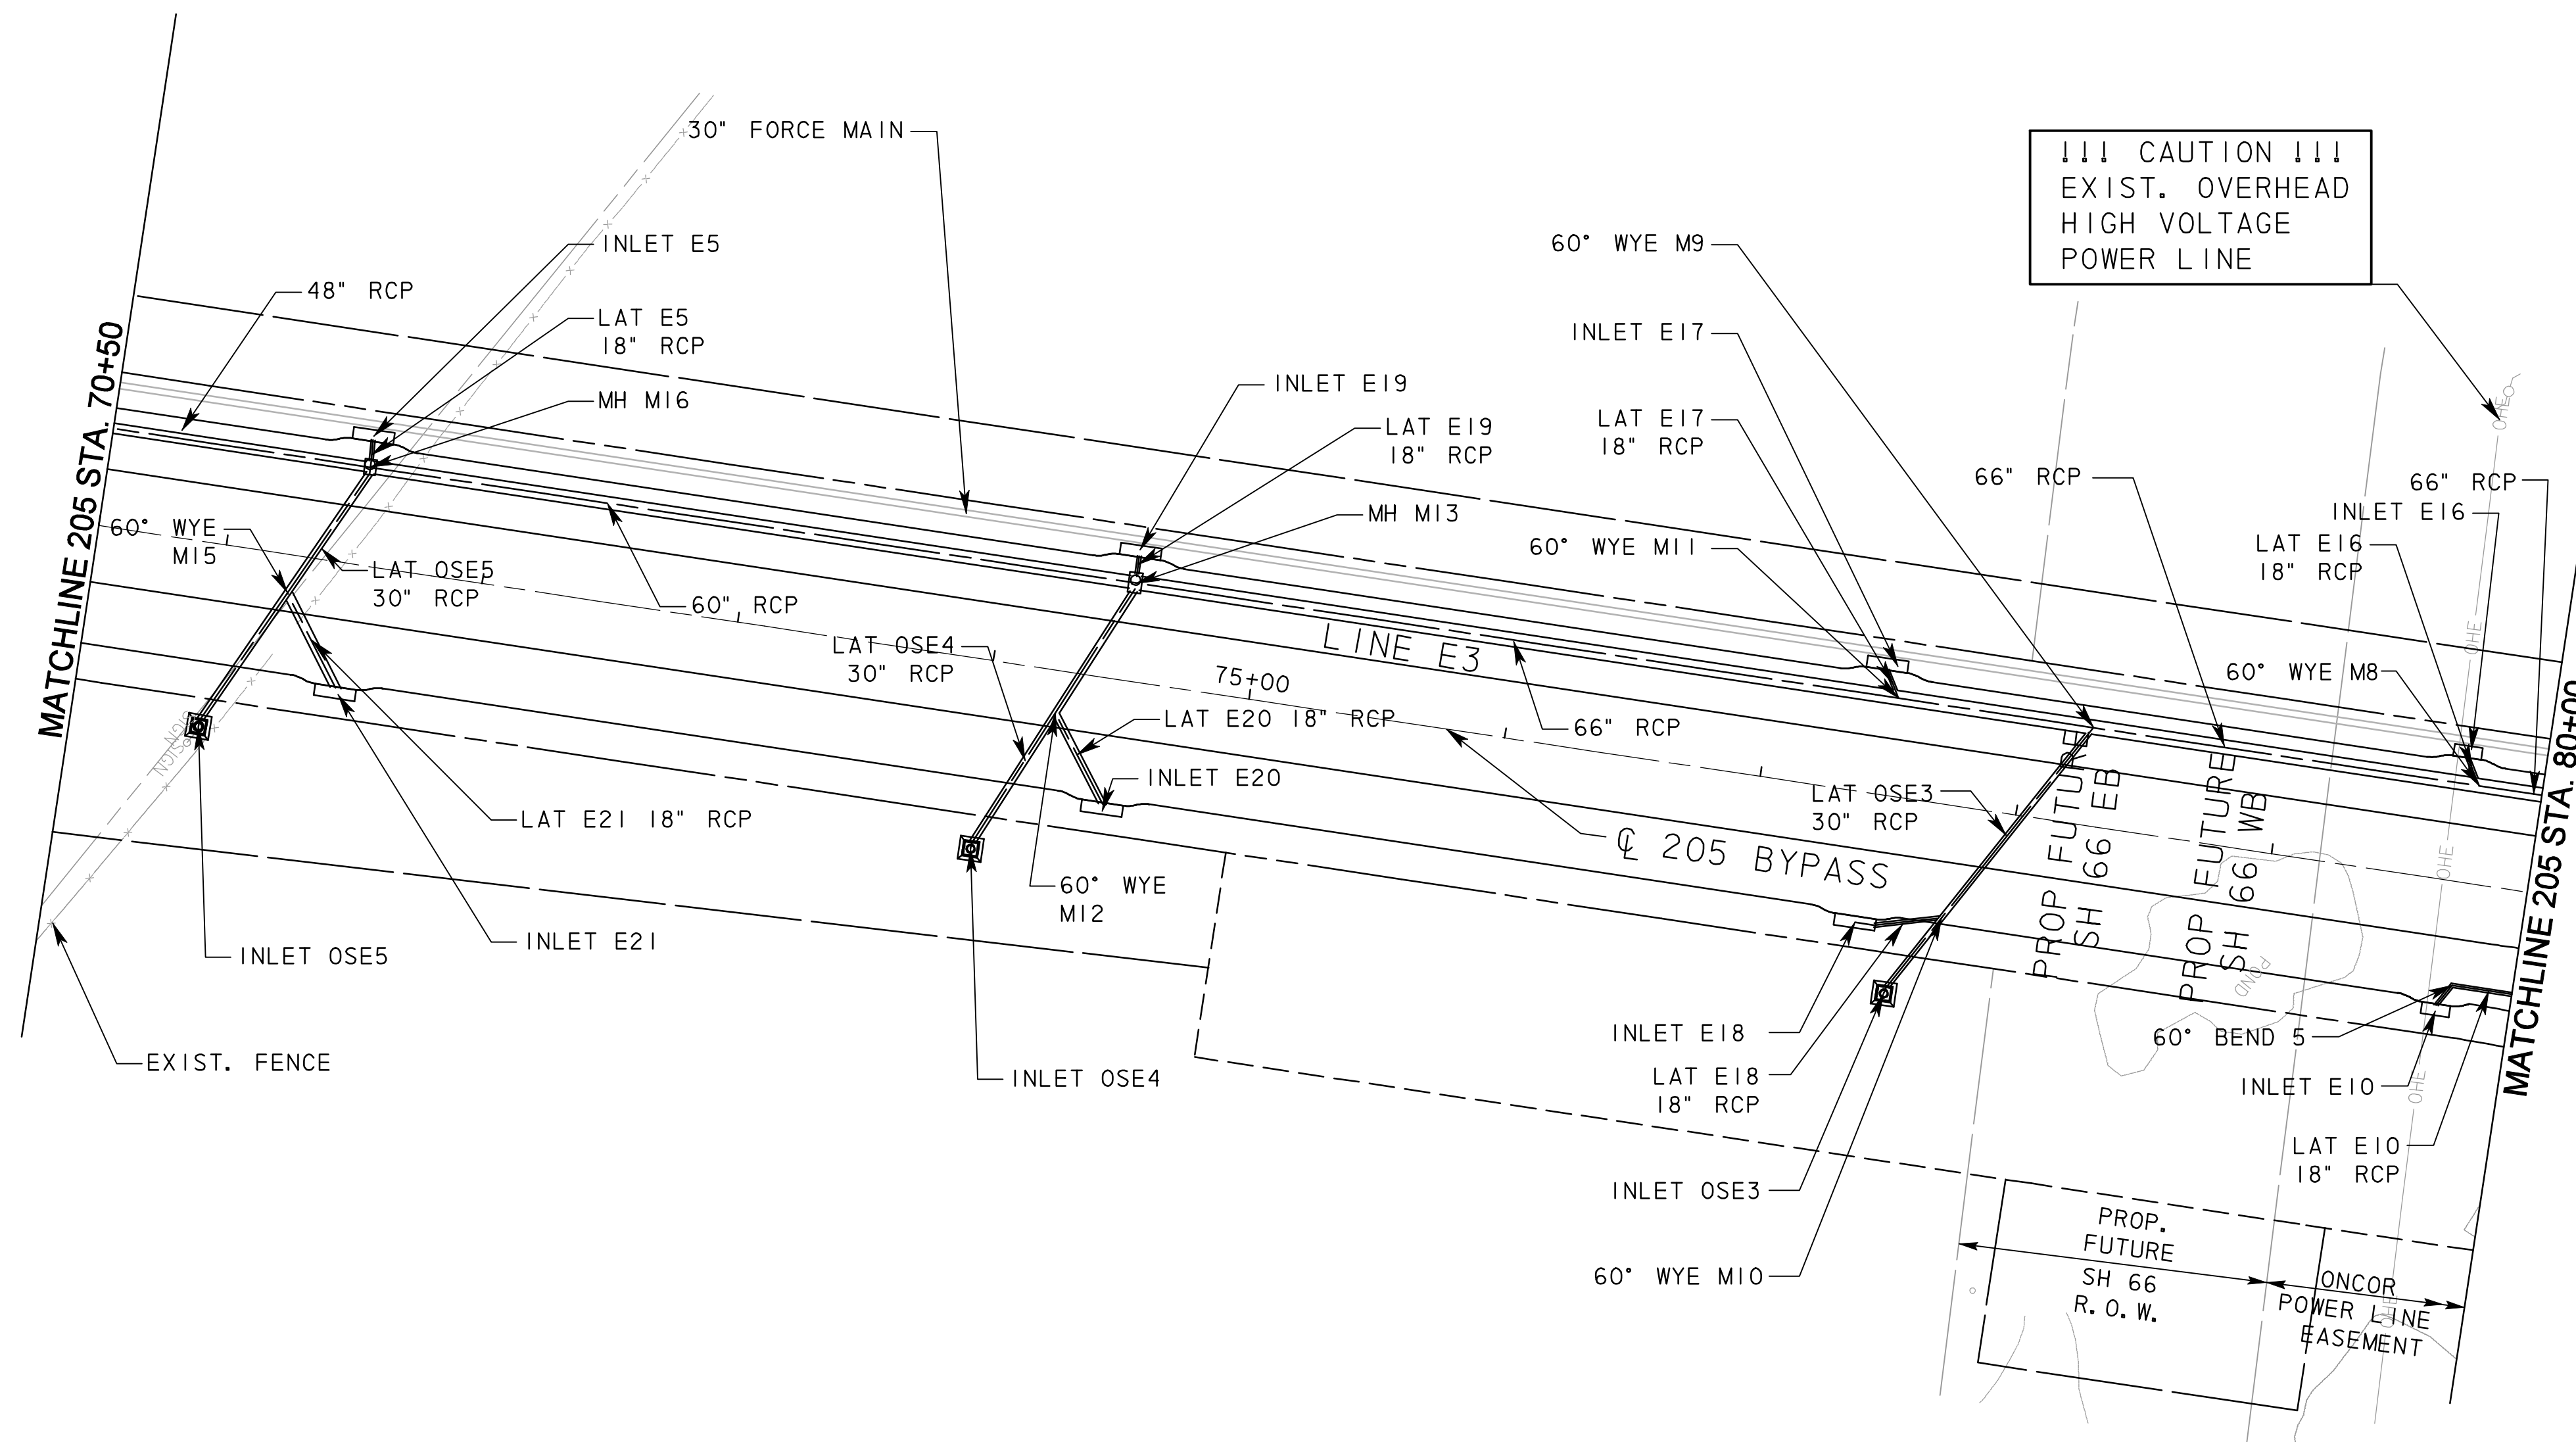

!!! CAUTION !!!
EXIST. OVERHEAD
HIGH VOLTAGE
POWER LINE

RECORD DRAWING
This drawing is a compilation of the original sealed engineering drawing and modifications by addenda, change orders and information furnished by the contractor. Information shown that was provided by the contractor and others not associated with the design engineer cannot be verified for accuracy or completeness. Original sealed drawing is on file at the office of AECOM USA Group, Inc., TBPE REG. NO. F-3082

ORIGINAL DRAWING
SEALED & SIGNED BY
T.H. Gaertner, P.E.
TX NO. 37124

NO.	REVISION	BY	DATE
205 BYPASS PHASE 3			
STORM PLAN STA. 70+50 TO STA. 80+00			
		<small>TCB INC. WWW.TCB.AECOM.COM 17300 DALLAS PARKWAY, SUITE 1010 DALLAS, TEXAS 75248</small>	
Unit	PW-DAL-FW	Scale	Horz: AS SHOWN Vert: AS SHOWN
Designed	SDB	Checked	TCB
Drawn	FG	Approved	TCB
Date	11/23/2009	Project No.	60004153
Sheet	88	of	215

\\usdell1p001\pww\4328\60004153-205bypass\cadd\sheet\phase 3 - 1 30 to start\on sh 66\record drawing 10_7_09\086storm.p lan-08.dgn
 11/23/2009