
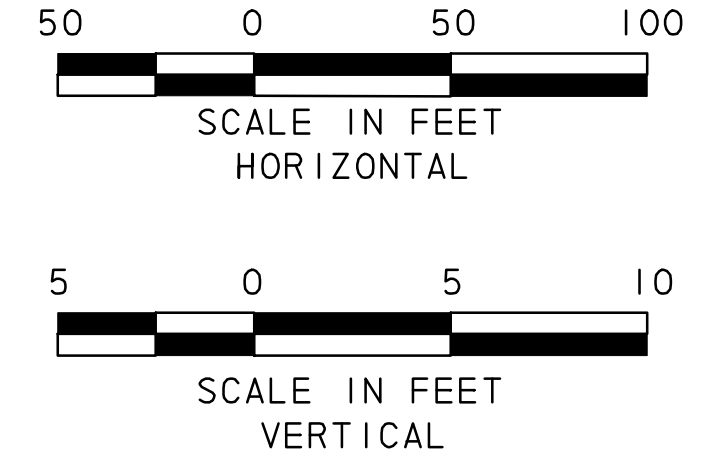


\\usdell1\p001\pww\4328\60004153-205bypass\cadd\sheet\phase 3 - 1 30 to station.sh 66\record drawing 10_7_09\093storm_profile-04.dgn
 11/23/2009

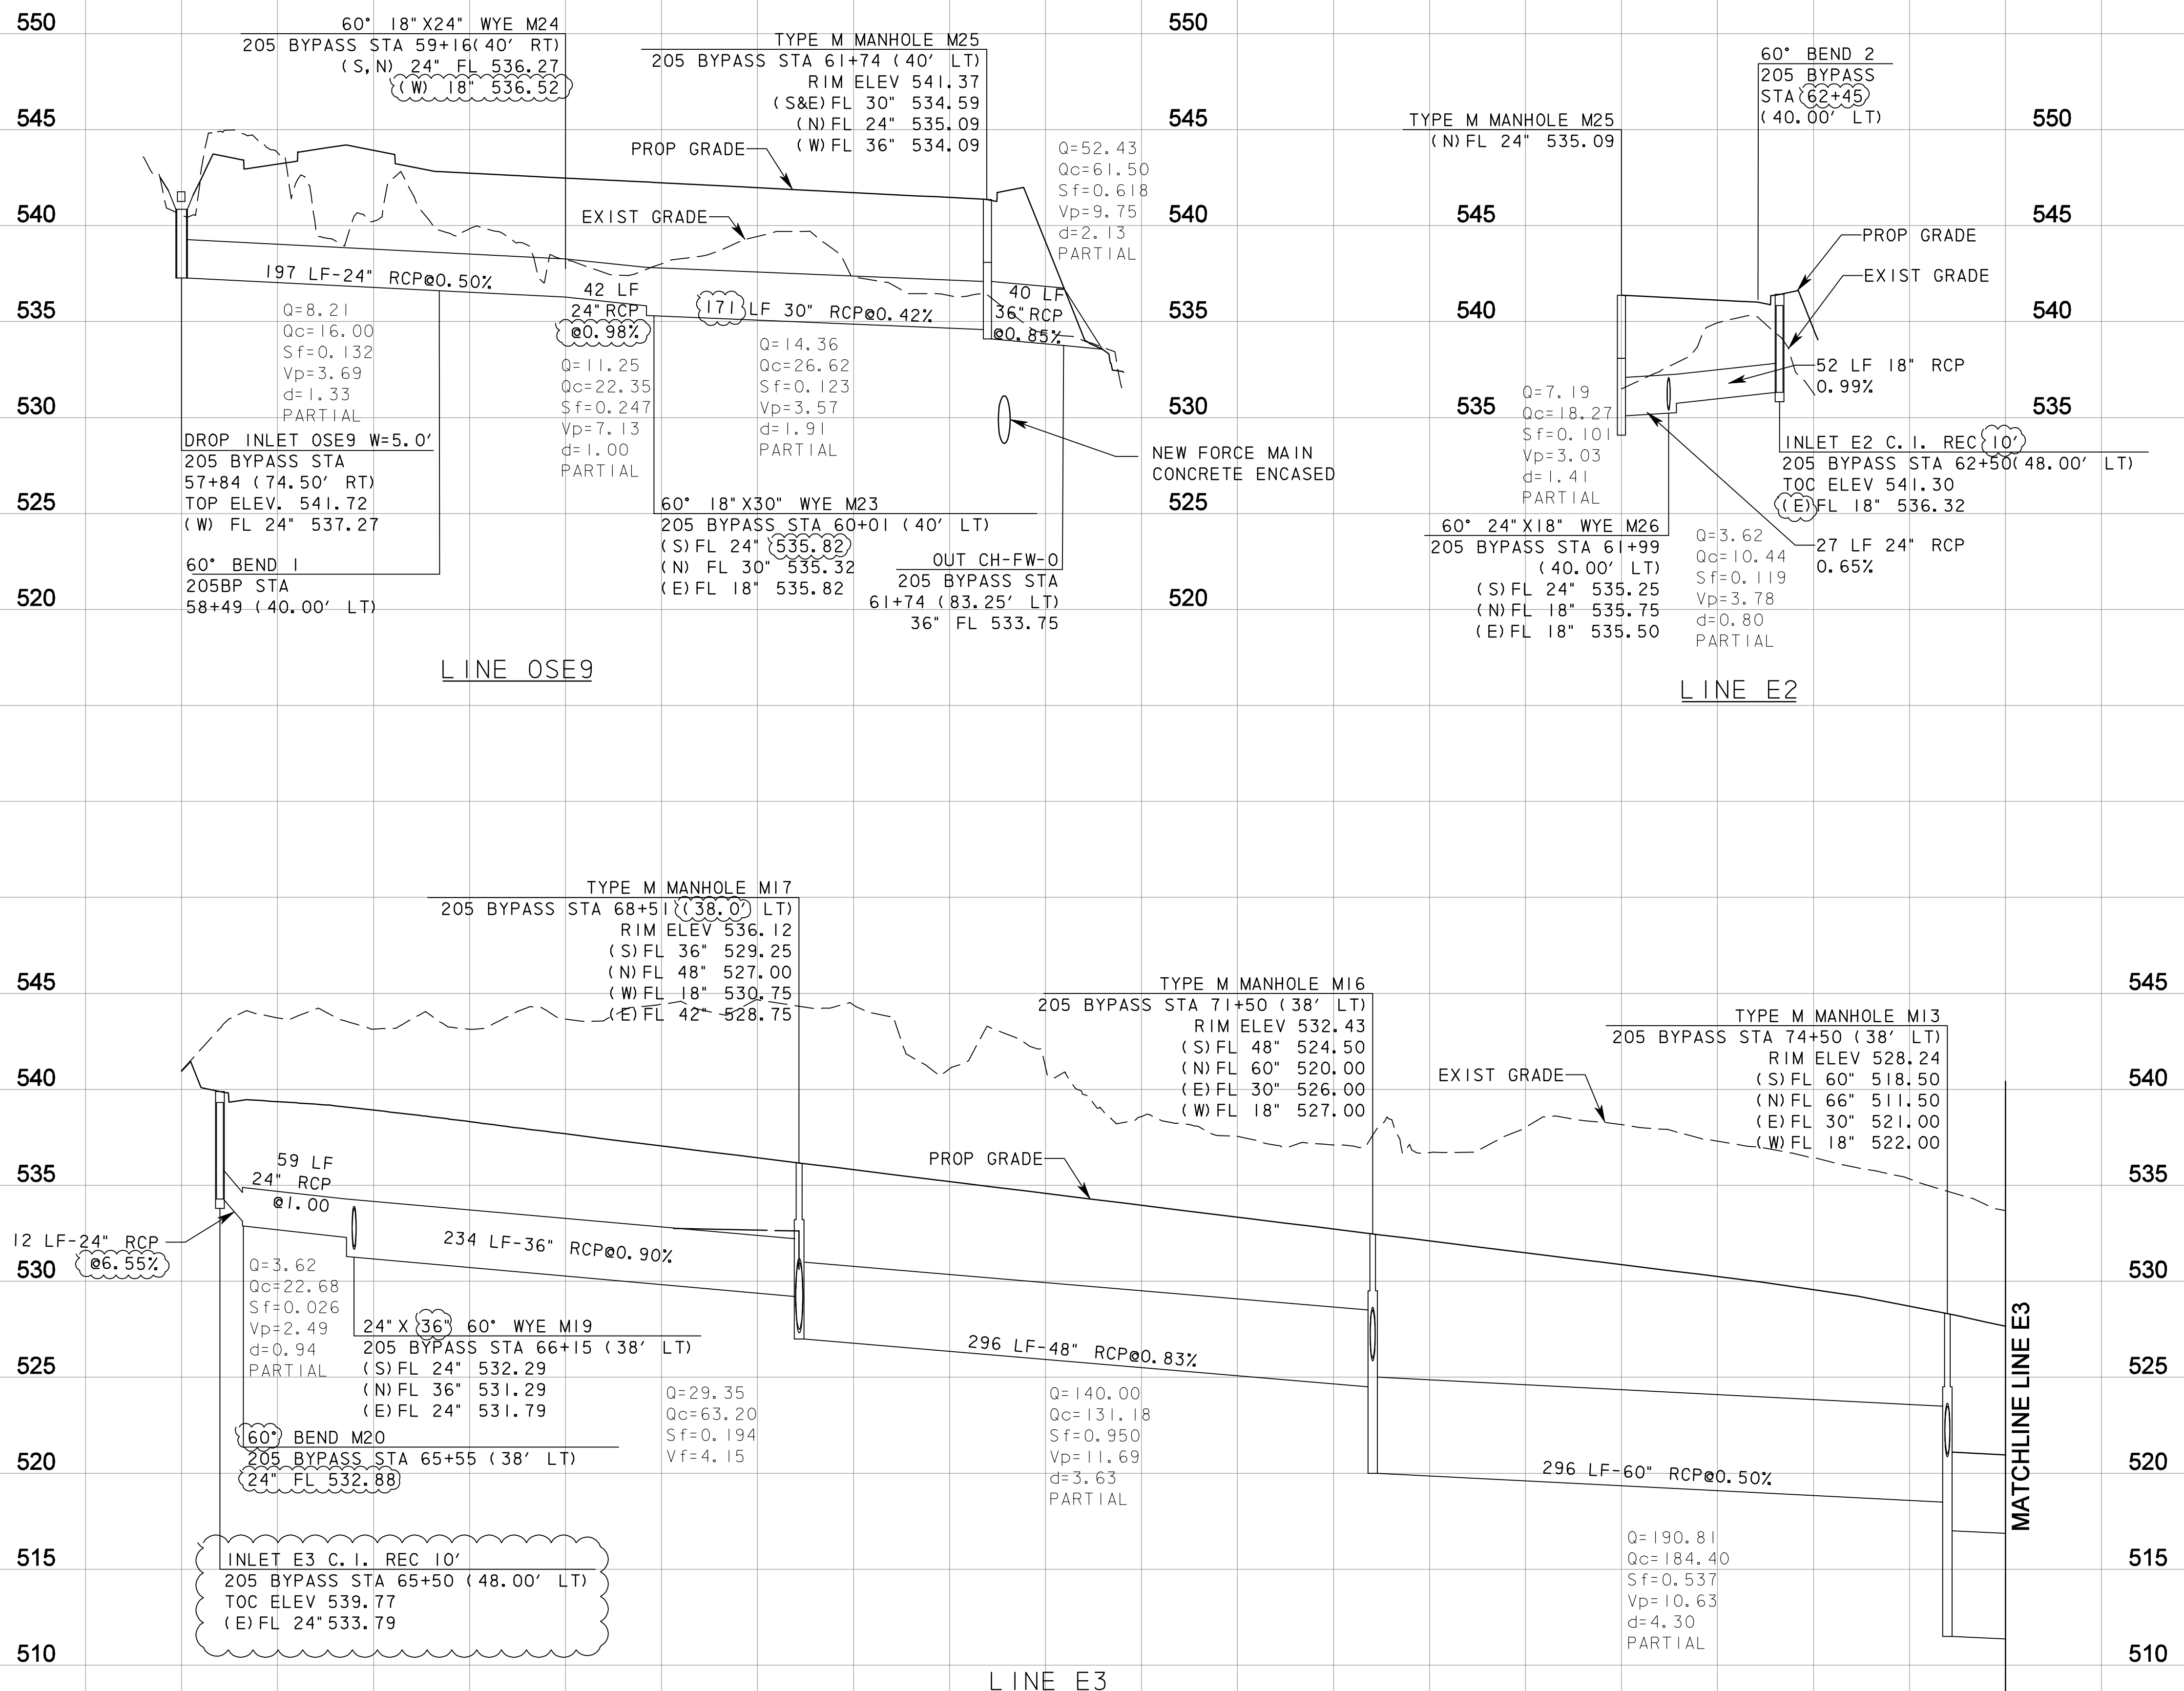

- NOTES:
1. FLOWLINE ELEVATIONS AND GRADES ARE CALCULATED FROM APPROPRIATE CENTER TO CENTER OF PROPOSED DRAINAGE STRUCTURES. PIPE LENGTHS ON PLANS ARE ACTUAL LENGTHS BETWEEN STRUCTURES AND ARE USED IN QUANTITY TAKEOFFS.
 2. ALL UTILITIES SHOWN ARE APPROXIMATE AND SHOULD BE FIELD VERIFIED AS TO THE LOCATION AND DEPTH PRIOR TO CONSTRUCTION.
 3. ALL STORM DRAIN PIPE IS CLASS III UNLESS OTHERWISE NOTED.
 4. THE CONTROL POINT FOR RECESSED CURB INLETS IS AT THE CENTER OF THE INLET AT THE FACE OF THE RECESSED CURB.
 5. INLET LIDS TO BE LOCKING.
 6. FOR WATER LINE AND FORCE MAIN ADJUSTMENTS SEE MISCELLANEOUS DRAINAGE DETAILS.

LEGEND

Q = FLOW RATE (CFS)
 Qc = FLOW CAPACITY (CFS)
 Sf = FRICTION SLOPE (%)
 V = VELOCITY (FPS)
 D = DEPTH (FT)

RECORD DRAWING

This drawing is a compilation of the original sealed engineering drawing and modifications by addenda, change orders and information furnished by the contractor. Information shown that was provided by the contractor and others not associated with the design engineer cannot be verified for accuracy or completeness. Original sealed drawing is on file at the office of AECOM USA Group, Inc., TBPE REG. NO. F-3082

ORIGINAL DRAWING SEALED & SIGNED BY
 T.H. Gaertner, P.E.
 TX NO. 37124

I		MISCELLANEOUS		THG	5/20/08
NO.	REVISION			BY	DATE
205 BYPASS PHASE 3					
STORM DRAIN PROFILE SYSTEM E					
2 OF 2					

TCB AECOM		TCB INC. WWW.TCB.AECOM.COM 17300 DALLAS PARKWAY, SUITE 1010 DALLAS, TEXAS 75248			
Unit	PW-DAL-FW	Scale	Horz: AS SHOWN Vert: AS SHOWN	Date	11/23/2009
Designed	SDB	Checked	TCB	Project No.	60004153
Drawn	FG	Approved	TCB	Sheet	93 of 215