


\\usdell1p001\pww\4328\60004153-205bypass\cadd\sheets\phase 3 - 1 30 to station sh 66\record drawing 10_7_09\1030\1111\Fee-03.dgn
 11/23/2009




UNDERGROUND UTILITIES

THE LOCATION OF EXISTING UTILITIES SHOWN ON THESE PLANS ARE APPROXIMATE AND BASED UPON DATA FURNISHED BY THE CITY OF ROCKWALL AND OTHER UTILITY OWNERS. IT IS THE RESPONSIBILITY OF THE CONTRACTOR TO LOCATE AND VERIFY ON-SITE THE UTILITIES THAT MAY CONFLICT WITH THE CONSTRUCTION.

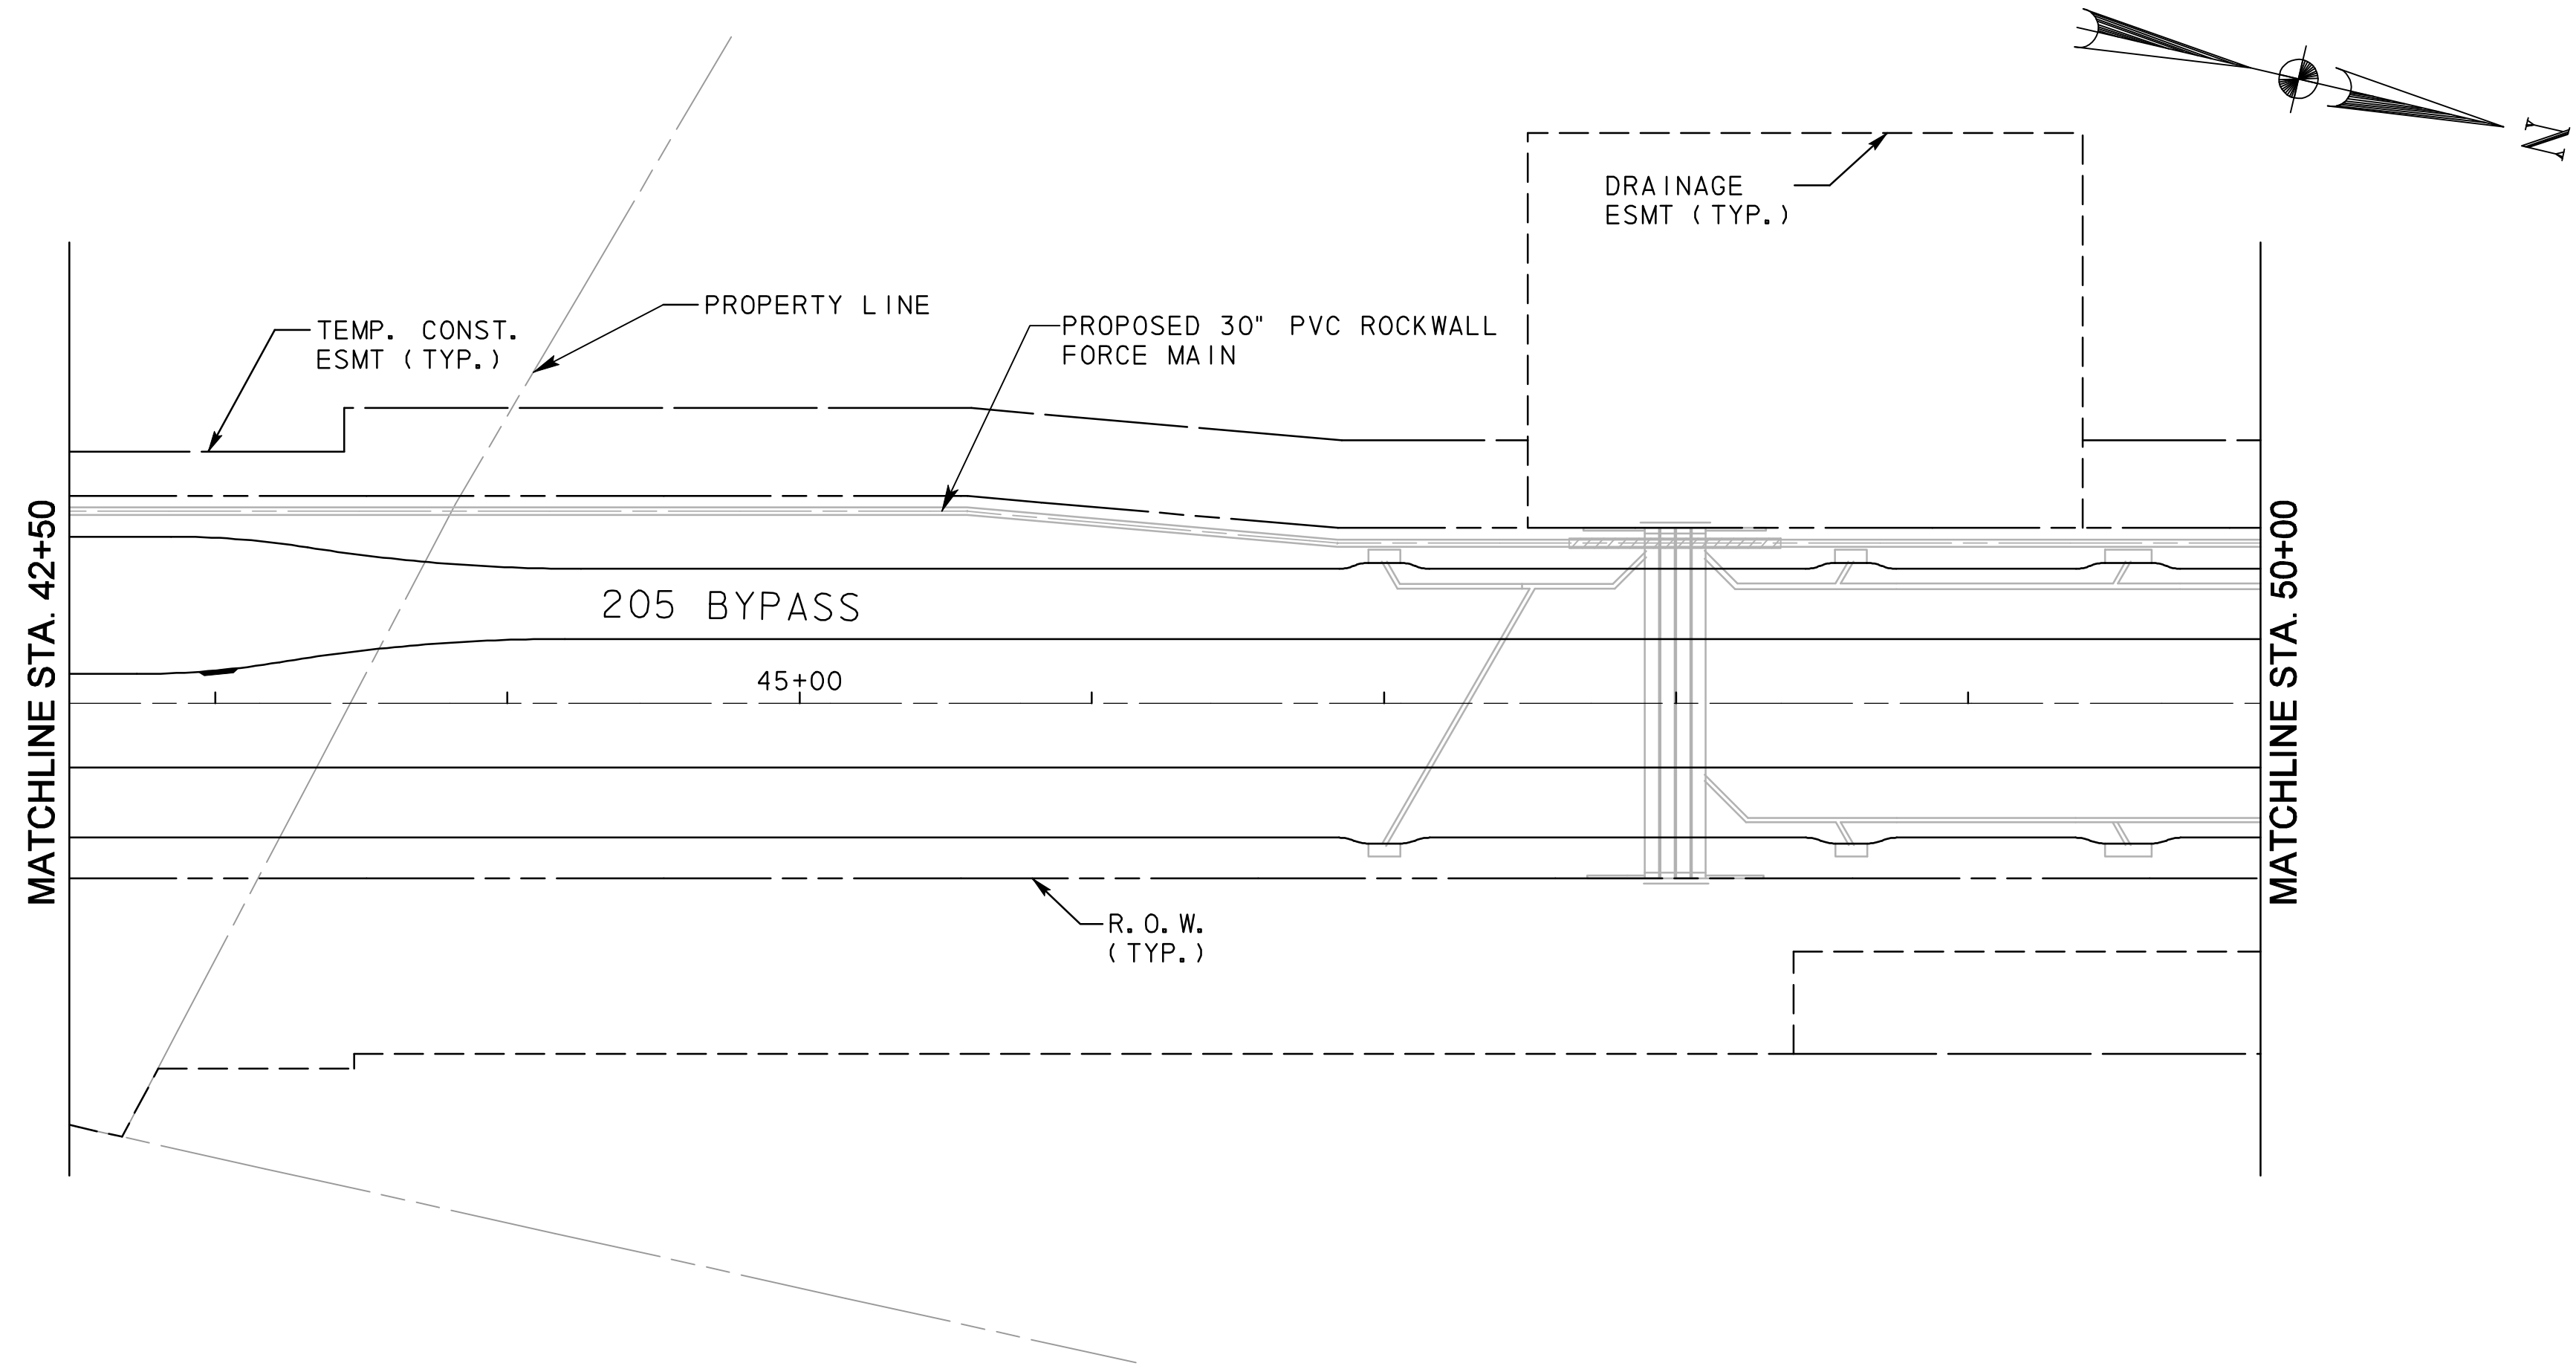

LEGEND

	PROPOSED ROW
	DRAINAGE EASEMENT
	TEMP CONSTRUCTION EASEMENT

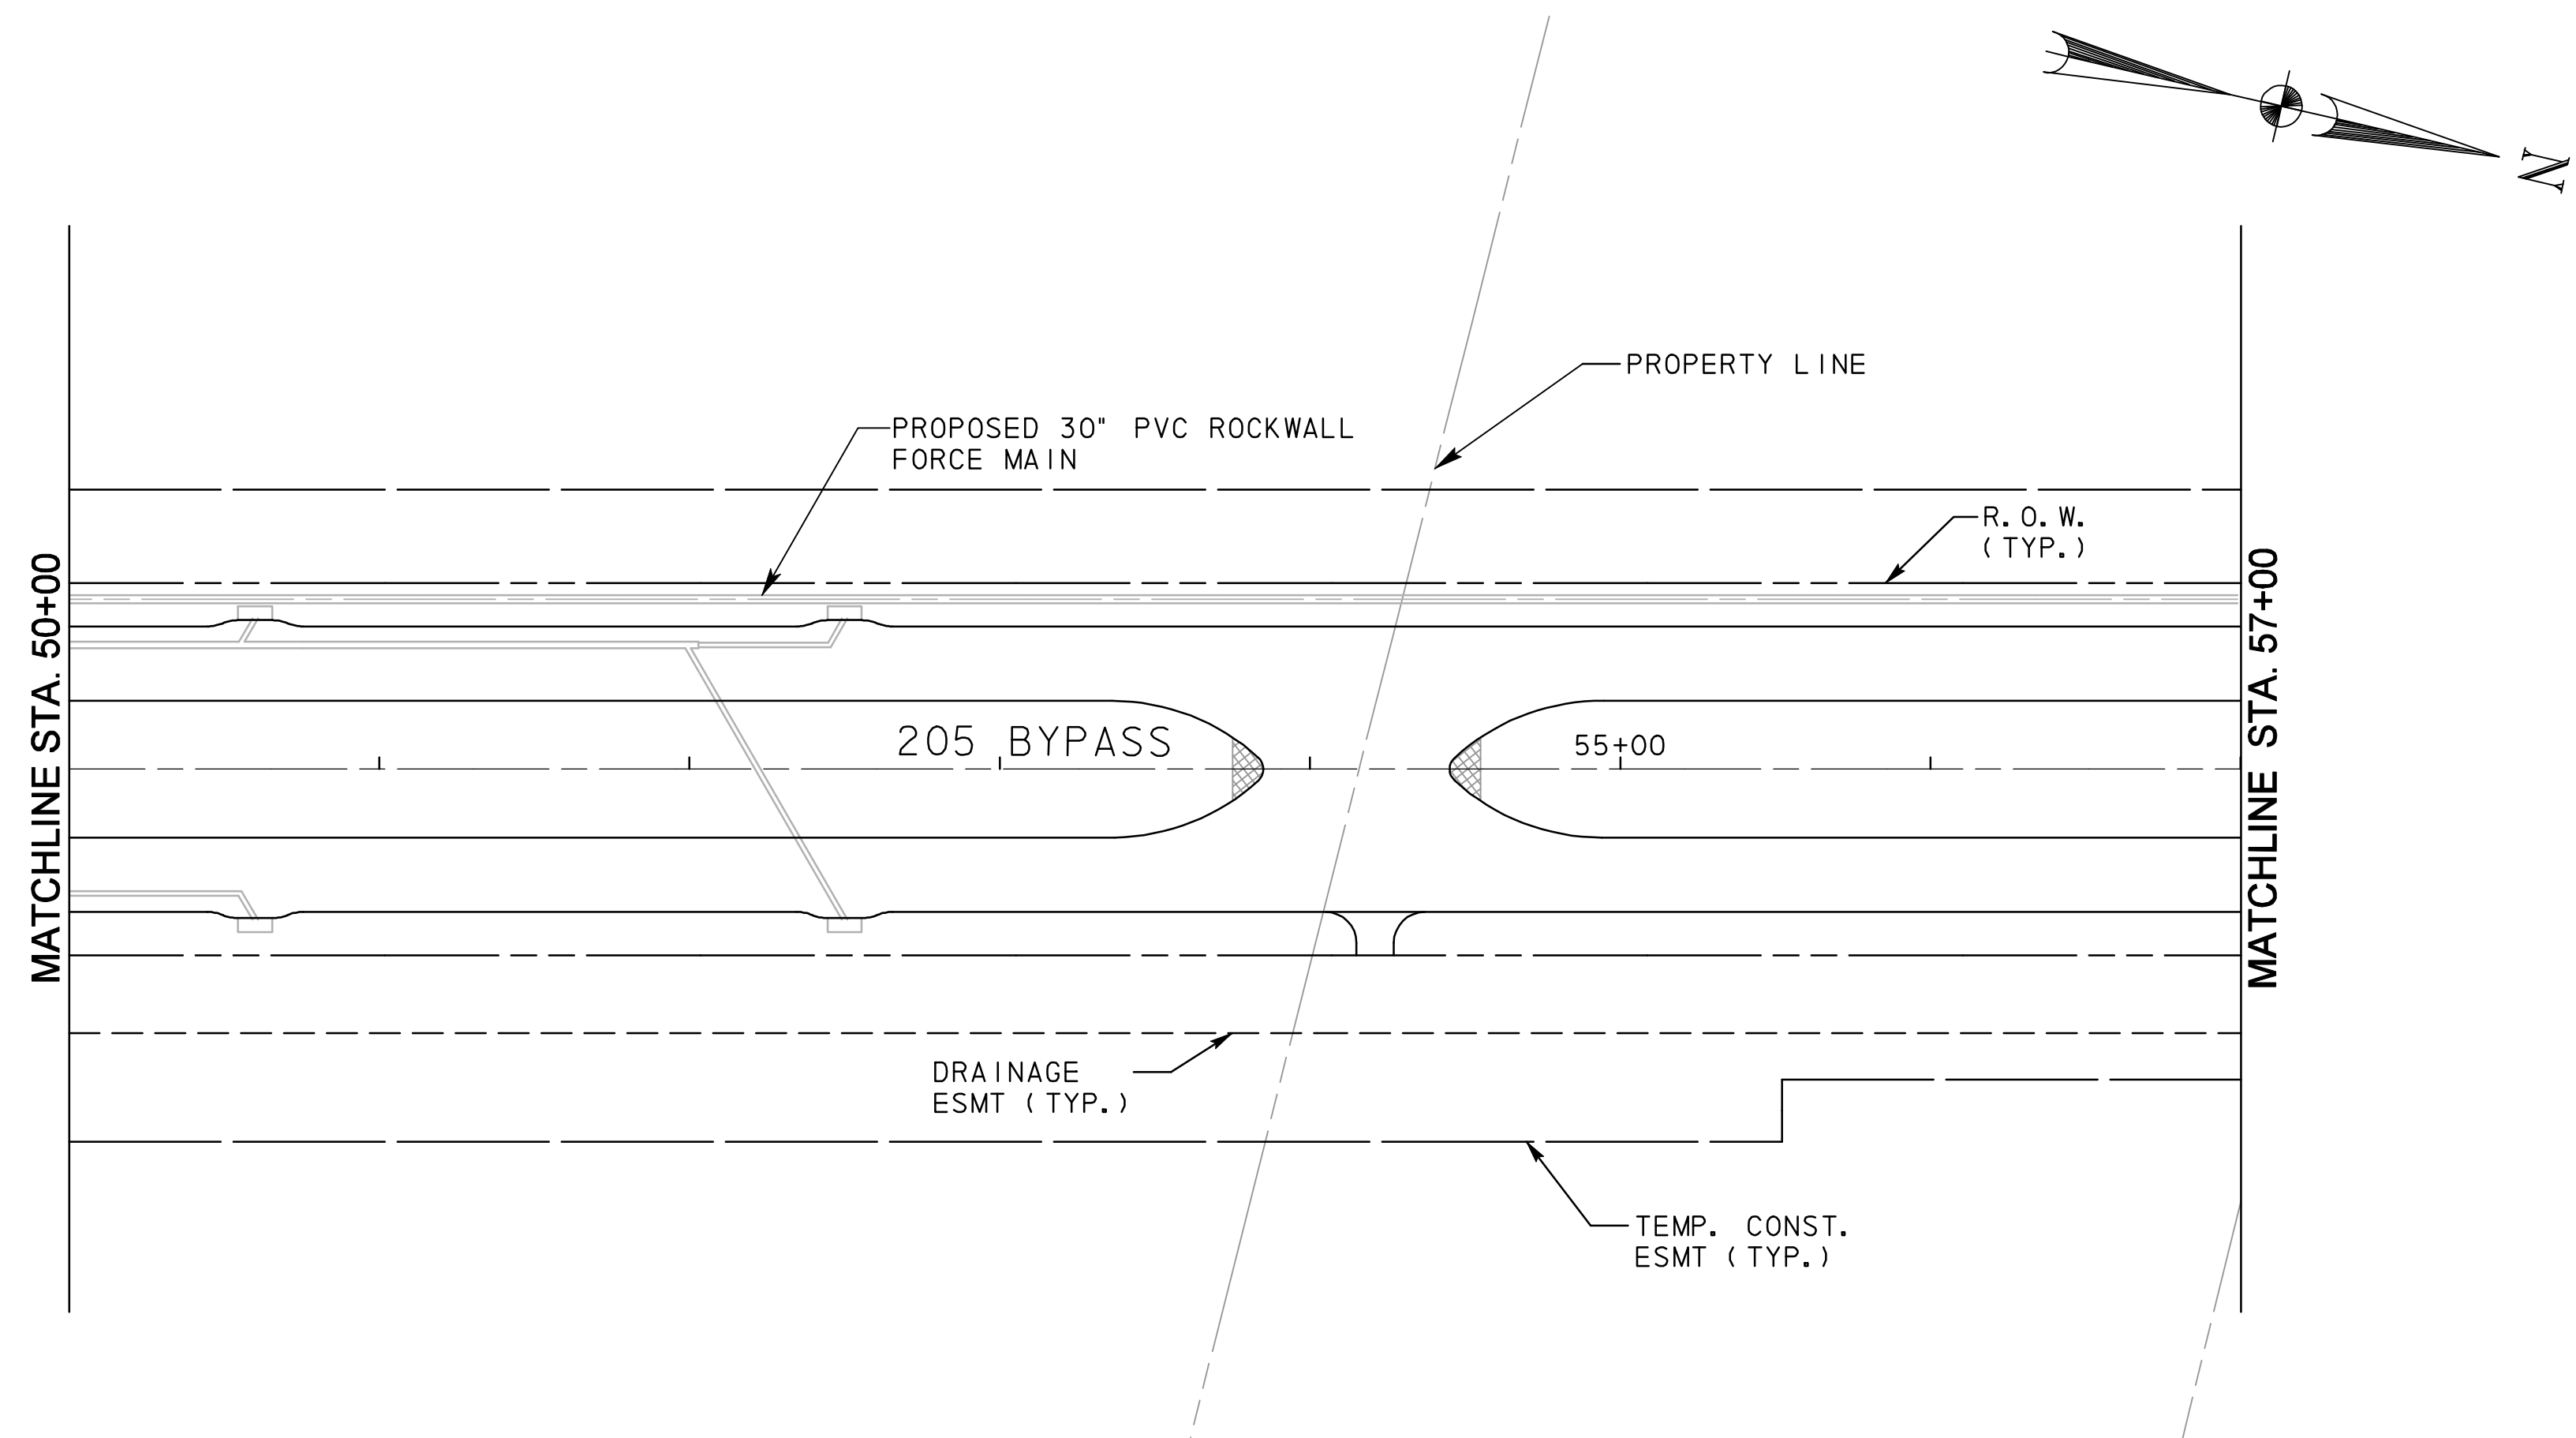

RECORD DRAWING

This drawing is a compilation of the original sealed engineering drawing and modifications by addenda, change orders and information furnished by the contractor. Information shown that was provided by the contractor and others not associated with the design engineer cannot be verified for accuracy or completeness. Original sealed drawing is on file at the office of AECOM USA Group, Inc., TBPE REG. NO. F-3082

ORIGINAL DRAWING SEALED & SIGNED BY
 T.H. Gaertner, P.E.
 TX NO. 37124

NO.	REVISION	BY	DATE

City of Rockwall, Texas

**205 BYPASS
 PHASE 3**

**UTILITIES LAYOUT
 STA. 42+50 TO STA. 57+00**

TCB	AECOM	TCB INC. WWW.TCB.AECOM.COM 17300 DALLAS PARKWAY, SUITE 1010 DALLAS, TEXAS 75248
------------	--------------	--

Unit	PW-DAL-FW	Scale	Horz: AS SHOWN Vert: AS SHOWN	Date	11/23/2009
Designed	THG	Checked	TCB	Project No.	60004153
Drawn	FG	Approved	TCB	Sheet	103 of 215