


**UNDERGROUND UTILITIES**

THE LOCATION OF EXISTING UTILITIES SHOWN ON THESE PLANS ARE APPROXIMATE AND BASED UPON DATA FURNISHED BY THE CITY OF ROCKWALL AND OTHER UTILITY OWNERS. IT IS THE RESPONSIBILITY OF THE CONTRACTOR TO LOCATE AND VERIFY ON-SITE THE UTILITIES THAT MAY CONFLICT WITH THE CONSTRUCTION.

**LEGEND**

	PROPOSED ROW
	DRAINAGE EASEMENT
	TEMP CONSTRUCTION EASEMENT

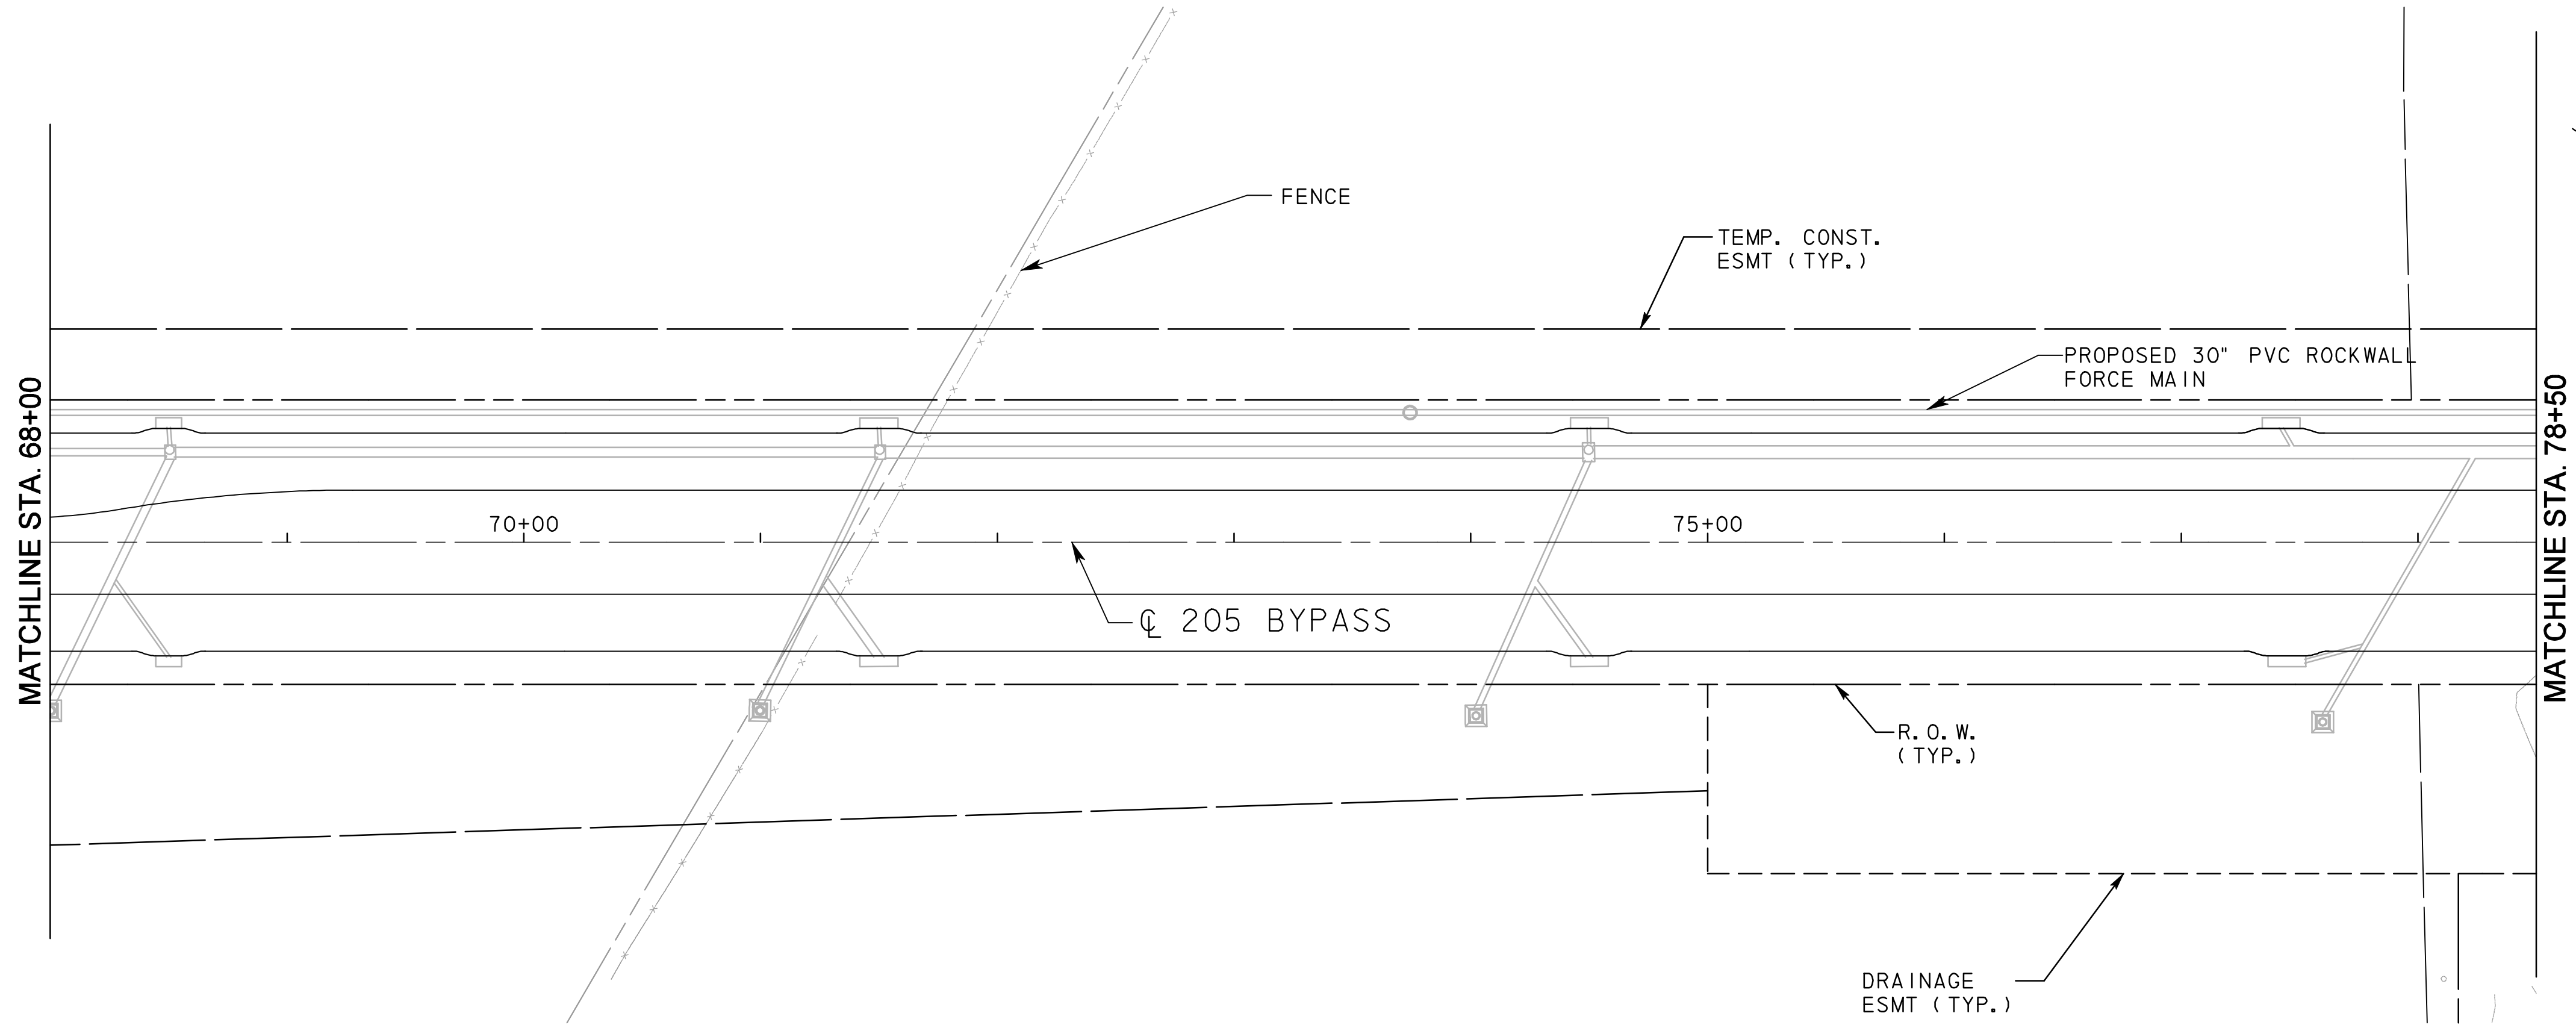

**RECORD DRAWING**

This drawing is a compilation of the original sealed engineering drawing and modifications by addenda, change orders and information furnished by the contractor. Information shown that was provided by the contractor and others not associated with the design engineer cannot be verified for accuracy or completeness. Original sealed drawing is on file at the office of AECOM USA Group, Inc., TBPE REG. NO. F-3082

ORIGINAL DRAWING SEALED & SIGNED BY  
 T.H. Gaertner, P.E.  
 TX NO. 37124

NO.	REVISION	BY	DATE

**City of Rockwall, Texas**

**205 BYPASS  
 PHASE 3**

**UTILITIES LAYOUT  
 STA. 57+00 TO STA. 78+50**

<b>TCB   AECOM</b>		TCB INC. WWW.TCB.AECOM.COM 17300 DALLAS PARKWAY, SUITE 1010 DALLAS, TEXAS 75248	
Unit	PW-DAL-FW	Scales	Horz: AS SHOWN Vert: AS SHOWN
Designed	THG	Checked	TCB
Drawn	FG	Approved	TCB
Date	11/23/2009	Project No.	60004153
Sheet	104	of	215

\\ussdell\p001\pww\4328\60004153-205bypass\cadd\sheet\phase 3 - 1 30 to station sh 66\record drawing 10\_7\_09\104U111\Fes-04.dgn  
 11/23/2009