


**UNDERGROUND UTILITIES**

THE LOCATION OF EXISTING UTILITIES SHOWN ON THESE PLANS ARE APPROXIMATE AND BASED ON DATA FURNISHED BY THE CITY OF ROCKWALL. IT IS THE RESPONSIBILITY OF THE CONTRACTOR TO LOCATE AND VERIFY ON-SITE THE UTILITIES THAT MAY CONFLICT WITH THE CONSTRUCTION.

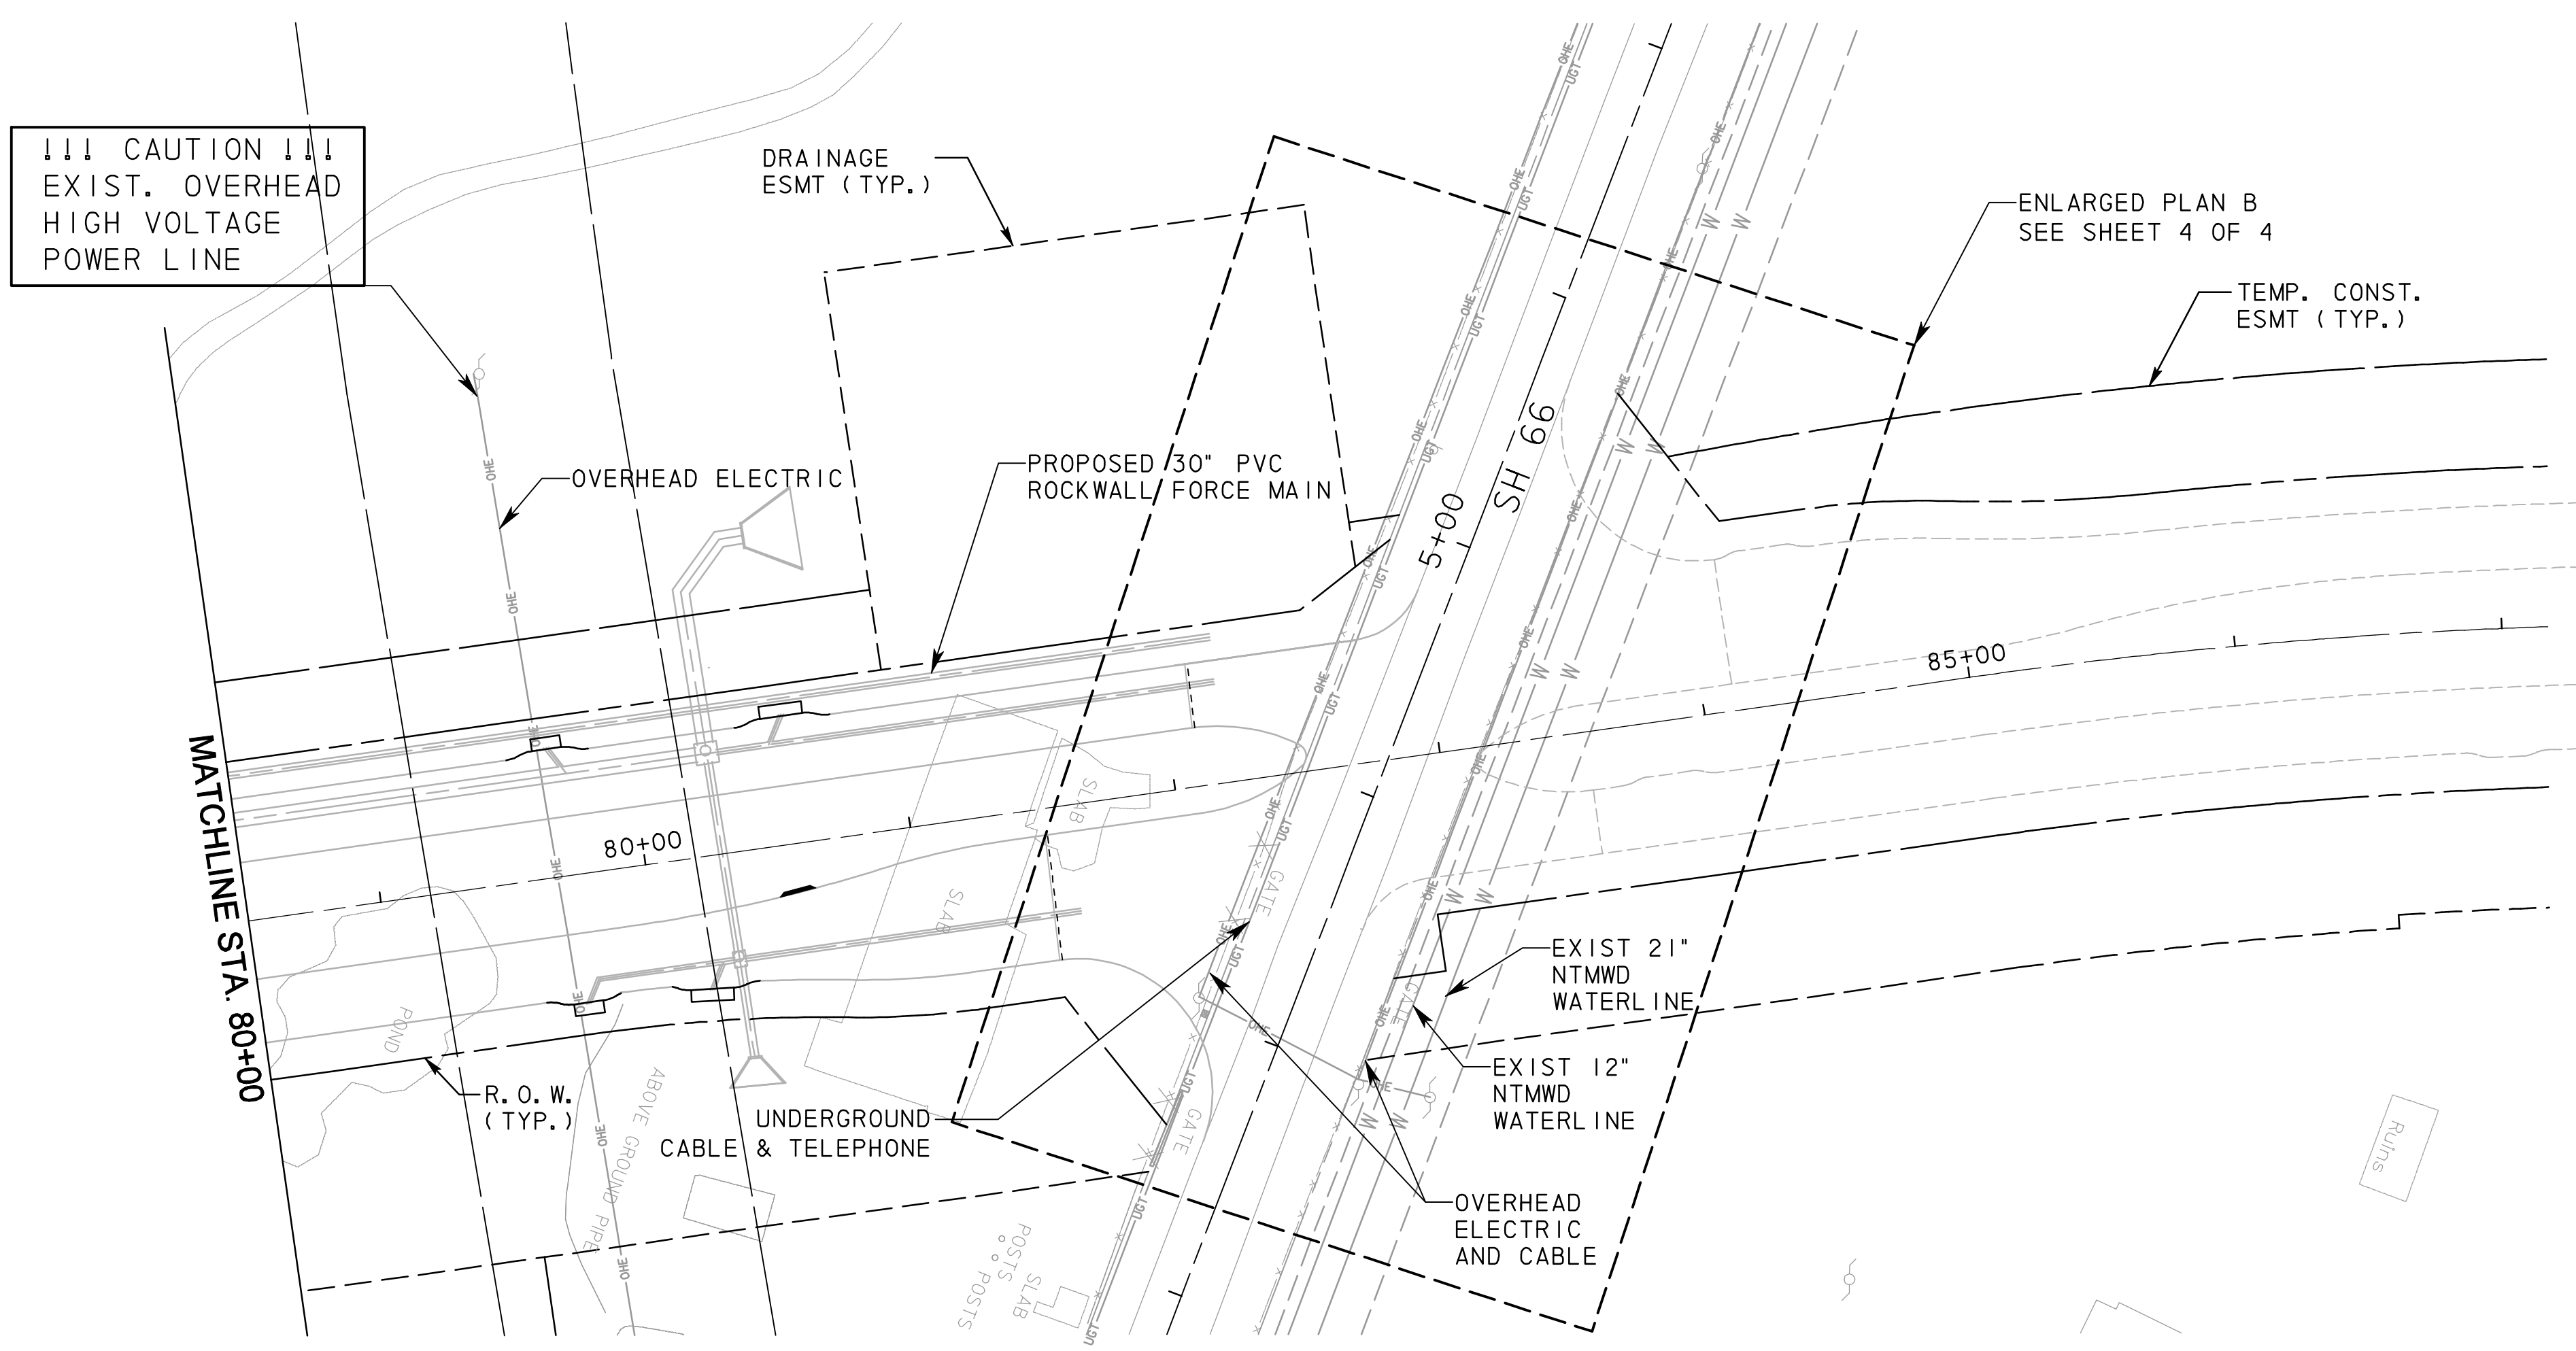

**LEGEND**

- PROPOSED ROW
- - - - - DRAINAGE EASEMENT
- - - - - TEMP CONSTRUCTION EASEMENT

**RECORD DRAWING**

This drawing is a compilation of the original sealed engineering drawing and modifications by addenda, change orders and information furnished by the contractor. Information shown that was provided by the contractor and others not associated with the design engineer cannot be verified for accuracy or completeness. Original sealed drawing is on file at the office of AECOM USA Group, Inc., TBPE REG. NO. F-3082

ORIGINAL DRAWING  
SEALED & SIGNED BY  
**T.H. Gaertner, P.E.**  
TX NO. 37124

NO.	REVISION	BY	DATE

 **City of Rockwall, Texas**

**205 BYPASS  
PHASE 3**

**UTILITIES LAYOUT  
STA. 80+00 TO STA. 83+00**

**TCB | AECOM**  
TCB INC.  
WWW.TCB.AECOM.COM  
17300 DALLAS PARKWAY, SUITE 1010  
DALLAS, TEXAS 75248

Unit	PW-DAL-FW	Scale	Horz: AS SHOWN Vert: AS SHOWN	Date	11/23/2009
Designed	SDB	Checked	TCB	Project No.	60004153
Drawn	TCB	Approved	TCB	Sheet	105 of 215

\\usdd11p001\pww\4328\60004153-205bypass\cadd\sheet\phase 3 - 1 30 to station.sh 66\record drawing 10\_7\_09\105U\111\Fee-05.dgn  
 11/23/2009