
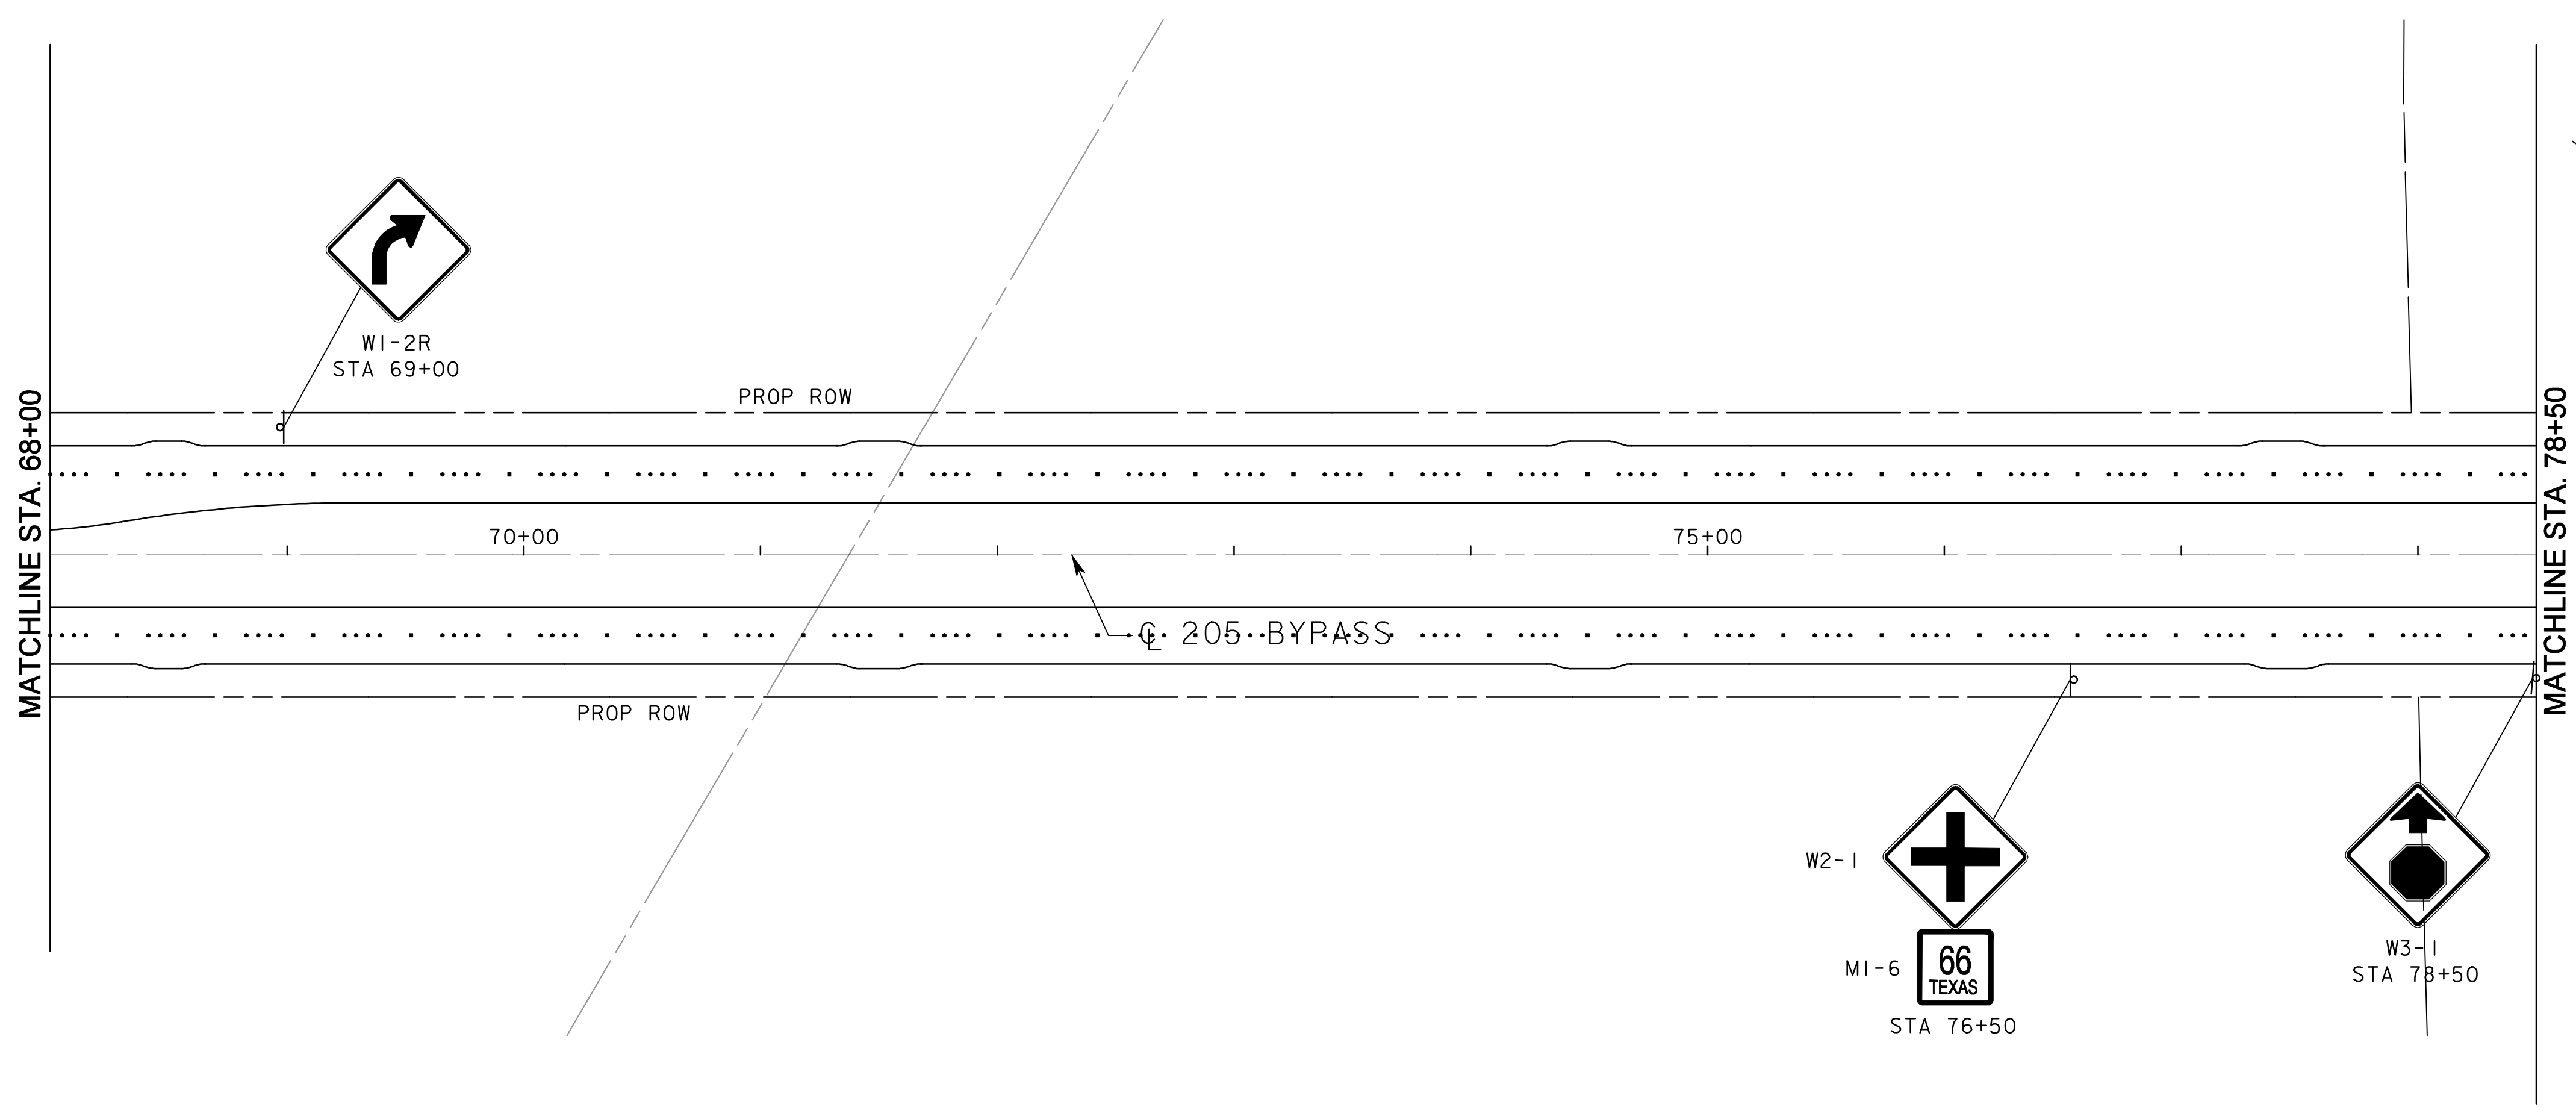


LEGEND

- (A) 4" WHITE SOLID
- (B) WHITE BUTTON TYPE LANE LINE
- (C) WHITE BUTTON TURN BAY LINE.
- (D) 4" YELLOW SOLID
- (E) 4" DOUBLE YELLOW SOLID
- (F) 24" WHITE STOP BAR
- (G) "ONLY" WHITE
- (H) WHITE LEFT TURN ARROW
- (I) WHITE RIGHT TURN ARROW
- (J) 12" WHITE SOLID
- (K) 12" YELLOW SOLID
- (L) WHITE ARROW

NOTE:

SEE MISC. ROADWAY DETAIL SHEET
2 OF 2 FOR MORE PAVEMENT MARKINGS
DETAILS.

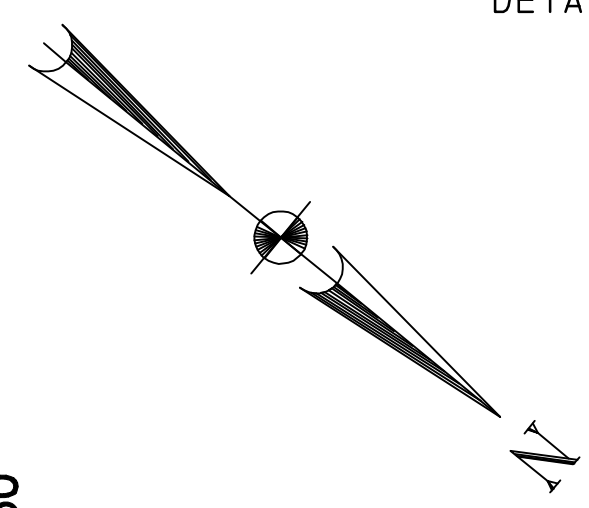

RECORD DRAWING

This drawing is a compilation of the original sealed engineering drawing and modifications by addenda, change orders and information furnished by the contractor. Information shown that was provided by the contractor and others not associated with the design engineer cannot be verified for accuracy or completeness. Original sealed drawing is on file at the office of AECOM USA Group, Inc., TBPE REG. NO. F-3082

ORIGINAL DRAWING
SEALED & SIGNED BY
T.H. Gaertner, P.E.
TX NO. 37124

| NO. | REVISION | BY | DATE |
|---|------------|--|----------------------------------|
| | | | |
| | | | |
| | | | |
| | | | |
| 205 BYPASS PHASE 3 | | | |
| PAVEMENT MARKINGS & SIGNING STA. 57+00 TO STA. 78+50 | | | |
| TCB AECOM | | <small>TCB INC. WWW.TCB.AECOM.COM 17300 DALLAS PARKWAY, SUITE 1010 DALLAS, TEXAS 75248</small> | |
| Unit | PW-DAL-FW | Scale | Horz: AS SHOWN Vert: AS SHOWN |
| Designed | THG | Checked | TCB |
| Drawn | FG | Approved | TCB |
| Date | 11/23/2009 | Project No. | 60004153 |
| Sheet | 120 | of | 215 |

\\ussd\l1p001\pww4328\60004153-205bypass\cadd\sheets\phase 3 - 1 30 to station sh 66\record drawing 10_7_09\120PvmMk-04.dgn
 11/23/2009