
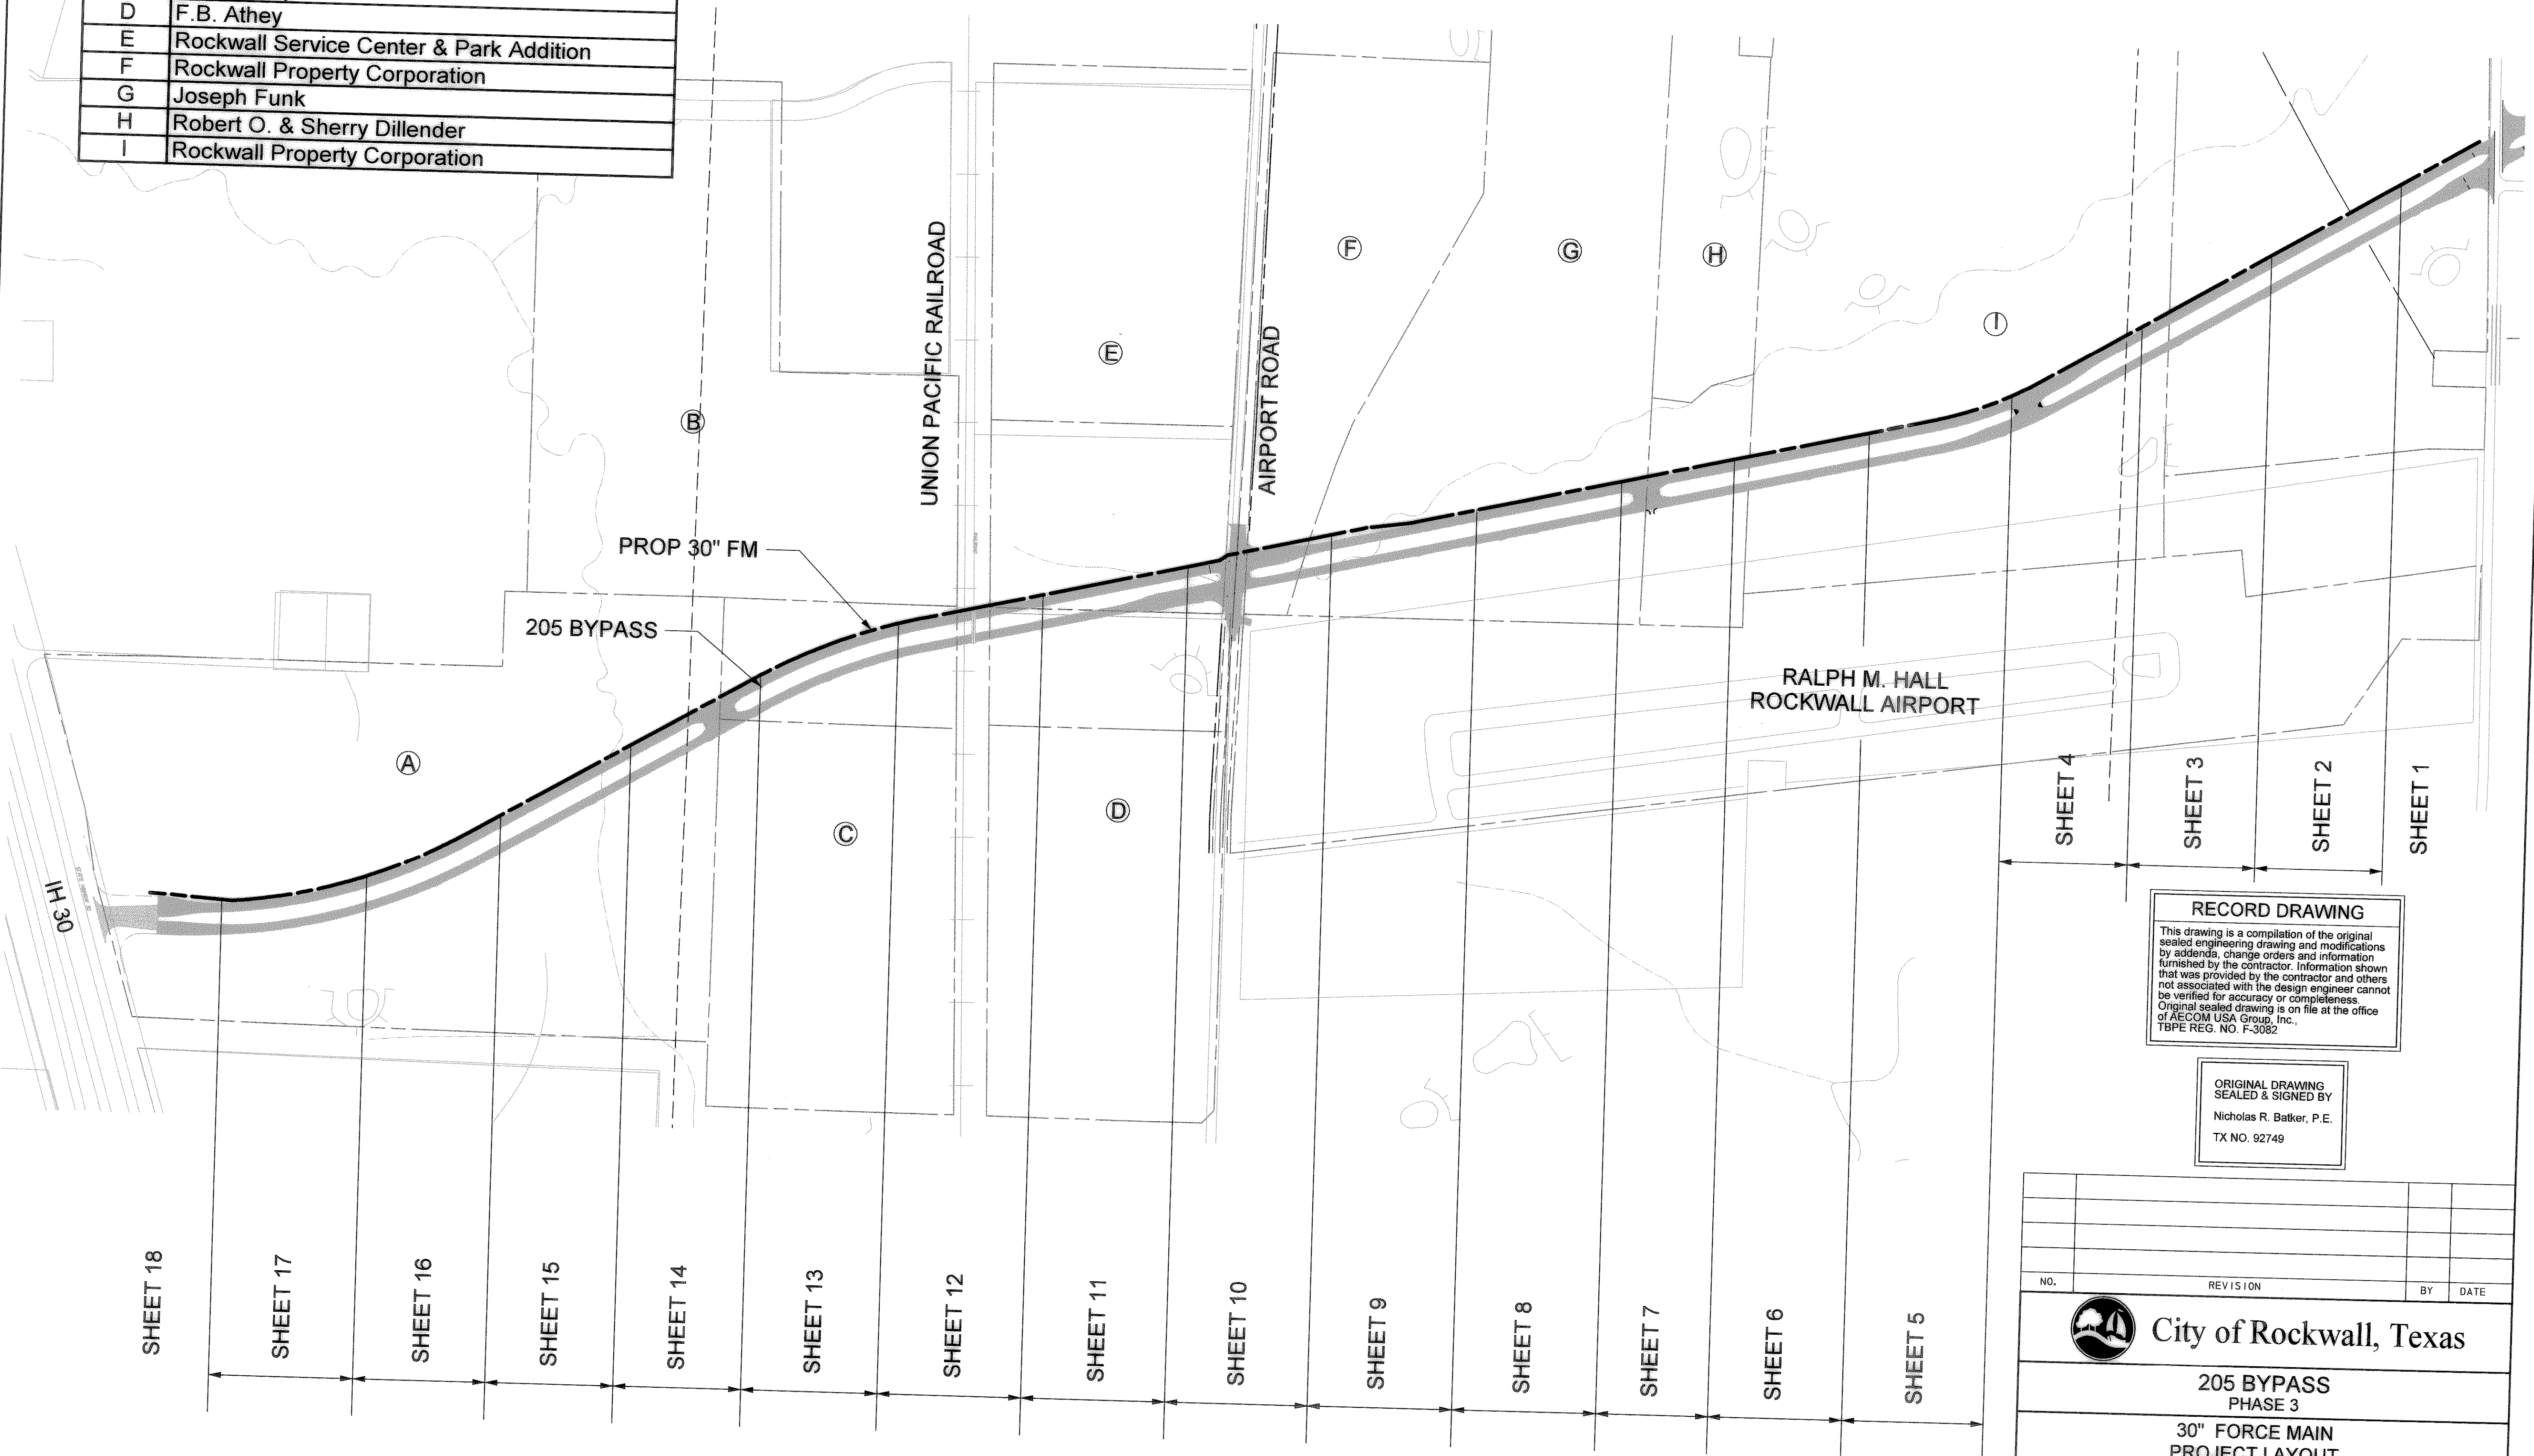


Parcel	Owner Name
A	Petar and Cvijeta Temunovic
B	Rockwall Economic Development Corporation
C	Ruby Athey
D	F.B. Athey
E	Rockwall Service Center & Park Addition
F	Rockwall Property Corporation
G	Joseph Funk
H	Robert O. & Sherry Dillender
I	Rockwall Property Corporation

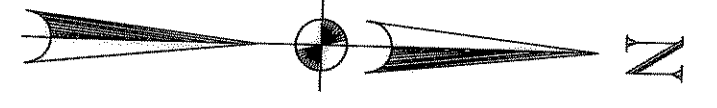

RECORD DRAWING
 This drawing is a compilation of the original sealed engineering drawing and modifications by addenda, change orders and information furnished by the contractor. Information shown that was provided by the contractor and others not associated with the design engineer cannot be verified for accuracy or completeness. Original sealed drawing is on file at the office of AECOM USA Group, Inc., TBPE REG. NO. F-3082

ORIGINAL DRAWING
 SEALED & SIGNED BY
 Nicholas R. Barker, P.E.
 TX NO. 92749

NO.	REVISION	BY	DATE

City of Rockwall, Texas

**205 BYPASS
 PHASE 3
 30" FORCE MAIN
 PROJECT LAYOUT
 SHEET INDEX**

TCB | AECOM
 TCB INC.
 WWW.TCB.AECOM.COM
 17300 DALLAS PARKWAY, SUITE 1010
 DALLAS, TEXAS 75248

Unit#	PW-DAL-FW	Scale:	Horz: 1:40 Vert: 1:10	Date	11/16/2009
Designed	JLT/SDB	Checked	NRB	Project No.	60023784
Drawn	TCB	Approved	NRB	Sheet	128 of 215

11/16/2009 3:56:58 PM
 \\usda111fd001\pww\4328\60004153-205Bypass\CADD\Sheet\Phase 3 - I 30 to Station SH 66\Record Drawing 10_7_09\28Project_Layout.dgn