
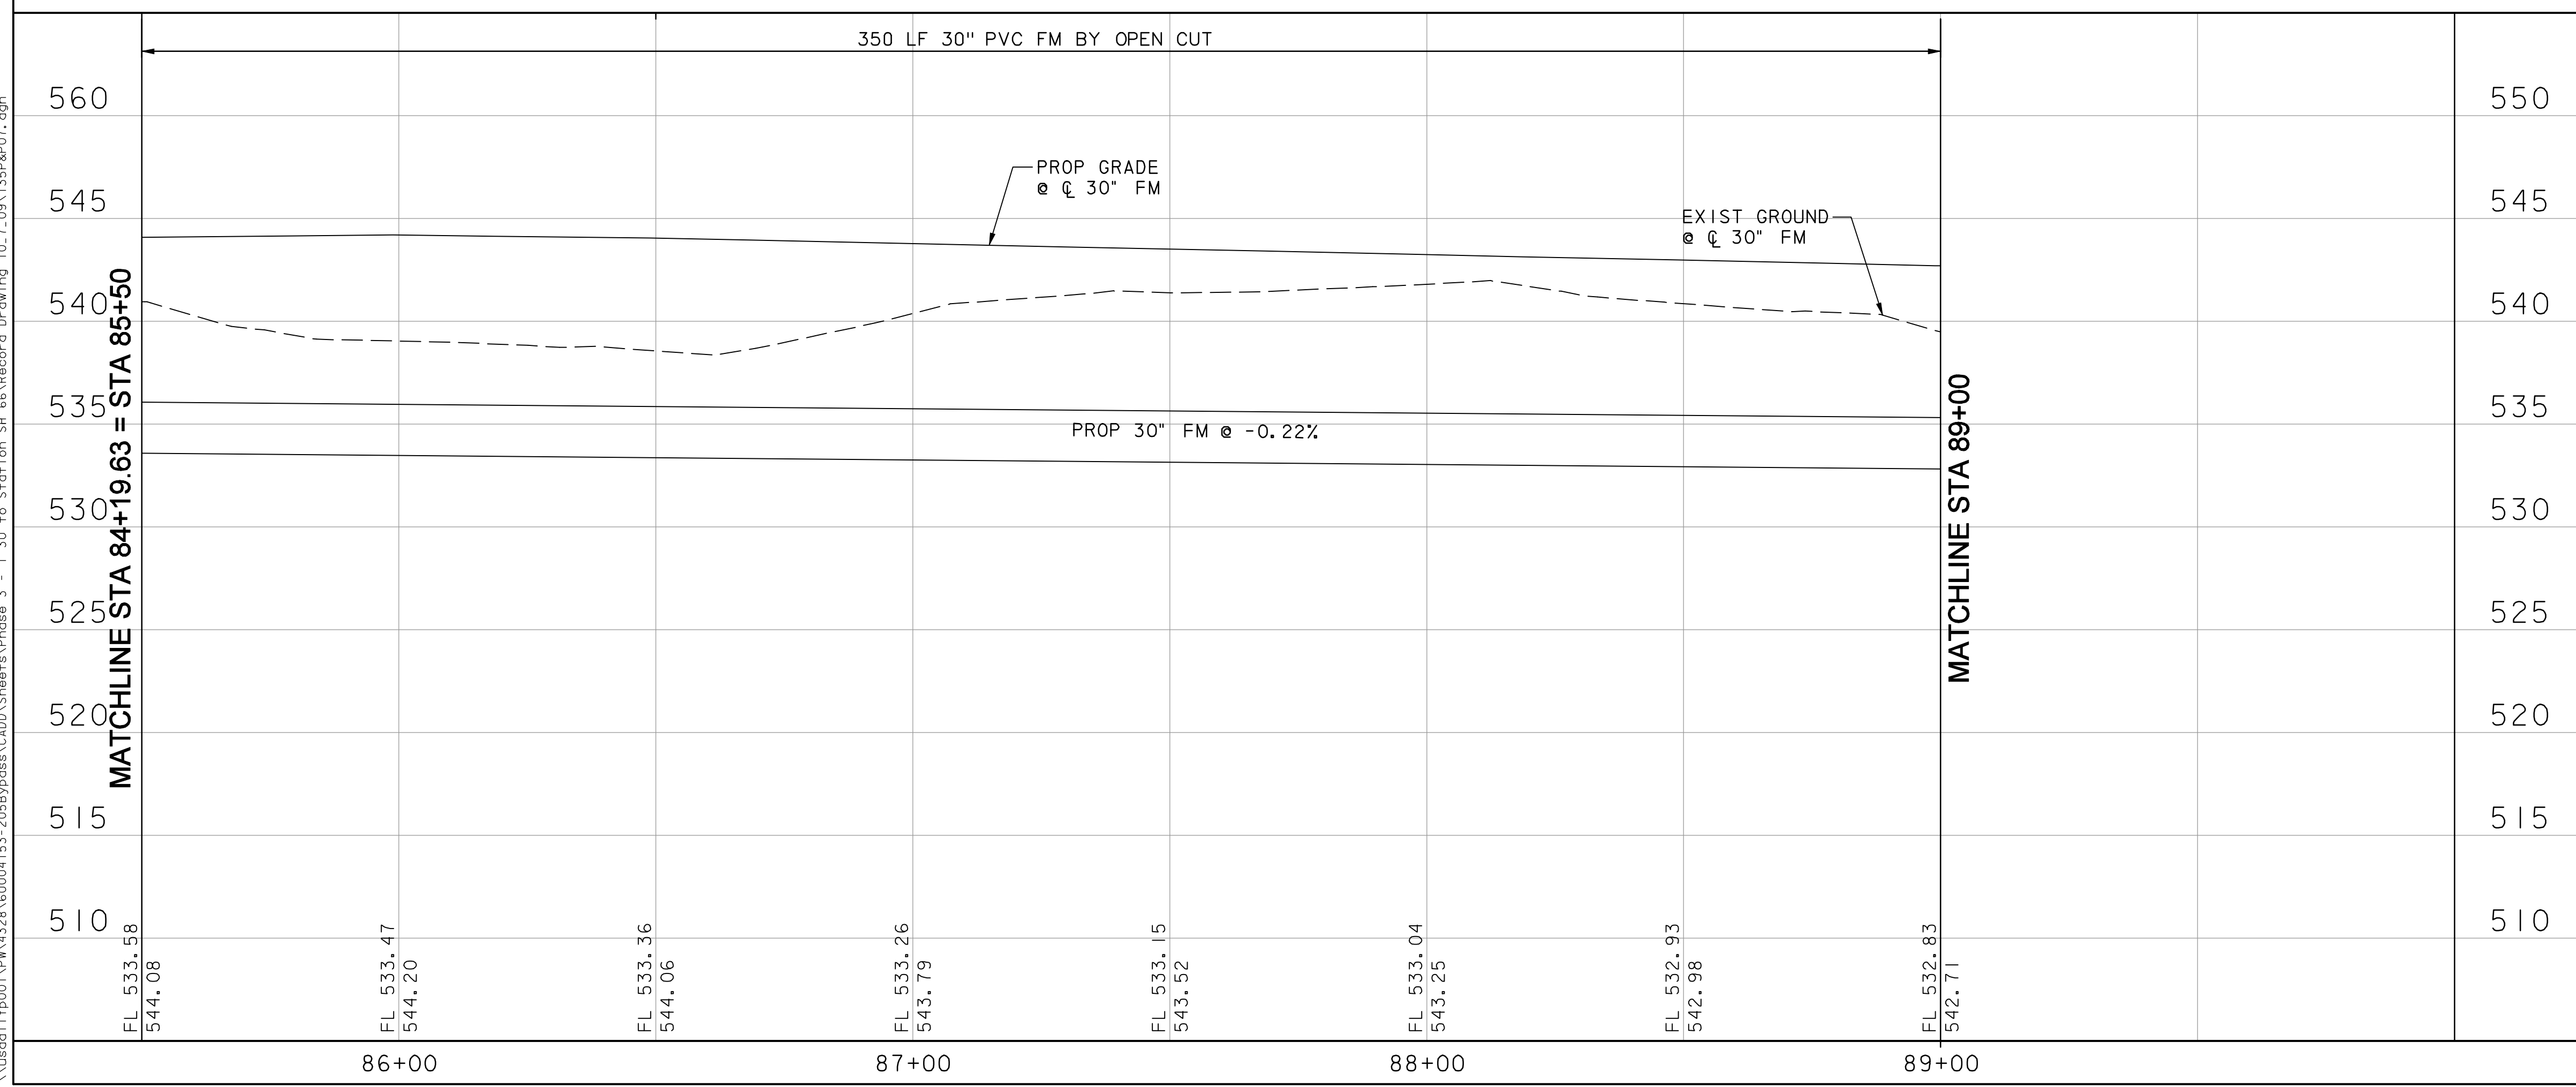


**LEGEND**

- RIGHT-OF-WAY -----
- DRAINAGE EASEMENT -----
- TEMP. CONSTRUCTION EASEMENT -----
- 205 BYPASS PAVING [Shaded Area]

**UNDERGROUND UTILITIES**

THE LOCATION OF EXISTING UTILITIES SHOWN ON THESE PLANS ARE APPROXIMATE AND BASED ON DATA FURNISHED BY THE CITY OF ROCKWALL. IT IS THE RESPONSIBILITY OF THE CONTRACTOR TO LOCATE AND VERIFY ON-SITE THE UTILITIES THAT MAY CONFLICT WITH THE CONSTRUCTION.

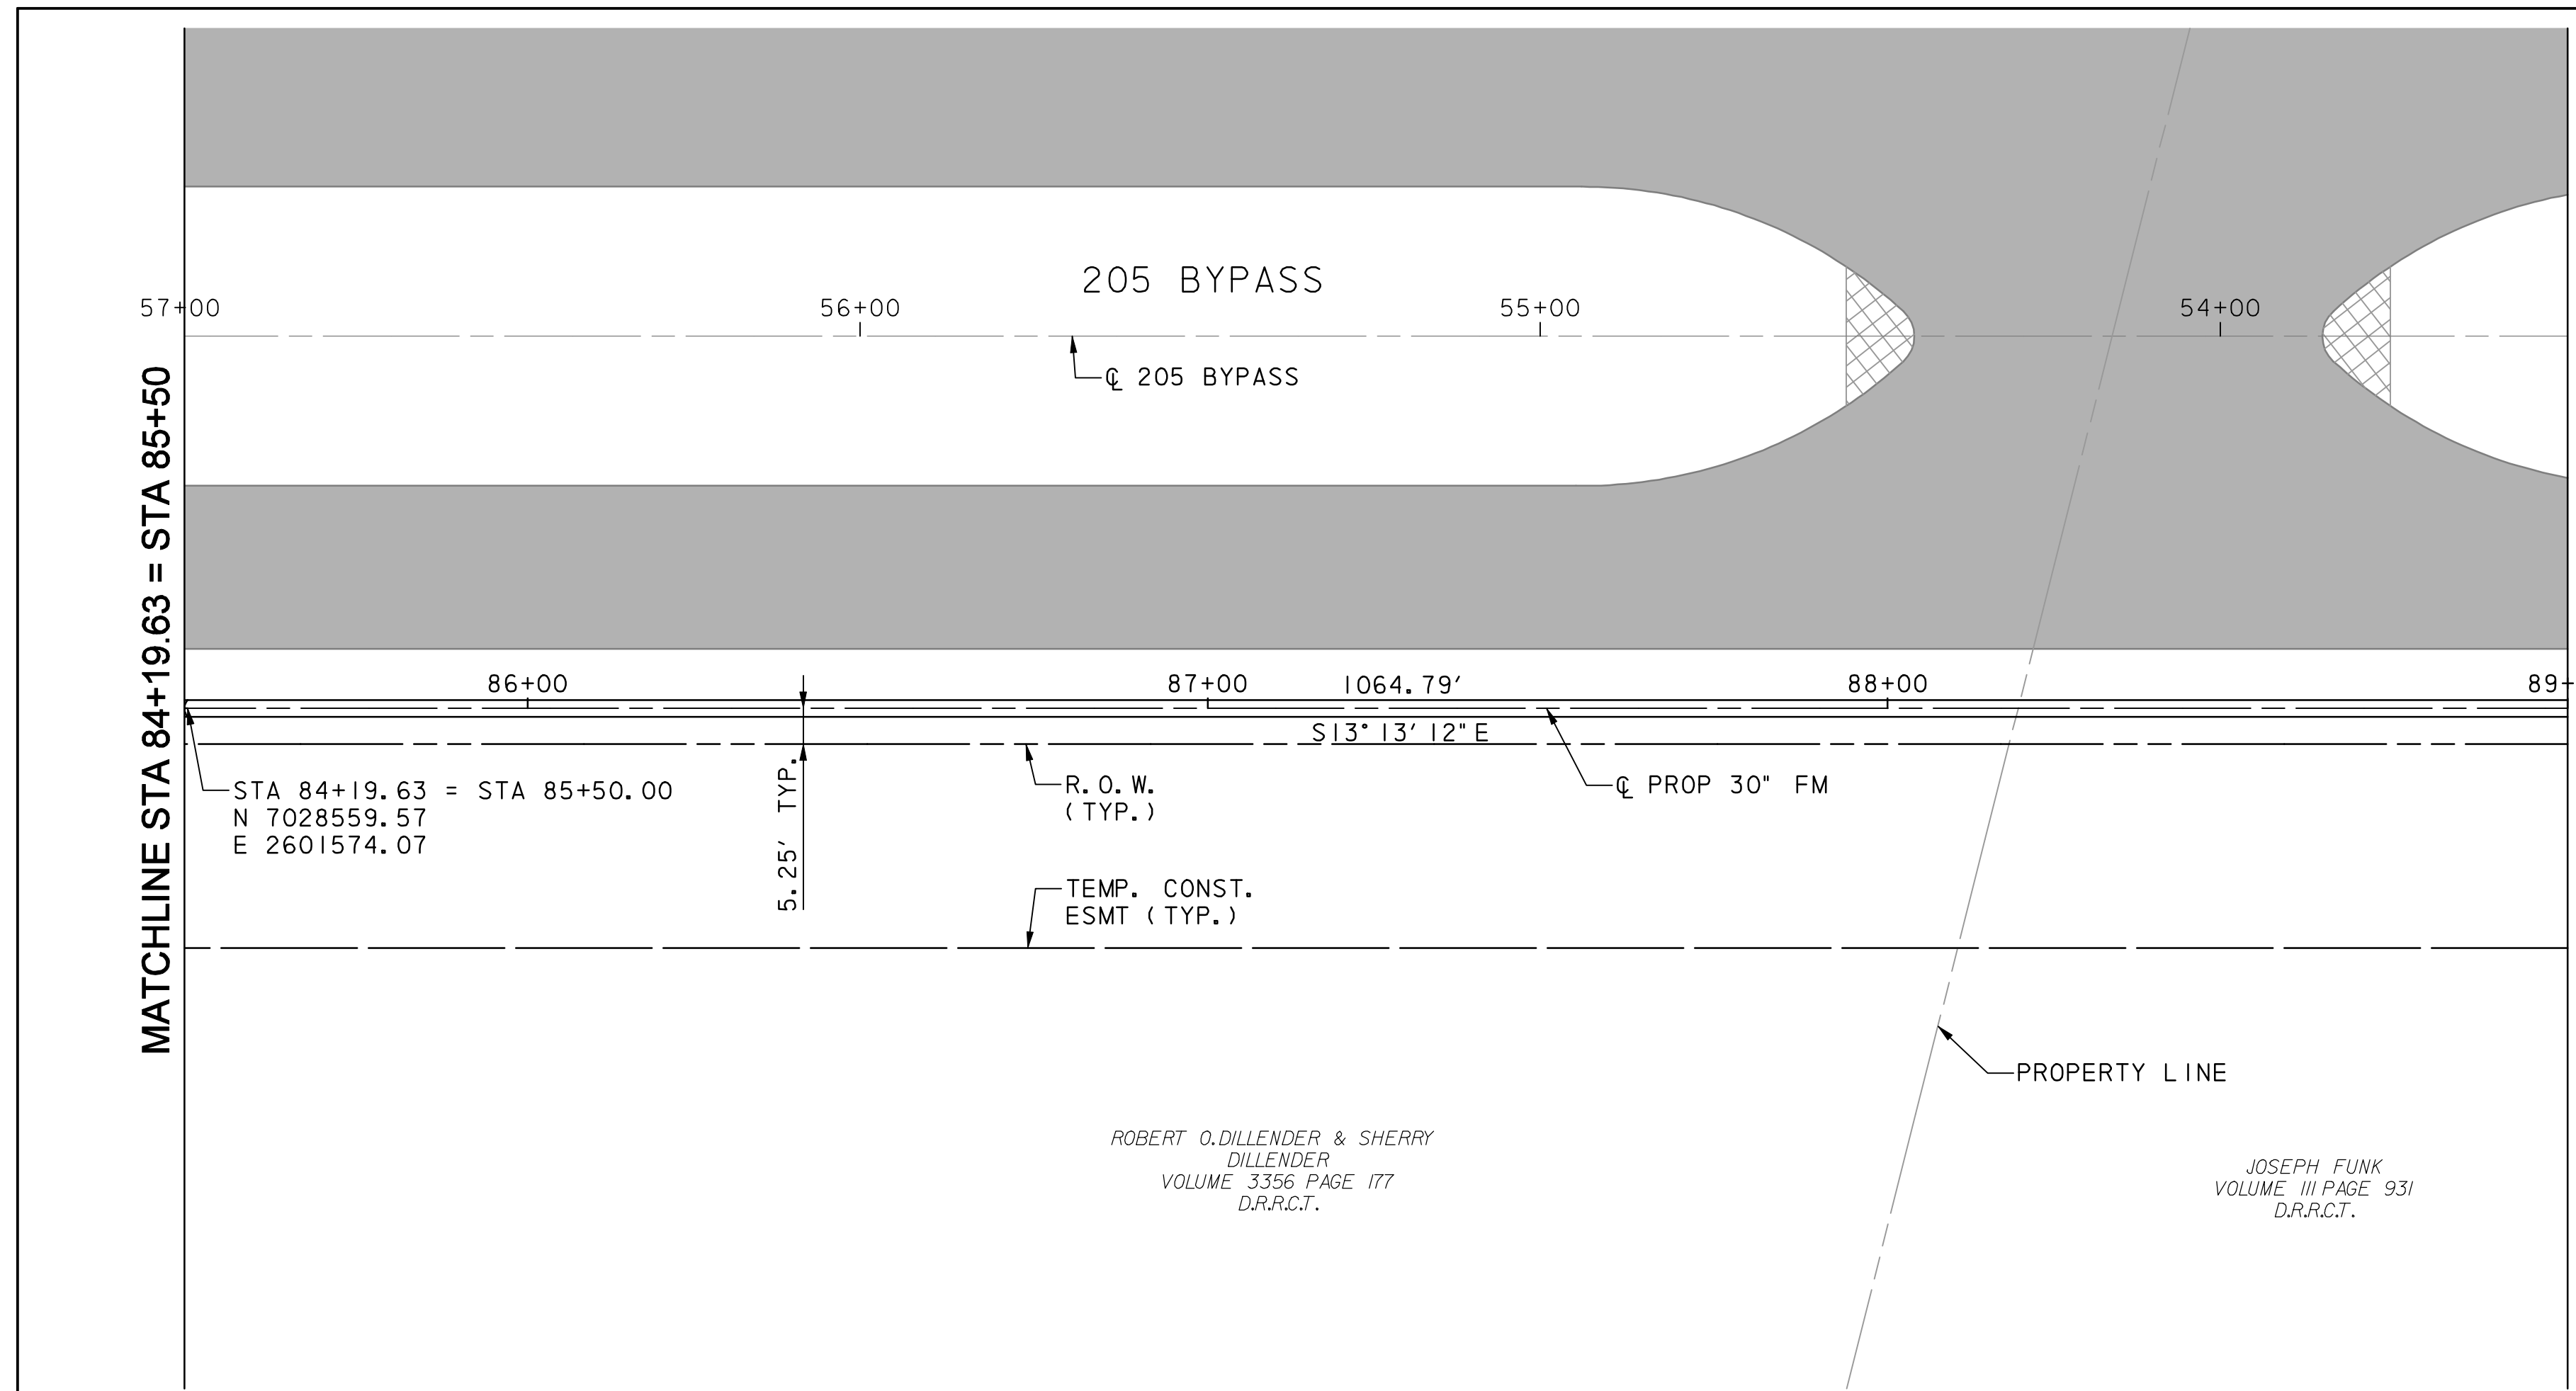

**RECORD DRAWING**  
This drawing is a compilation of the original sealed engineering drawing and modifications by addenda, change orders and information furnished by the contractor. Information shown that was provided by the contractor and others not associated with the design engineer cannot be verified for accuracy or completeness. Original sealed drawing is on file at the office of AECOM USA Group, Inc., TBPE REG. NO. F-3082

**ORIGINAL DRAWING SEALED & SIGNED BY**  
Nicholas R. Batker, P.E.  
TX NO. 92749

NO.	REVISION	BY	DATE

**City of Rockwall, Texas**

**205 BYPASS PHASE 3**

**30" FORCE MAIN PLAN & PROFILE STA 84+19.63 TO 89+00** 7 OF 18

**TCB | AECOM** TCB INC. WWW.TCB.AECOM.COM 17300 DALLAS PARKWAY, SUITE 1010 DALLAS, TEXAS 75248

Unit	PW-DAL-FW	Scale	Horz: 1:40 Vert: 1:10	Date	11/23/2009
Designed	JLT/SDB	Checked	NRB	Project No.	60023784
Drawn	TCB	Approved	NRB	Sheet	135 of 215

11/23/2009 3:29:11 PM \\usdell1p001\p001\pww4328\60004153-205Bypass\CAD\Drawings\Phase 3 - 1 30 to Station SH 66\Record Drawing 10-7-09-135P&P07.dgn