
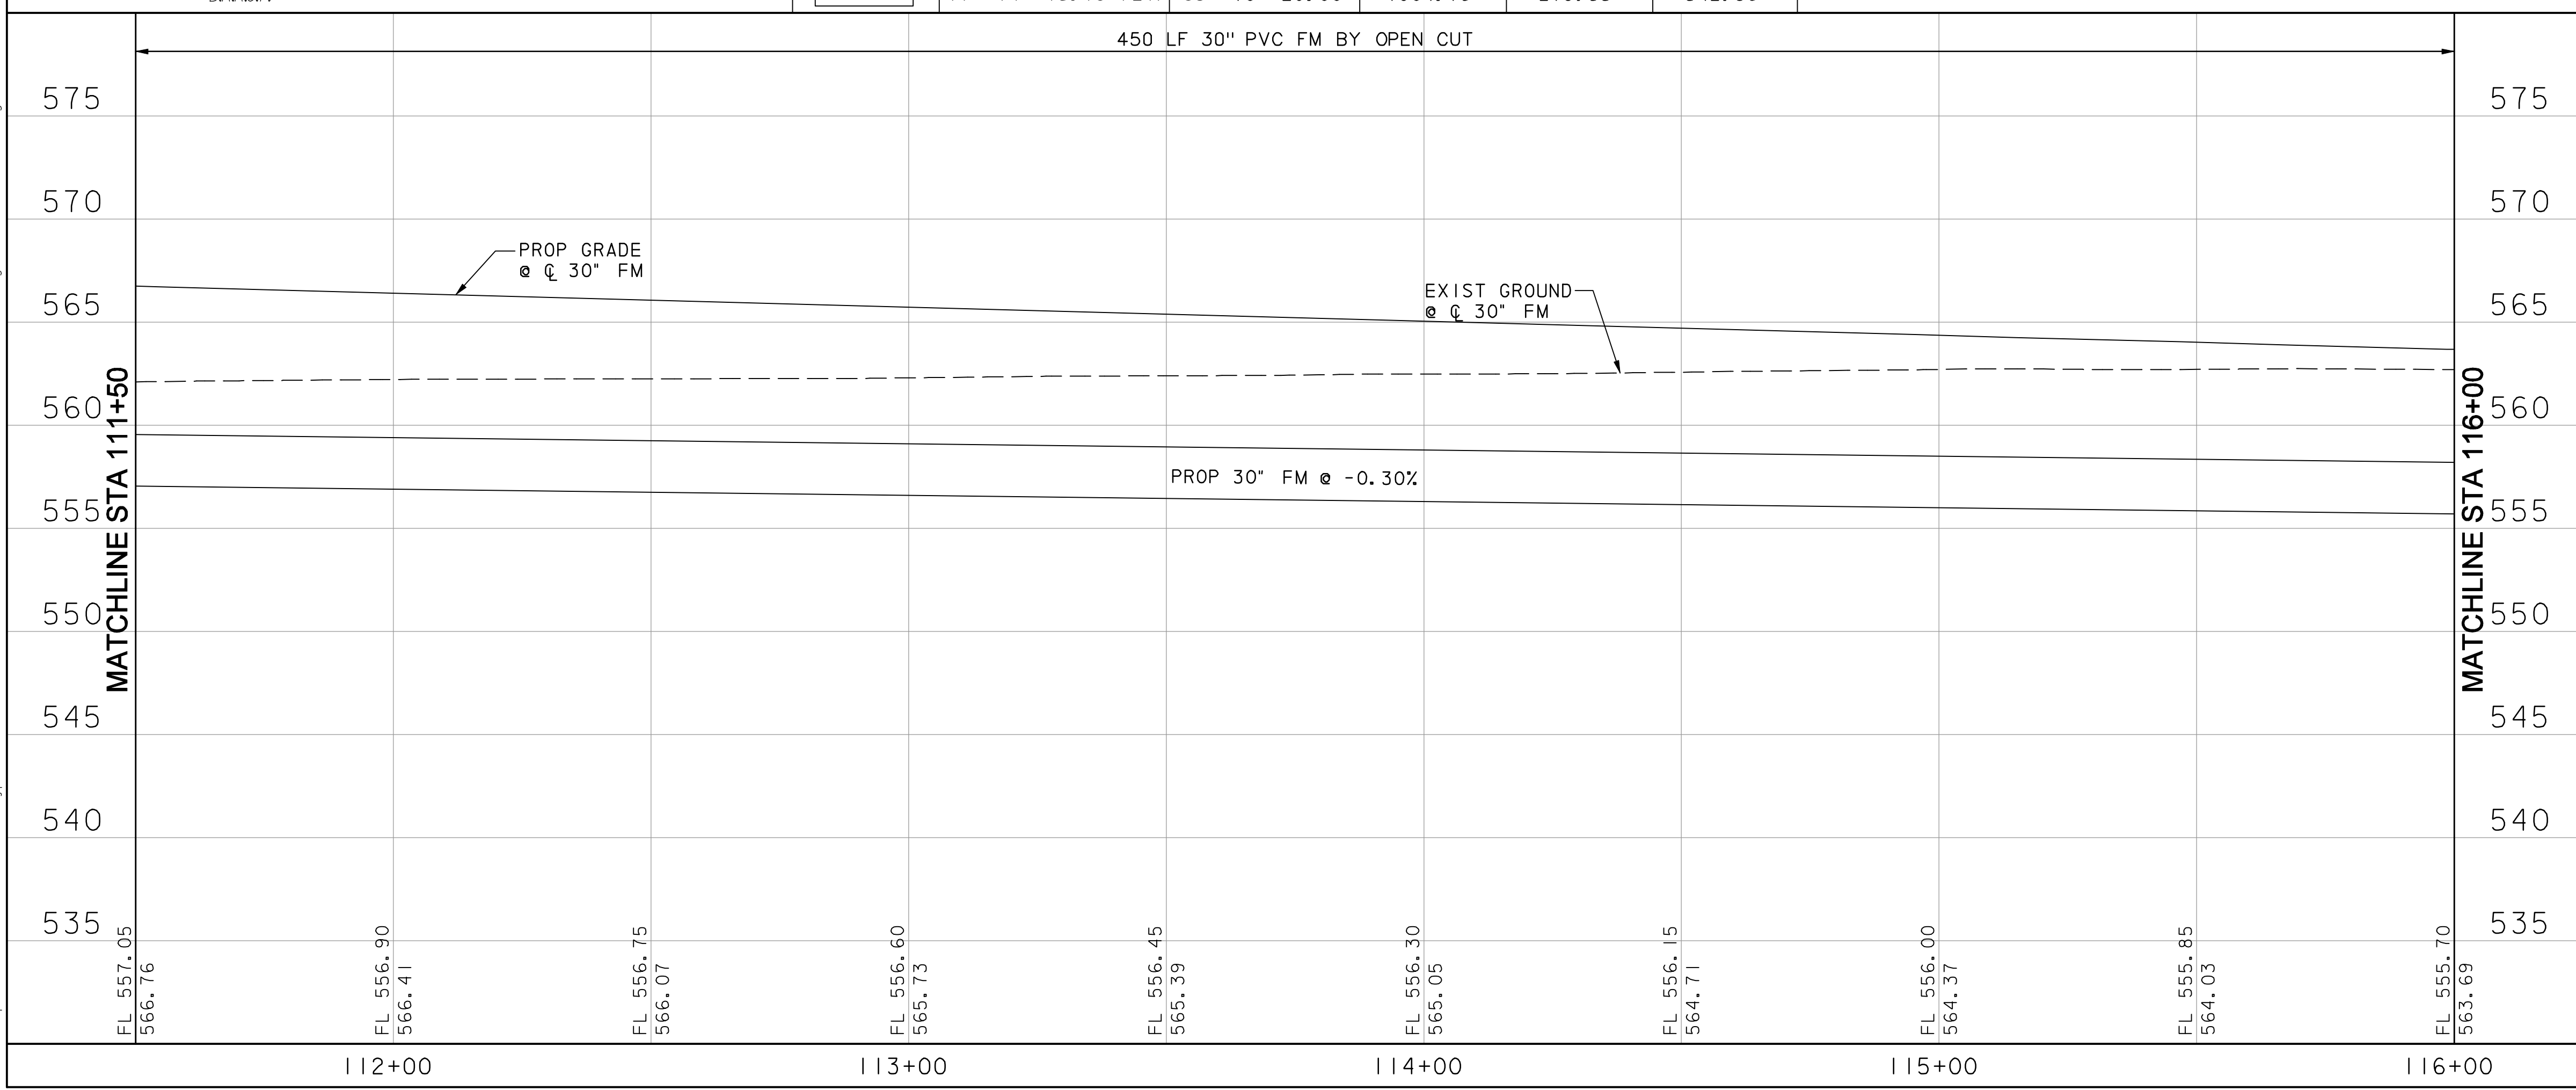


LEGEND

- RIGHT-OF-WAY -----
- DRAINAGE EASEMENT -----
- TEMP. CONSTRUCTION EASEMENT -----
- 205 BYPASS PAVING [Shaded Area]

UNDERGROUND UTILITIES
 THE LOCATION OF EXISTING UTILITIES SHOWN ON THESE PLANS ARE APPROXIMATE AND BASED ON DATA FURNISHED BY THE CITY OF ROCKWALL. IT IS THE RESPONSIBILITY OF THE CONTRACTOR TO LOCATE AND VERIFY ON-SITE THE UTILITIES THAT MAY CONFLICT WITH THE CONSTRUCTION.

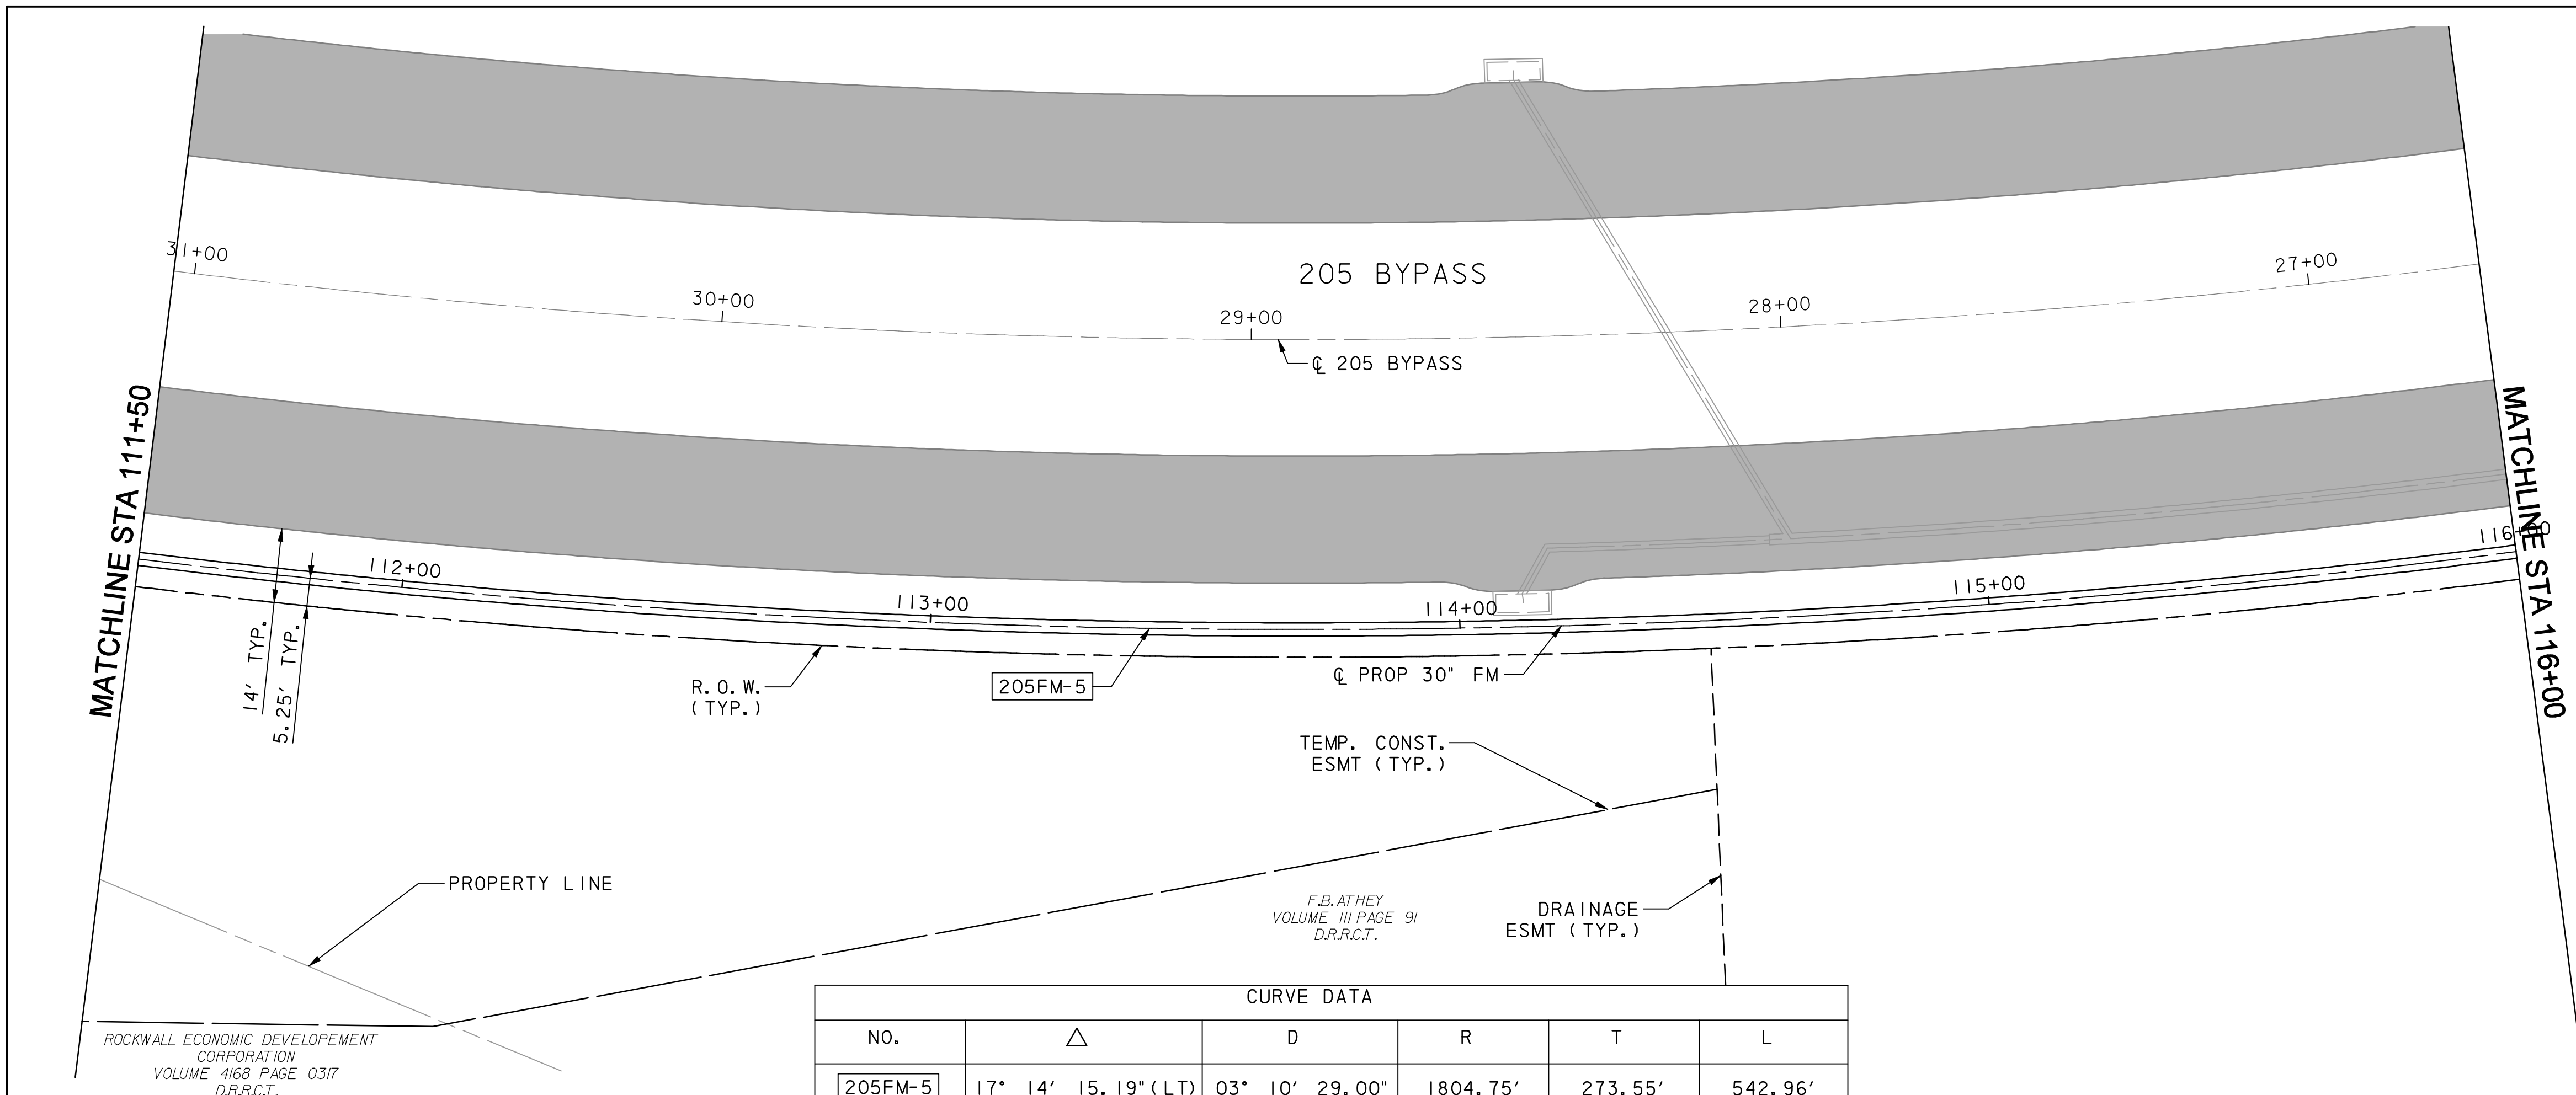

RECORD DRAWING
 This drawing is a compilation of the original sealed engineering drawing and modifications by addenda, change orders and information furnished by the contractor. Information shown that was provided by the contractor and others not associated with the design engineer cannot be verified for accuracy or completeness. Original sealed drawing is on file at the office of AECOM USA Group, Inc., TBPE REG. NO. F-3082

ORIGINAL DRAWING SEALED & SIGNED BY
 Nicholas R. Batker, P.E.
 TX NO. 92749

NO.	REVISION	BY	DATE

City of Rockwall, Texas

**205 BYPASS
PHASE 3**

**30" FORCE MAIN
PLAN & PROFILE
STA 111+50 TO 116+00** 13 OF 18

TCB AECOM		TCB INC. WWW.TCB.AECOM.COM 17300 DALLAS PARKWAY, SUITE 1010 DALLAS, TEXAS 75248	
Unit	PW-DAL-FW	Scale	Horz: 1:40 Vert: 1:10
Designed	JLT/SDB	Checked	NRB
Drawn	TCB	Approved	NRB
Date	11/23/2009	Project No.	60023784
Sheet	141	of	215

11/23/2009 3:30:30 PM
 \\usdell1p001\pww\4328\60004153-205Bypass\AADD\Sheets\Phase 3 - 1 30 to Station SH 66\Record Drawing 10-7-09\14 IP&P13.dgn