

# City of Rockwall, Texas

## CONSTRUCTION PLANS FOR JOHN KING BOULEVARD (205 BYPASS) PHASE 4

### QUAIL RUN TO FM-1141 STA 120+00 TO STA 141+00

### APRIL 2008


**MAYOR**  
Bill Cecil

**MAYOR PRO-TEM**  
Stephen Straughan

**CITY COUNCIL**  
Glen Farris  
Mathew R. Scott  
David Sweet  
Cliff Sevier  
Margo Nielsen

**CITY MANAGER**  
Julie Couch

**CITY ENGINEER**  
Chuck Todd

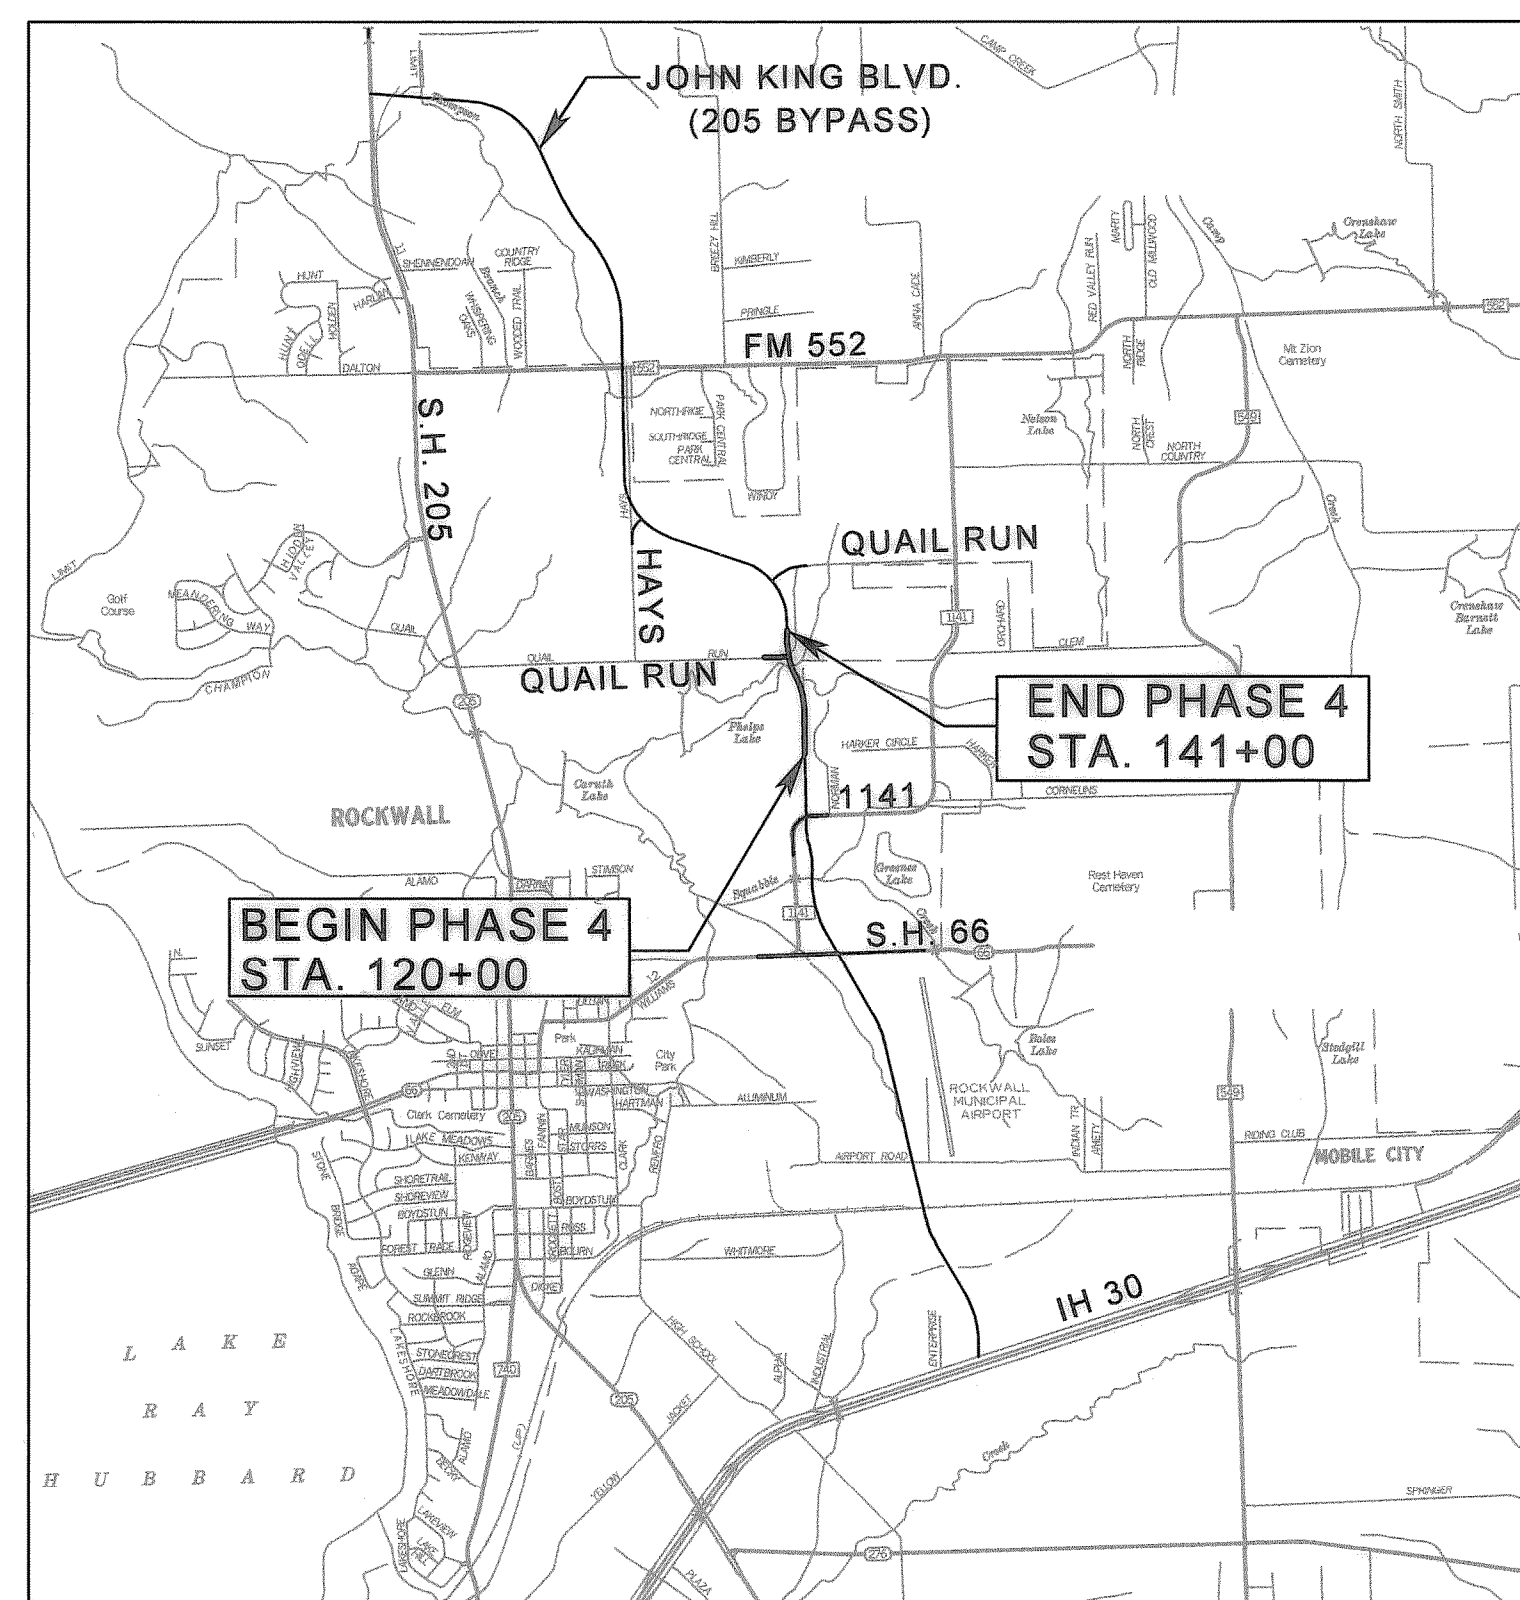

PROJECT LENGTH = 2100 LF

VICINITY MAP  
SCALE: N.T.S.

#### RECORD DRAWING

This drawing is a compilation of the original sealed engineering drawing and modifications by addenda, change orders and information furnished by the contractor. Information shown that was provided by the contractor and others not associated with the design engineer cannot be verified for accuracy or completeness. Original sealed drawing is on file at the office of AECOM USA Group, Inc., TBPE REG. NO. F-3082

#### ORIGINAL DRAWING SEALED & SIGNED BY

Gregory G. Hooten, P.E.  
TX NO. 83936

#### ORIGINAL DRAWING SEALED & SIGNED BY

T.H. Gaertner, P.E.  
TX NO. 37124

**TCB** | **AECOM**

TCB INC.  
17300 DALLAS PARKWAY, SUITE 1010  
DALLAS, TEXAS 75248  
WWW.TCB.AECOM.COM