



**205 BYPASS - TYPICAL SECTION**  
 STA. 120+00 TO STA. 131+36  
 STA. 136+35 TO STA. 141+00

\* 14' USUAL PARKWAY WIDTH. IN AREAS WHERE THE DISTANCE FROM THE FACE OF CURB TO THE ROW IS GREATER THAN 14', EXTEND PARKWAY TO 14' @ 2%, THEN SLOPE TO NATURAL GROUND AT 4:1.


- (A) 9" CONTINUOUSLY REINFORCED CONCRETE PAVEMENT (5000 PSI) (SEE DETAIL CRCP-03)
- (B) 8" LIME TREATED SUBGRADE WITH 38 POUNDS OF LIME PER SQUARE YARD
- (C) EMBANKMENT, COMPACTED TO 95% STD PROCTOR DENSITY WITH SHEEP'S FOOT ROLLER.
- (D) 4" TOPSOIL WITH BLOCK SODDING ON PARKWAYS AND MEDIANS. SEE NOTE 3.
- (E) MONOLITHIC INTEGRAL CONCRETE CURB AND GUTTER
- (F) 4" TOPSOIL WITH HYDRO MULCH SEEDING ON SLOPED AREAS AND DISTURBED AREAS OUTSIDE OF ROW. SEE NOTE 3.

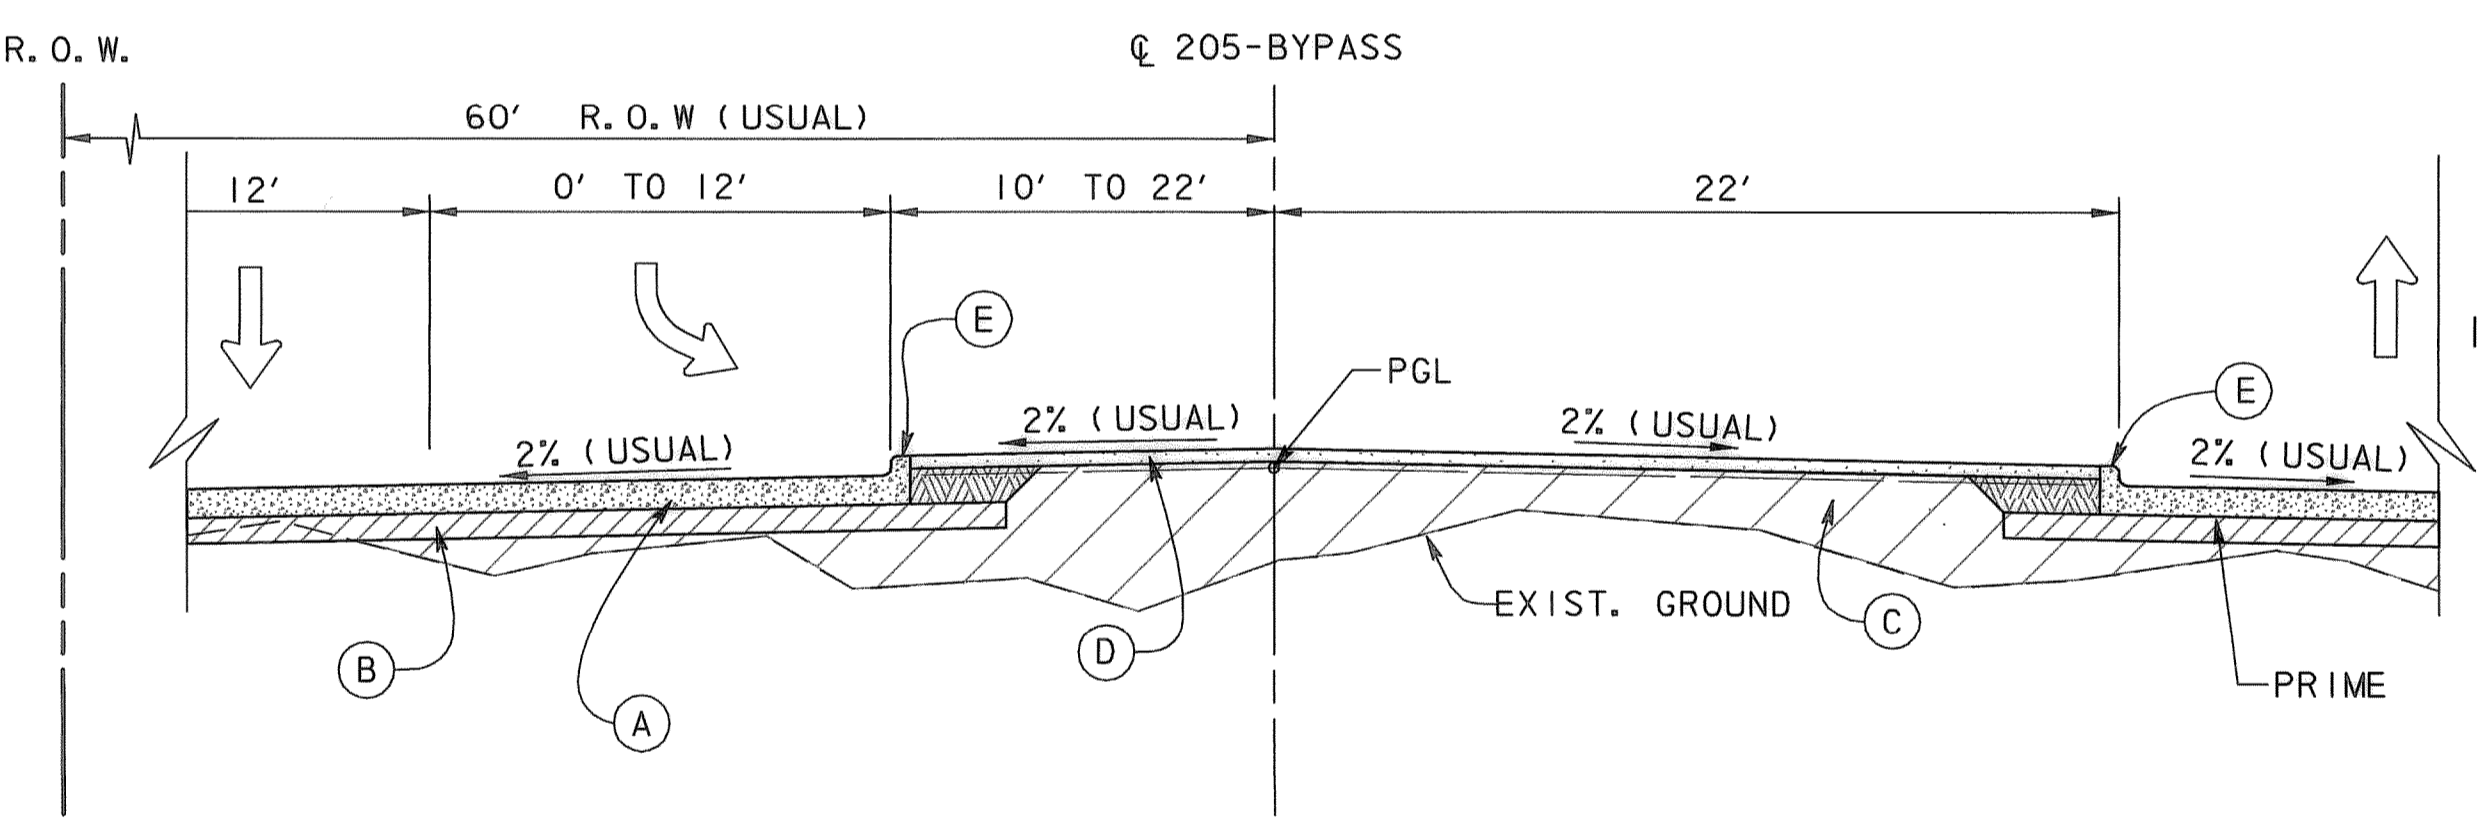


**205 BYPASS - PARTIAL SECTION TYPICAL LEFT TURN**  
 NB STA. 125+65 TO STA. 127+26  
 NB STA. 135+25 TO STA. 136+78

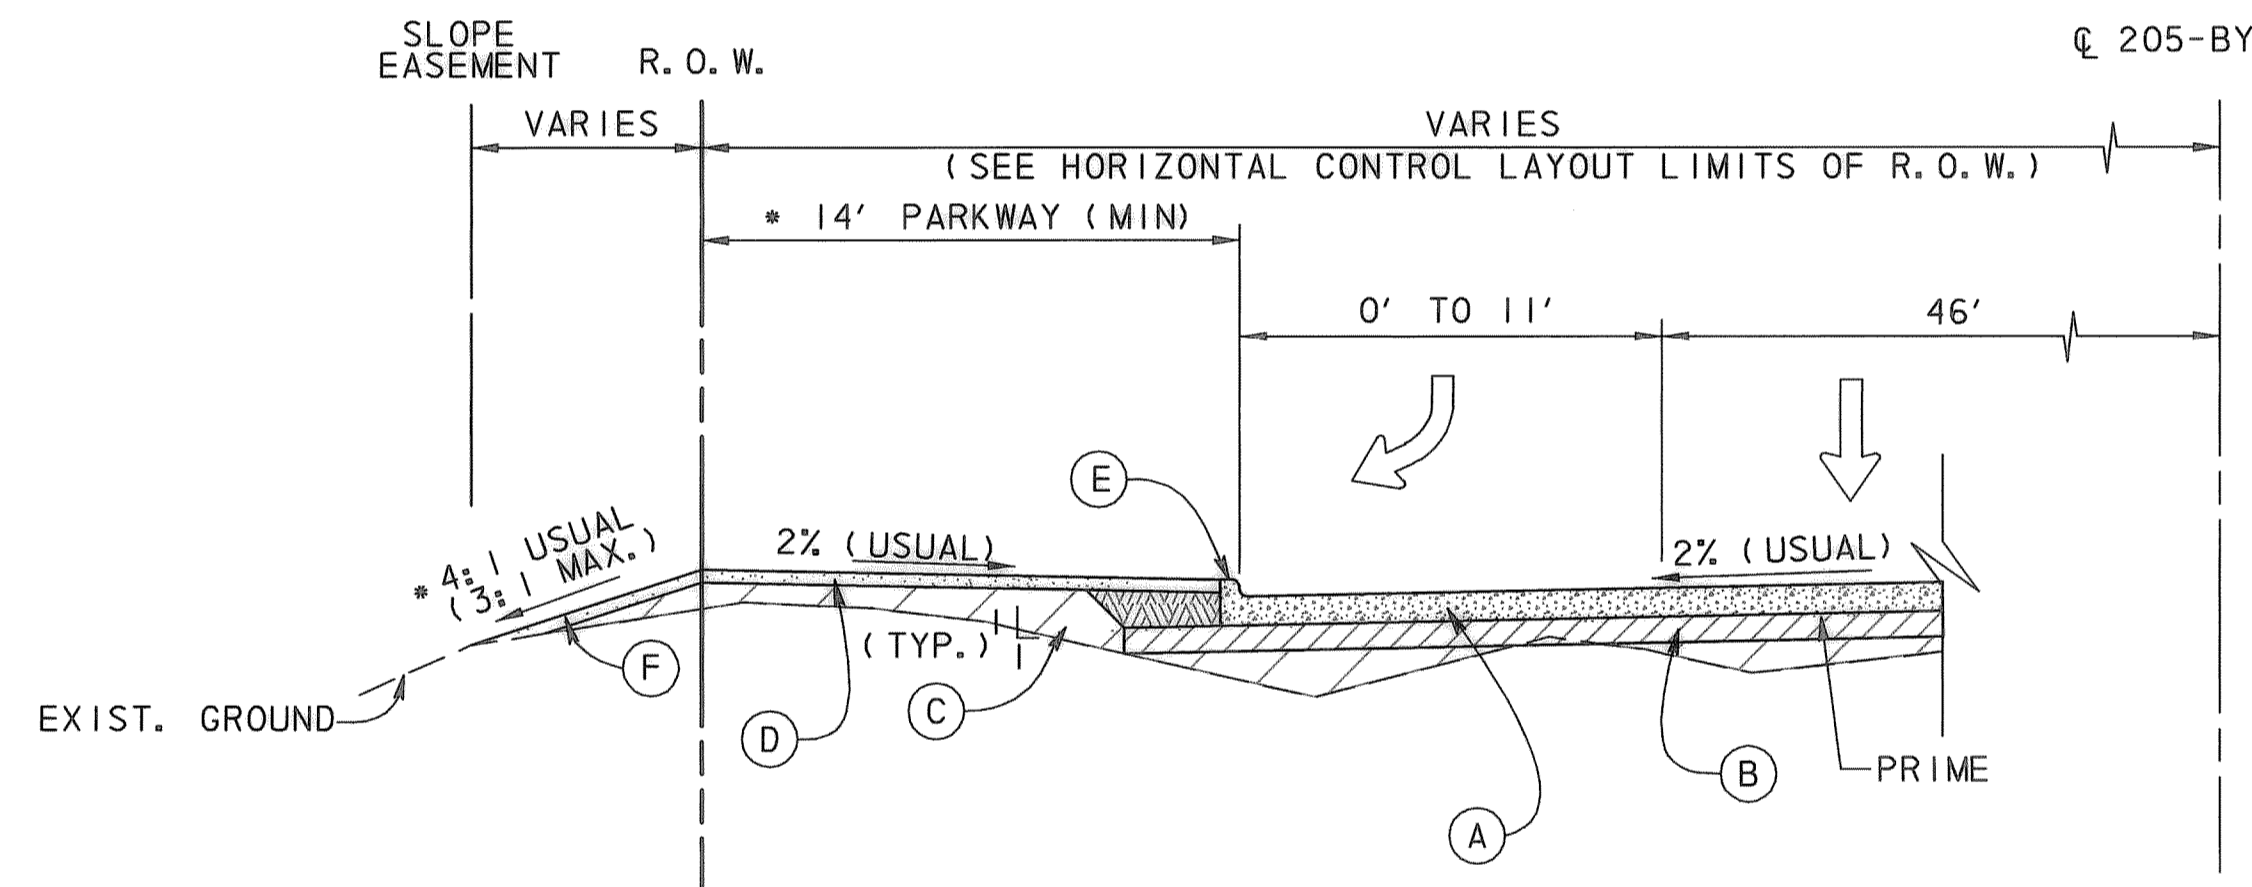

**205 BYPASS - PARTIAL SECTION TYPICAL RIGHT TURN**  
 SB STA. 137+86 TO STA. 140+28

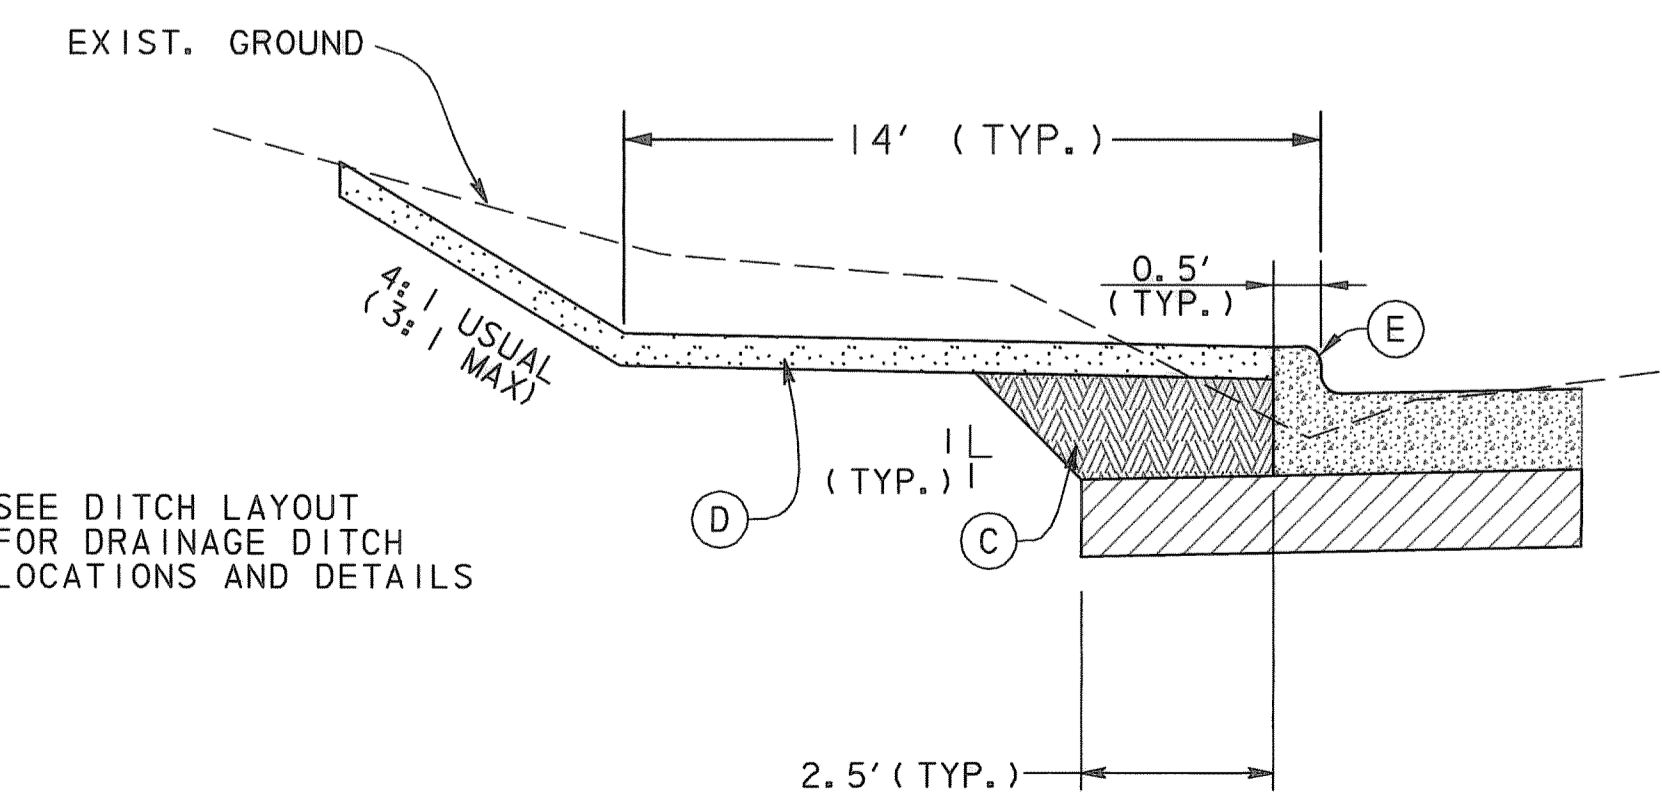

**205 BYPASS - CUT TIE IN SECTION**  
 N. T. S.

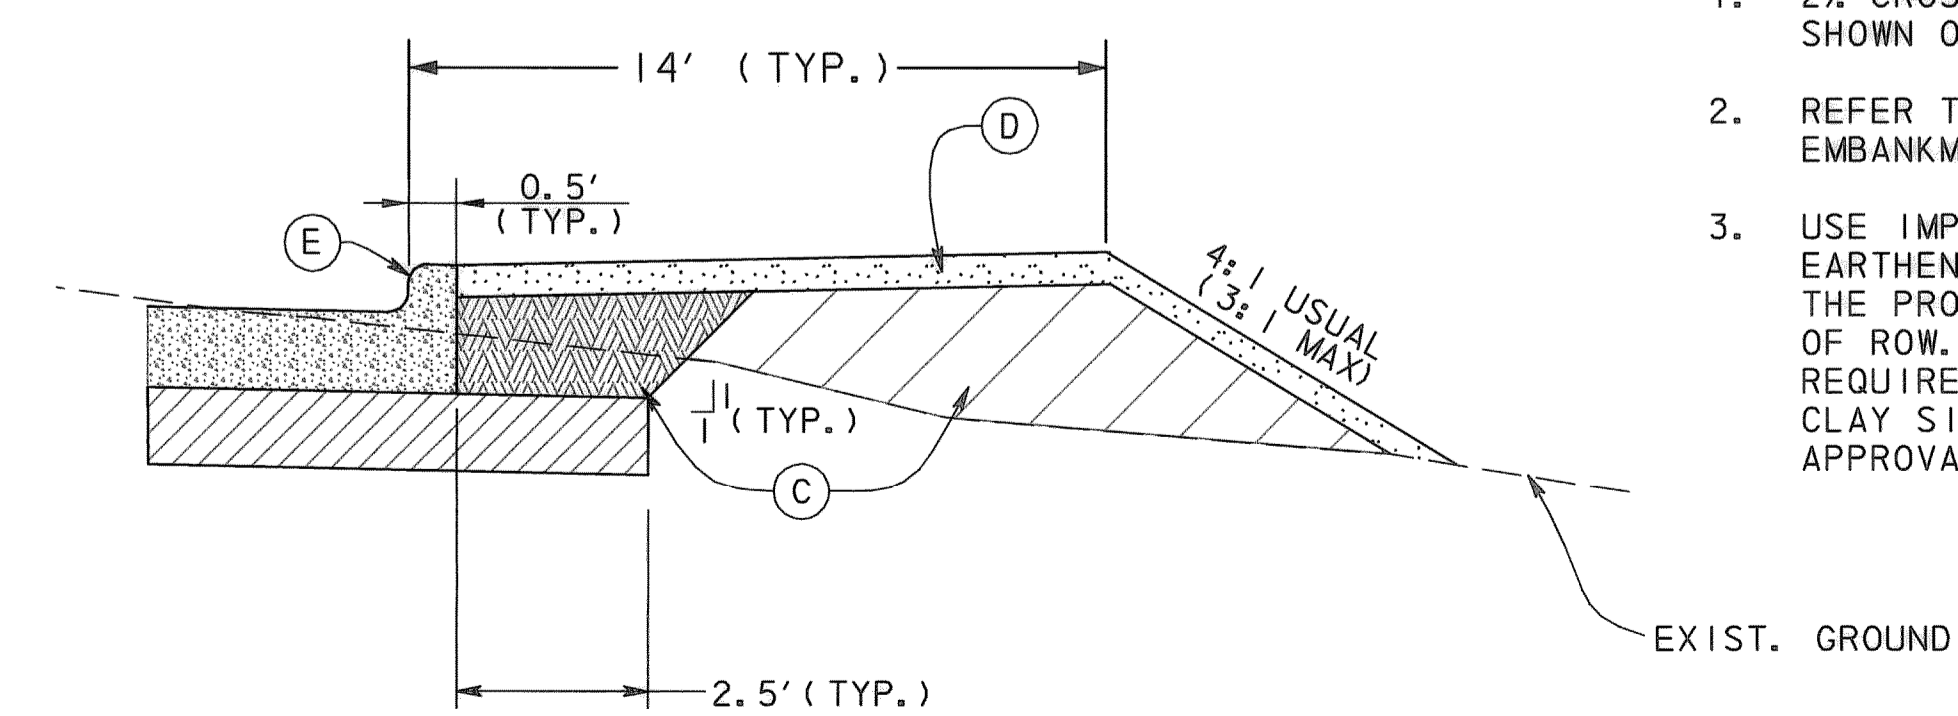

**205 BYPASS - FILL TIE IN SECTION**  
 N. T. S.

- NOTES:**
- 2% CROSS-SLOPE IS USUAL, UNLESS OTHERWISE SHOWN ON PLANS.
  - REFER TO CROSS SECTIONS FOR CUT AND EMBANKMENT SLOPE INFORMATION.
  - USE IMPORTED TOP SOIL WITHIN THE ROW AND ON EARTHEN CHANNEL SLOPES. USE TOP SOIL FROM THE PROJECT SITE FOR ALL OTHER AREAS OUTSIDE OF ROW. THE IMPORTED TOP SOIL SHALL MEET THE REQUIREMENTS OF C.O.G. SPEC 3.8.1 AND BE A CLAY SILT OR SILTY CLAY TYPE SOIL MEETING THE APPROVAL OF THE CITY FOR USE ON THIS PROJECT.

**RECORD DRAWING**  
 This drawing is a compilation of the original sealed engineering drawing and modifications by addenda, change orders and information furnished by the contractor. Information shown that was provided by the contractor and others not associated with the design engineer cannot be verified for accuracy or completeness. Original sealed drawing is on file at the office of AECOM USA Group, Inc., TBPE REG. NO. F-3082

**ORIGINAL DRAWING SEALED & SIGNED BY**  
 T.H. Gaertner, P.E.  
 TX NO. 37124

NO.	REVISION	BY	DATE

**City of Rockwall, Texas**

**205 BYPASS PHASE 4**

**TYPICAL SECTIONS 205 BYPASS**

1 OF 2

Unit#	PW-DAL-FW	Scale:	Horz: AS SHOWN Vert: AS SHOWN	Date	11/11/2009
Designed	THG	Checked	TCB	Project No.	60004153
Drawn	FG	Approved	TCB	Sheet	4 of 146

TCB INC. WWW.TCB.AECOM.COM  
 17300 DALLAS PARKWAY, SUITE 1010  
 DALLAS, TEXAS 75248

P:\4328\60004153-205Bypass\CADD\Sheets\Phase 4-120+00 to 141+00\Record Drawing 10-7-09\04TypicalSection-205.dgn  
 11/11/2009