



LEGEND

- (A) 4" WHITE SOLID BUTTON TYPE LINE
- (B) WHITE BUTTON TYPE LANE LINE
- (C) WHITE BUTTON TURN BAY LINE.
- (D) 4" YELLOW SOLID BUTTON TYPE LINE
- (E) 4" DOUBLE YELLOW BUTTON LINE
- (F) 24" WHITE STOP BAR
- (G) "ONLY" WHITE
- (H) WHITE LEFT TURN ARROW
- (I) WHITE RIGHT TURN ARROW
- (J) 12" WHITE SOLID
- (K) 12" YELLOW SOLID
- (L) WHITE ARROW

NOTE:

SEE MISC. ROADWAY DETAIL SHEET 2 OF 2 FOR MORE PAVEMENT MARKING DETAILS.

RECORD DRAWING

This drawing is a compilation of the original sealed engineering drawing and modifications by addenda, change orders and information furnished by the contractor. Information shown that was provided by the contractor and others not associated with the design engineer cannot be verified for accuracy or completeness. Original sealed drawing is on file at the office of AECOM USA Group, Inc., TBPE REG. NO. F-3082

ORIGINAL DRAWING SEALED & SIGNED BY
T.H. Gaertner, P.E.
TX NO. 37124

NO.	REVISION	BY	DATE

1 OF 1


City of Rockwall, Texas

205 BYPASS
PHASE 4

SIGNING & PAVEMENT MARKING LAYOUT

TCB AECOM
TCB INC. WWW.TCB.AECOM.COM
17300 DALLAS PARKWAY, SUITE 1010
DALLAS, TEXAS 75248

Unit	PW-DAL-FW	Scale	Horz: AS SHOWN Vert: AS SHOWN	Date	11/23/2009
Designed	THG	Checked	TCB	Project No.	60004153
Drawn	EG	Approved	TCB	Sheet	41 of 146

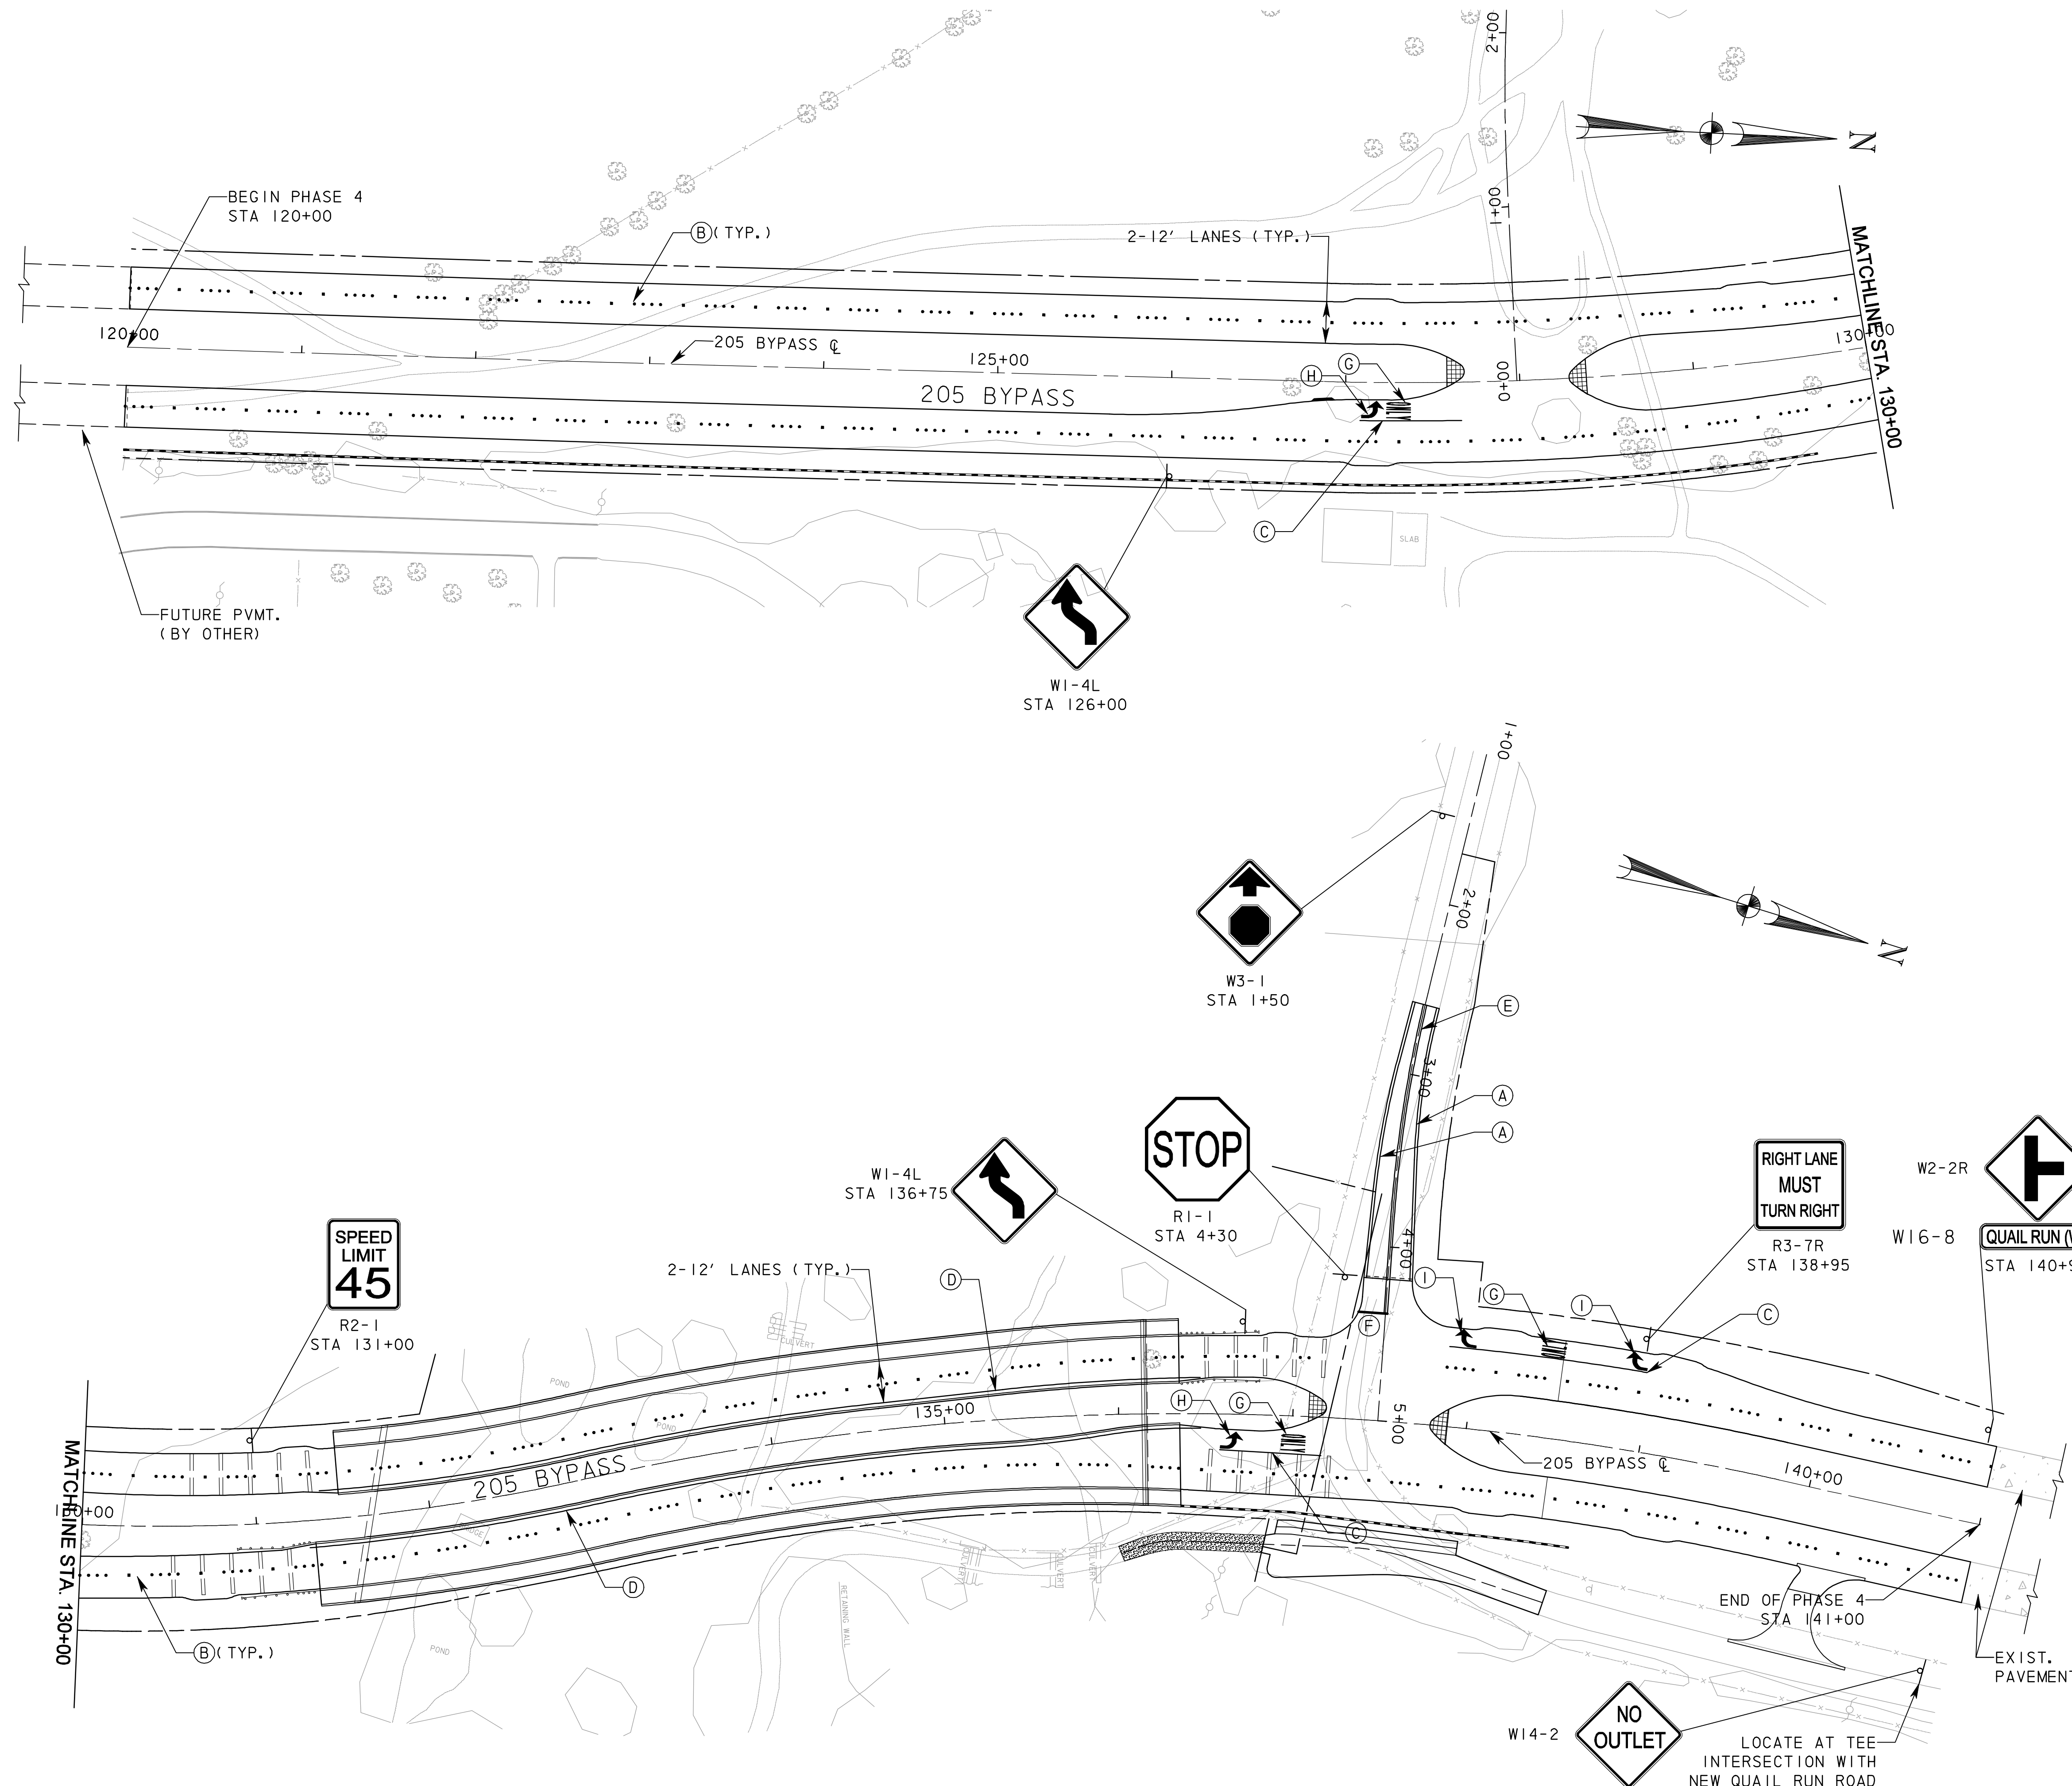

P:\328\60004153-205bypass\cadd\sheet\phase 4-120+00 to 141+00\record drawing 10_7_09\041 PavMk-01.dgn
 11/23/2009