



11/23/2009 4:26:40 PM P:\4328\00004153-205bypass\cadd\sheet5\phase 4-120+00\record draw1ng 10-7-09\044Proj\ect_L\Layout.dgn

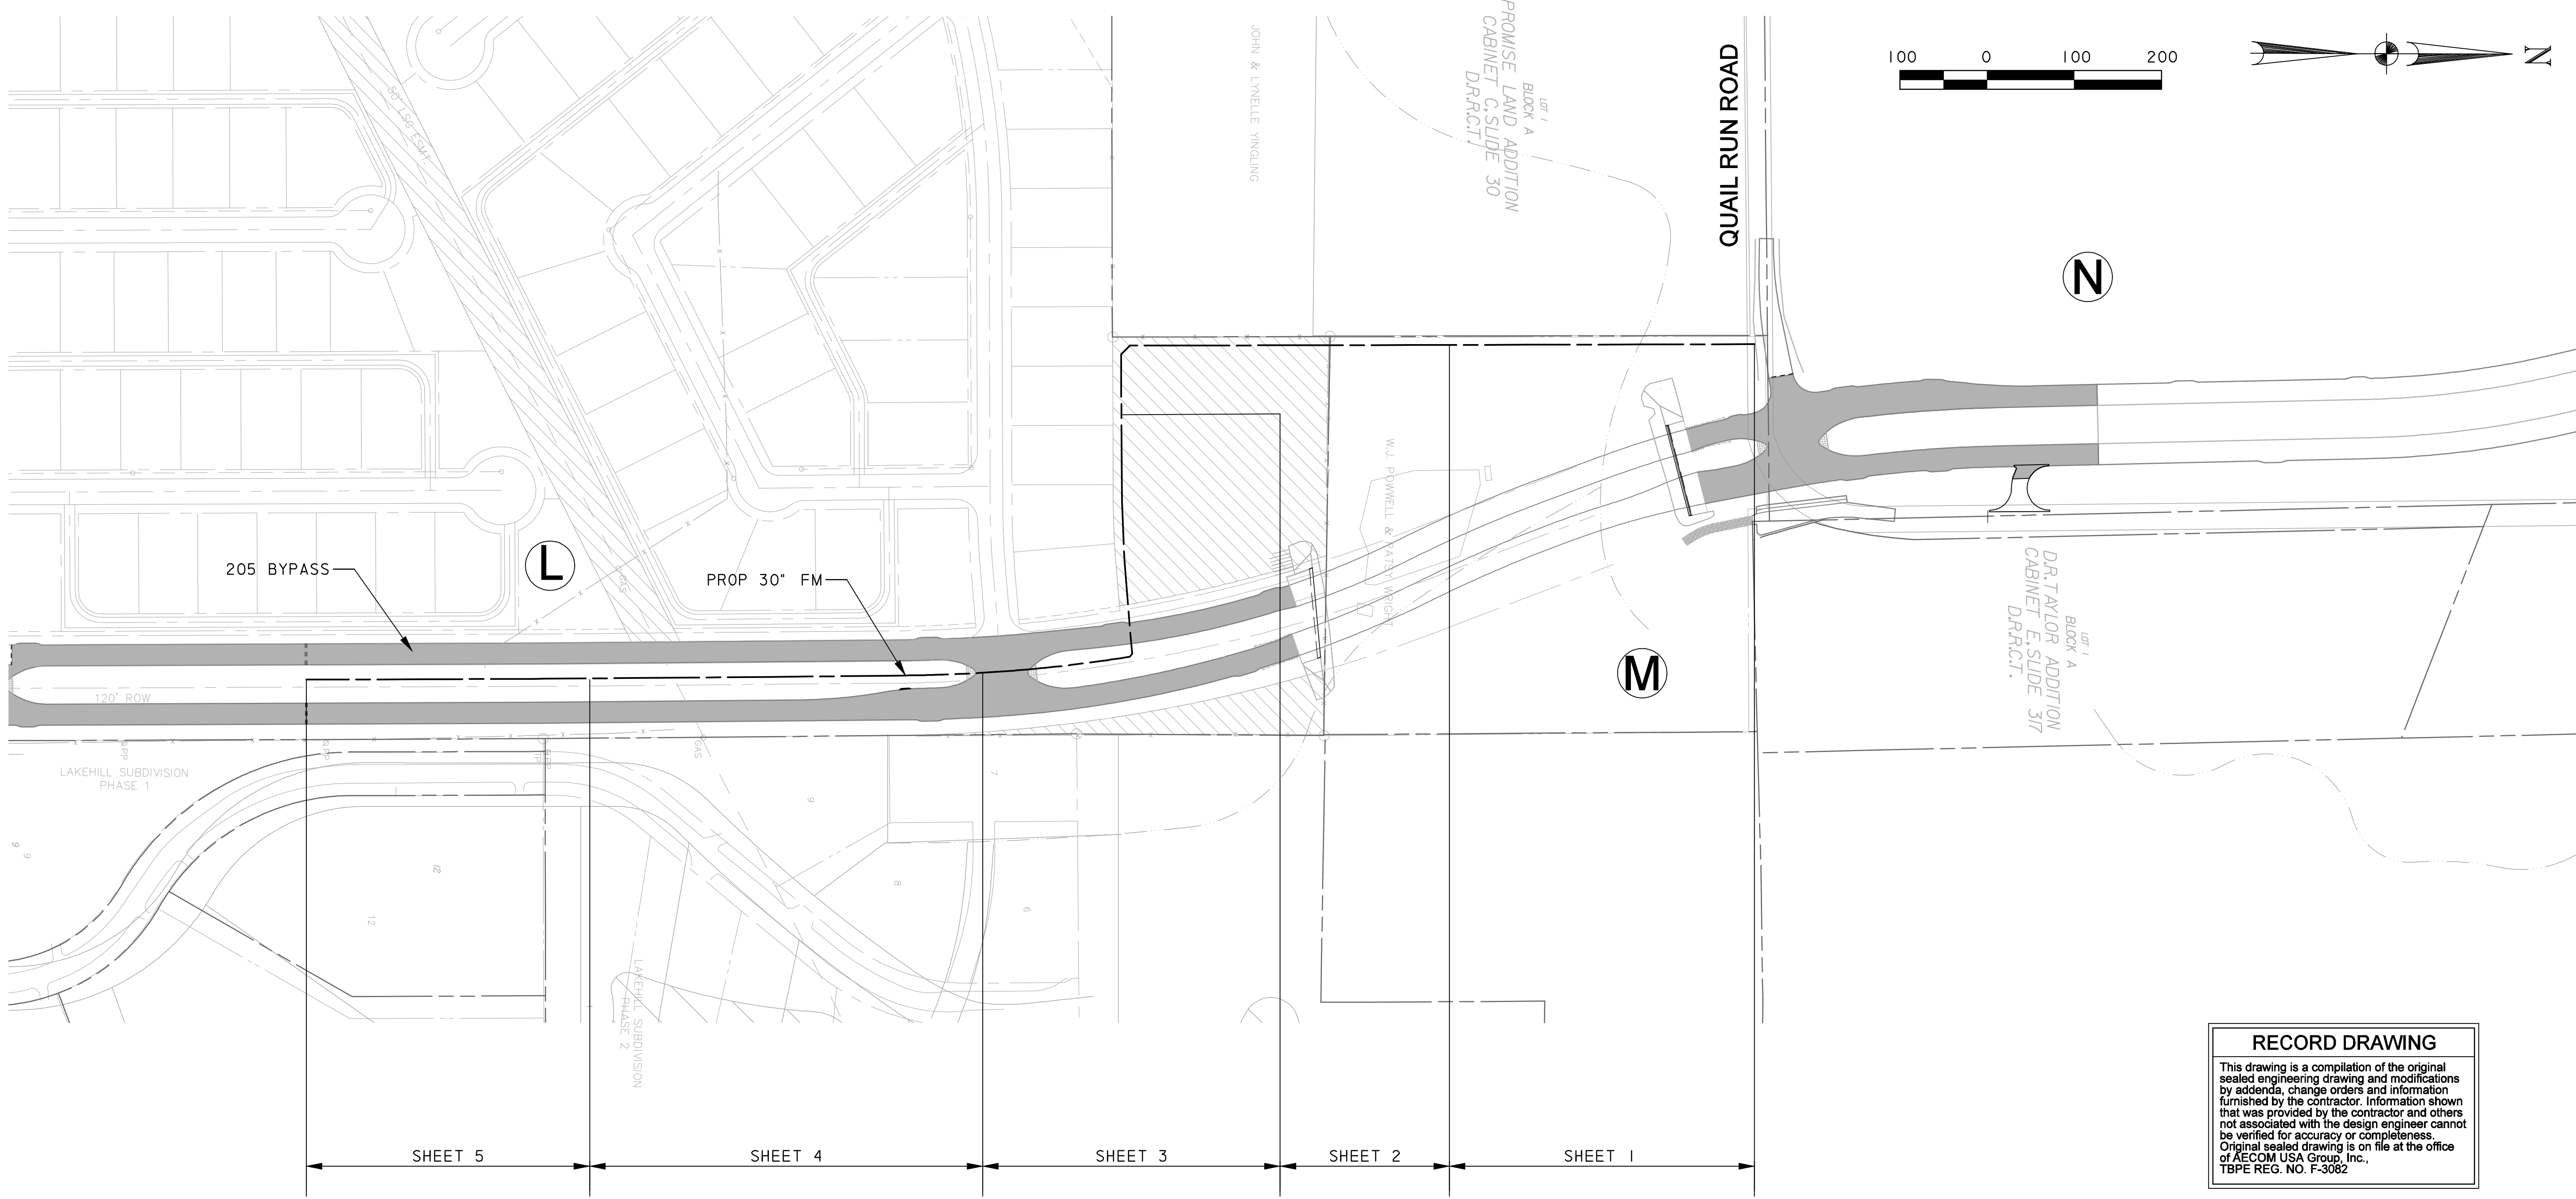

Parcel	Owner Name
L	Lumbermens Investment Corporation
M	Nick Grant
N	Lonnie L. Gideon

RECORD DRAWING
 This drawing is a compilation of the original sealed engineering drawing and modifications by addenda, change orders and information furnished by the contractor. Information shown that was provided by the contractor and others not associated with the design engineer cannot be verified for accuracy or completeness. Original sealed drawing is on file at the office of AECOM USA Group, Inc., TBPE REG. NO. F-3082

ORIGINAL DRAWING
 SEALED & SIGNED BY
 Nicholas R. Batker, P.E.
 TX NO. 92749

NO.	REVISION	BY	DATE
 City of Rockwall, Texas			
205 BYPASS PHASE 4			
PROJECT LAYOUT SHEET & PROFILE SHEET INDEX			
TCB AECOM		<small>TCB INC. WWW.TCB.AECOM.COM 17300 DALLAS PARKWAY, SUITE 1010 DALLAS, TEXAS 75248</small>	
Unit	PW-DAL-FW	Scales	Horz: 1:40 Vert: 1:10
Designed	JLT/SDB	Checked	NRB
Drawn	TCB	Approved	NRB
Date	11/23/2009	Project No.	60023784
Sheet	44	of	146