



QUAIL RUN ROAD
STA 4+18.46

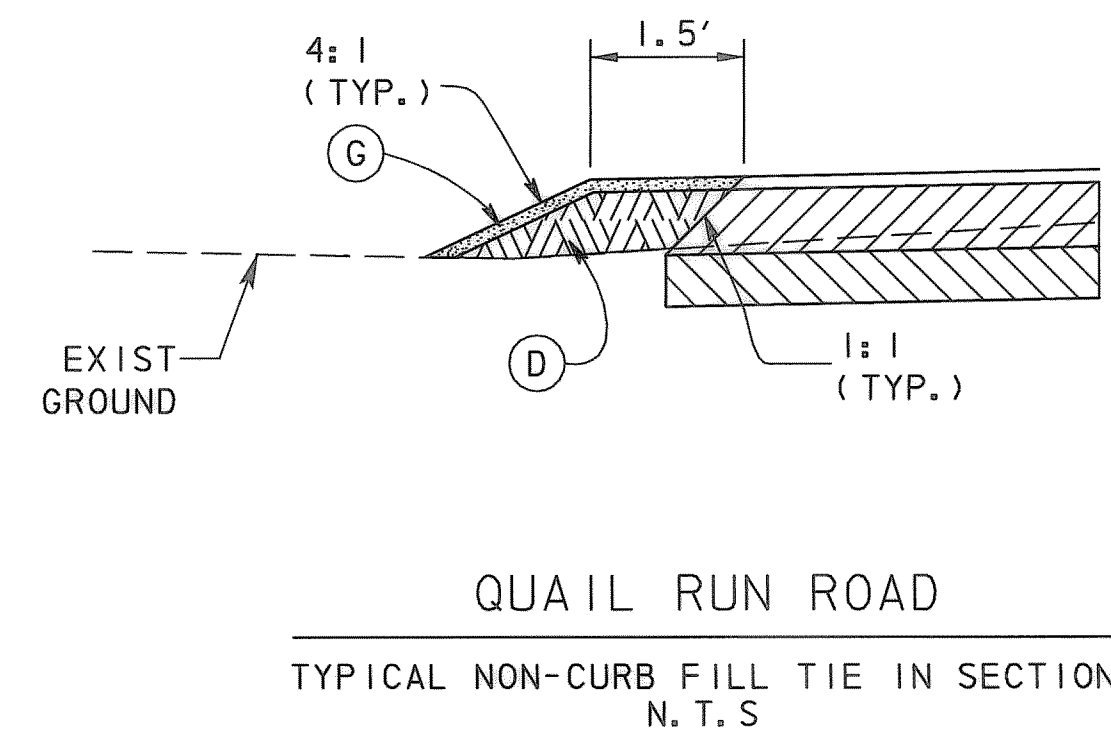


- (A) 9" CONTINUOUSLY REINFORCED CONCRETE PAVEMENT (5000 PSI) (SEE DETAIL CRCP-03)
- (B) 4" HMAC UNDERLAYMENT (TY. D) PAID FOR USING (METHOD)
- (C) 8" LIME TREATED SUBGRADE WITH 38 POUNDS OF LIME PER SQUARE YARD
- (D) EMBANKMENT, COMPACTED TO 95% STD PROCTOR DENSITY WITH SHEEP'S FOOT ROLLER.
- (E) 4" TOPSOIL WITH HYDRO MULCH SEEDING ON SLOPED AREAS AND DISTURBED AREAS OUTSIDE OF ROW. SEE NOTE 4.
- (F) MONOLITHIC INTEGRAL CONCRETE CURB AND GUTTER
- (G) 4" TOPSOIL WITH BLOCK SODDING ON PARKWAYS AND MEDIANS. SEE NOTE 4.

- NOTES:
- 2% CROSS-SLOPE IS USUAL, UNLESS OTHERWISE SHOWN ON PLANS.
 - REFER TO DITCH LAYOUT PLANS FOR DITCH GRADING.
 - REFER TO CROSS SECTIONS FOR CUT AND EMBANKMENT SLOPE INFORMATION.
 - USE IMPORTED TOP SOIL WITHIN THE ROW AND ON EARTHEN CHANNEL SLOPES. USE TOP SOIL FROM THE PROJECT SITE FOR ALL OTHER AREAS OUTSIDE OF ROW. THE IMPORTED TOP SOIL SHALL MEET THE REQUIREMENTS OF C. O. G. SPEC 3.8.1 AND BE A CLAYEY SILT OR SILTY CLAY TYPE SOIL MEETING THE APPROVAL OF THE CITY FOR USE ON THIS PROJECT.

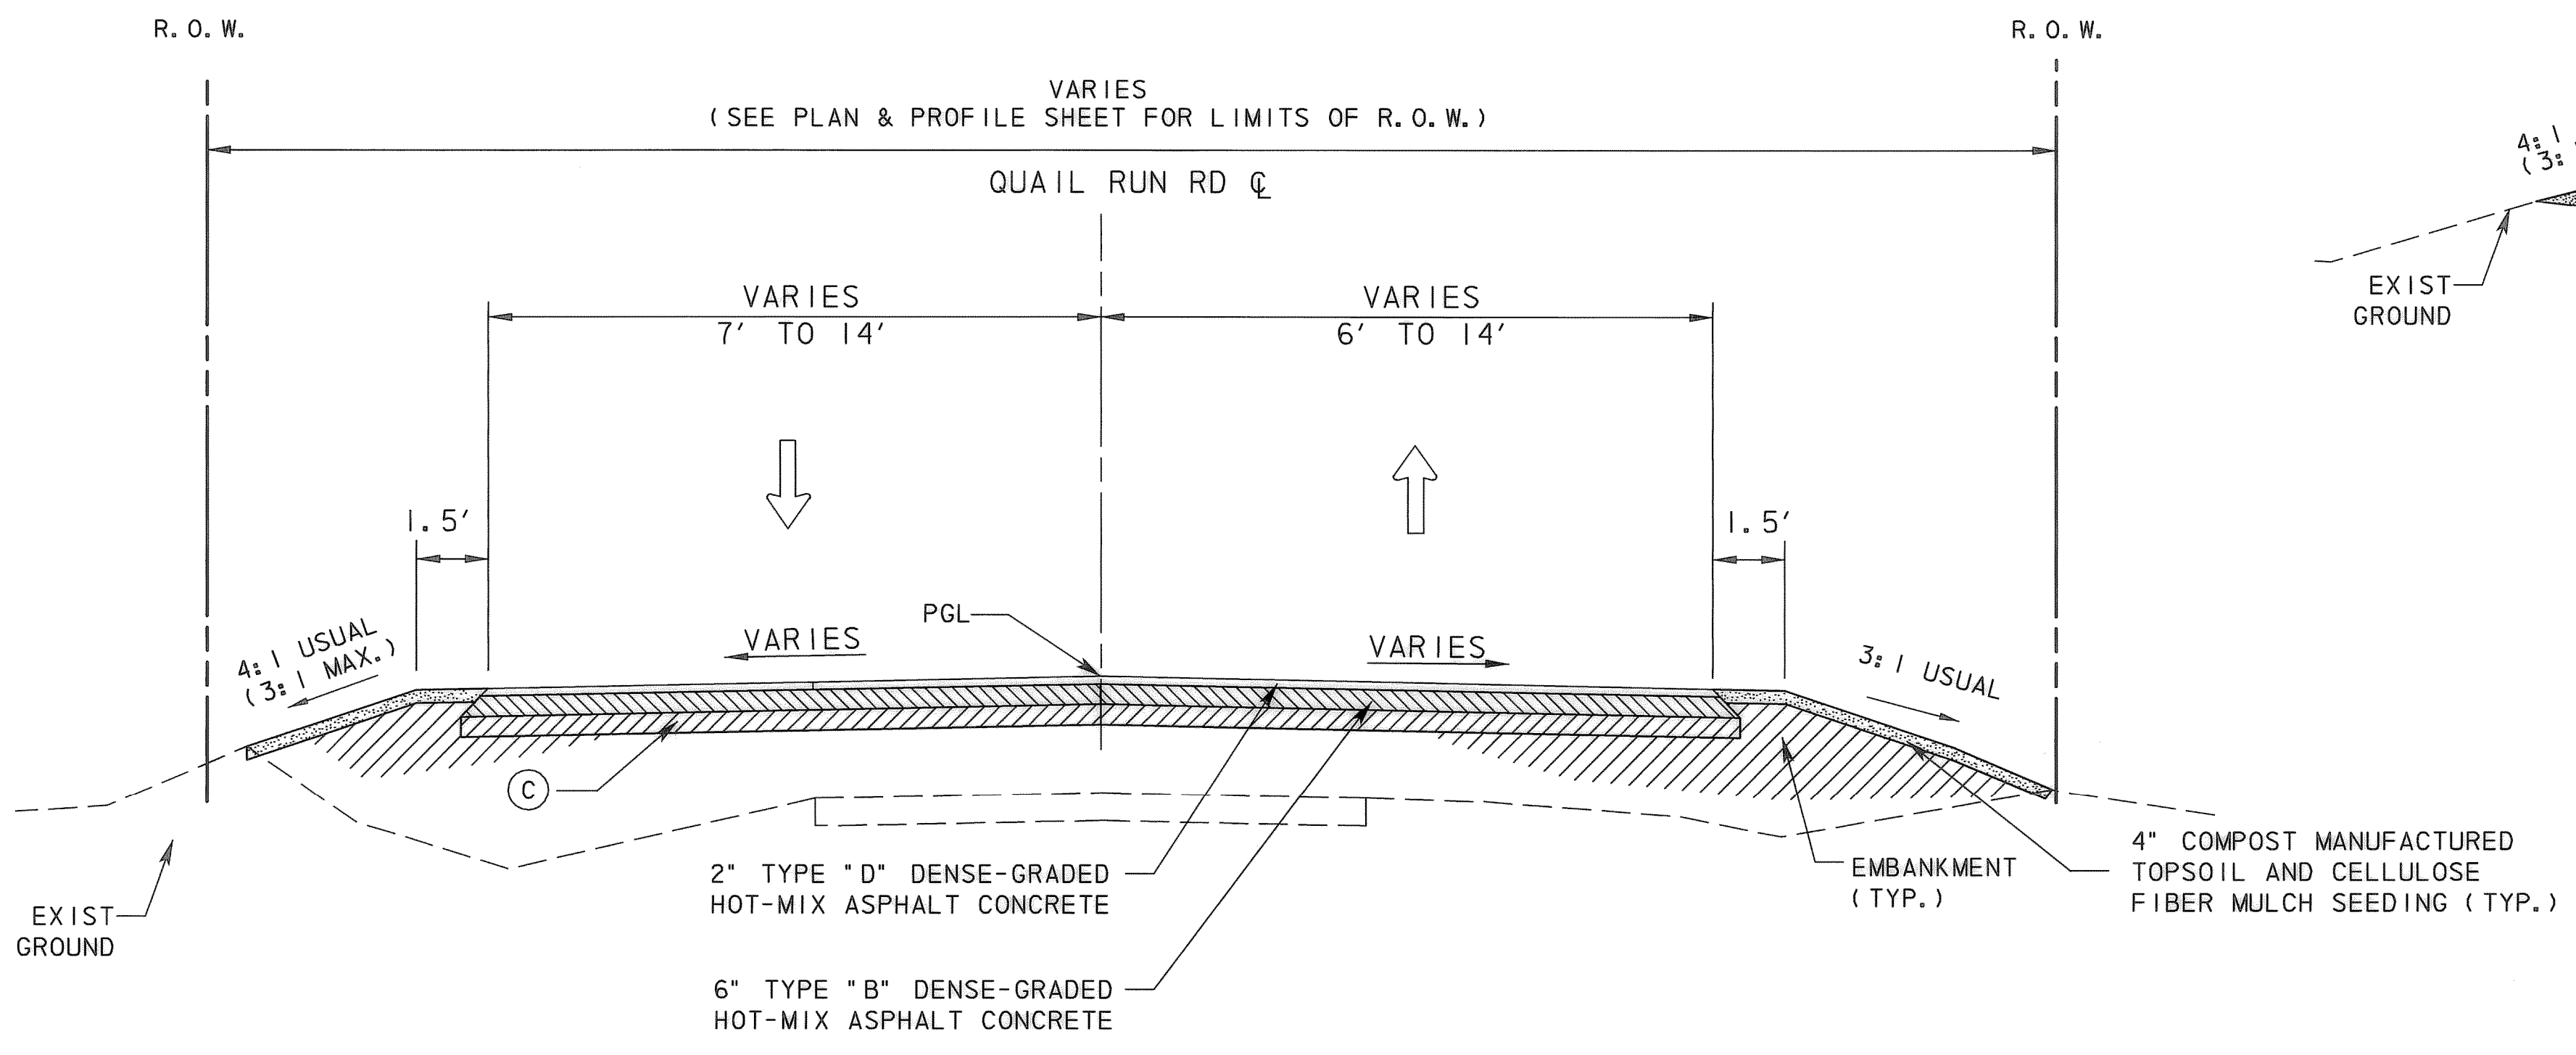

QUAIL RUN ROAD TRANSITION
STA 2+58.99 TO STA 4+18.46

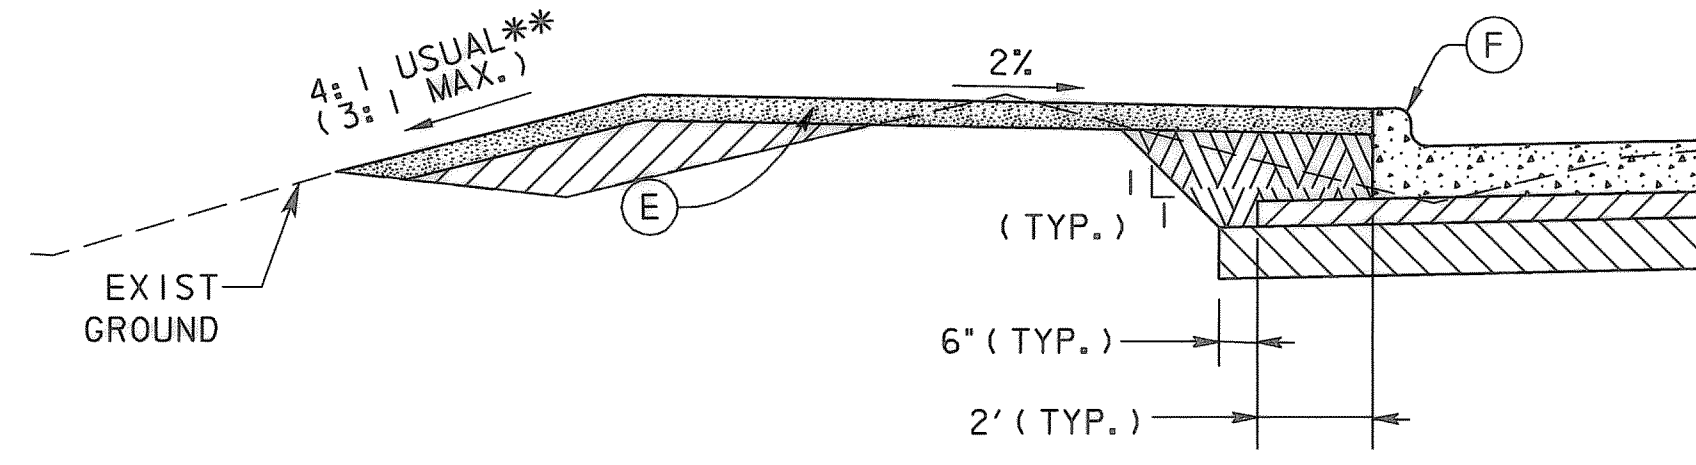

QUAIL RUN ROAD AT TURN OUT
TYPICAL CURB FILL TIE IN SECTION
N. T. S.

RECORD DRAWING
This drawing is a compilation of the original sealed engineering drawing and modifications by addenda, change orders and information furnished by the contractor. Information shown that was provided by the contractor and others not associated with the design engineer cannot be verified for accuracy or completeness. Original sealed drawing is on file at the office of AECOM USA Group, Inc., TBPE REG. NO. F-3082

ORIGINAL DRAWING SEALED & SIGNED BY
T.H. Gaertner, P.E.
TX NO. 37124

NO.	REVISION	BY	DATE

City of Rockwall, Texas

205 BYPASS
PHASE 4

TYPICAL SECTIONS
QUAIL RUN ROAD

2 OF 2

TCB | AECOM
TCB INC. WWW.TCB.AECOM.COM
17300 DALLAS PARKWAY, SUITE 1010
DALLAS, TEXAS 75248

Unit	PW-DAL-FW	Scale:	Horz: AS SHOWN Vert: AS SHOWN	Date	11/11/2009
Designed	THG	Checked	TCB	Project No.	60004153
Drawn	FG	Approved	TCB	Sheet	5 of 146

P:\4328\60004153-205Bypass\CADD\Sheets\Phase 4-120-00 to 141-00\Record Drawing 10-7-09\05Typical Sections-Quail Run Rd.dgn
 11/11/2009