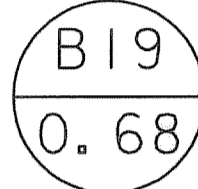
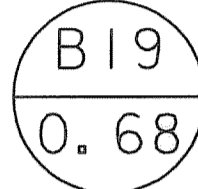
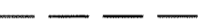

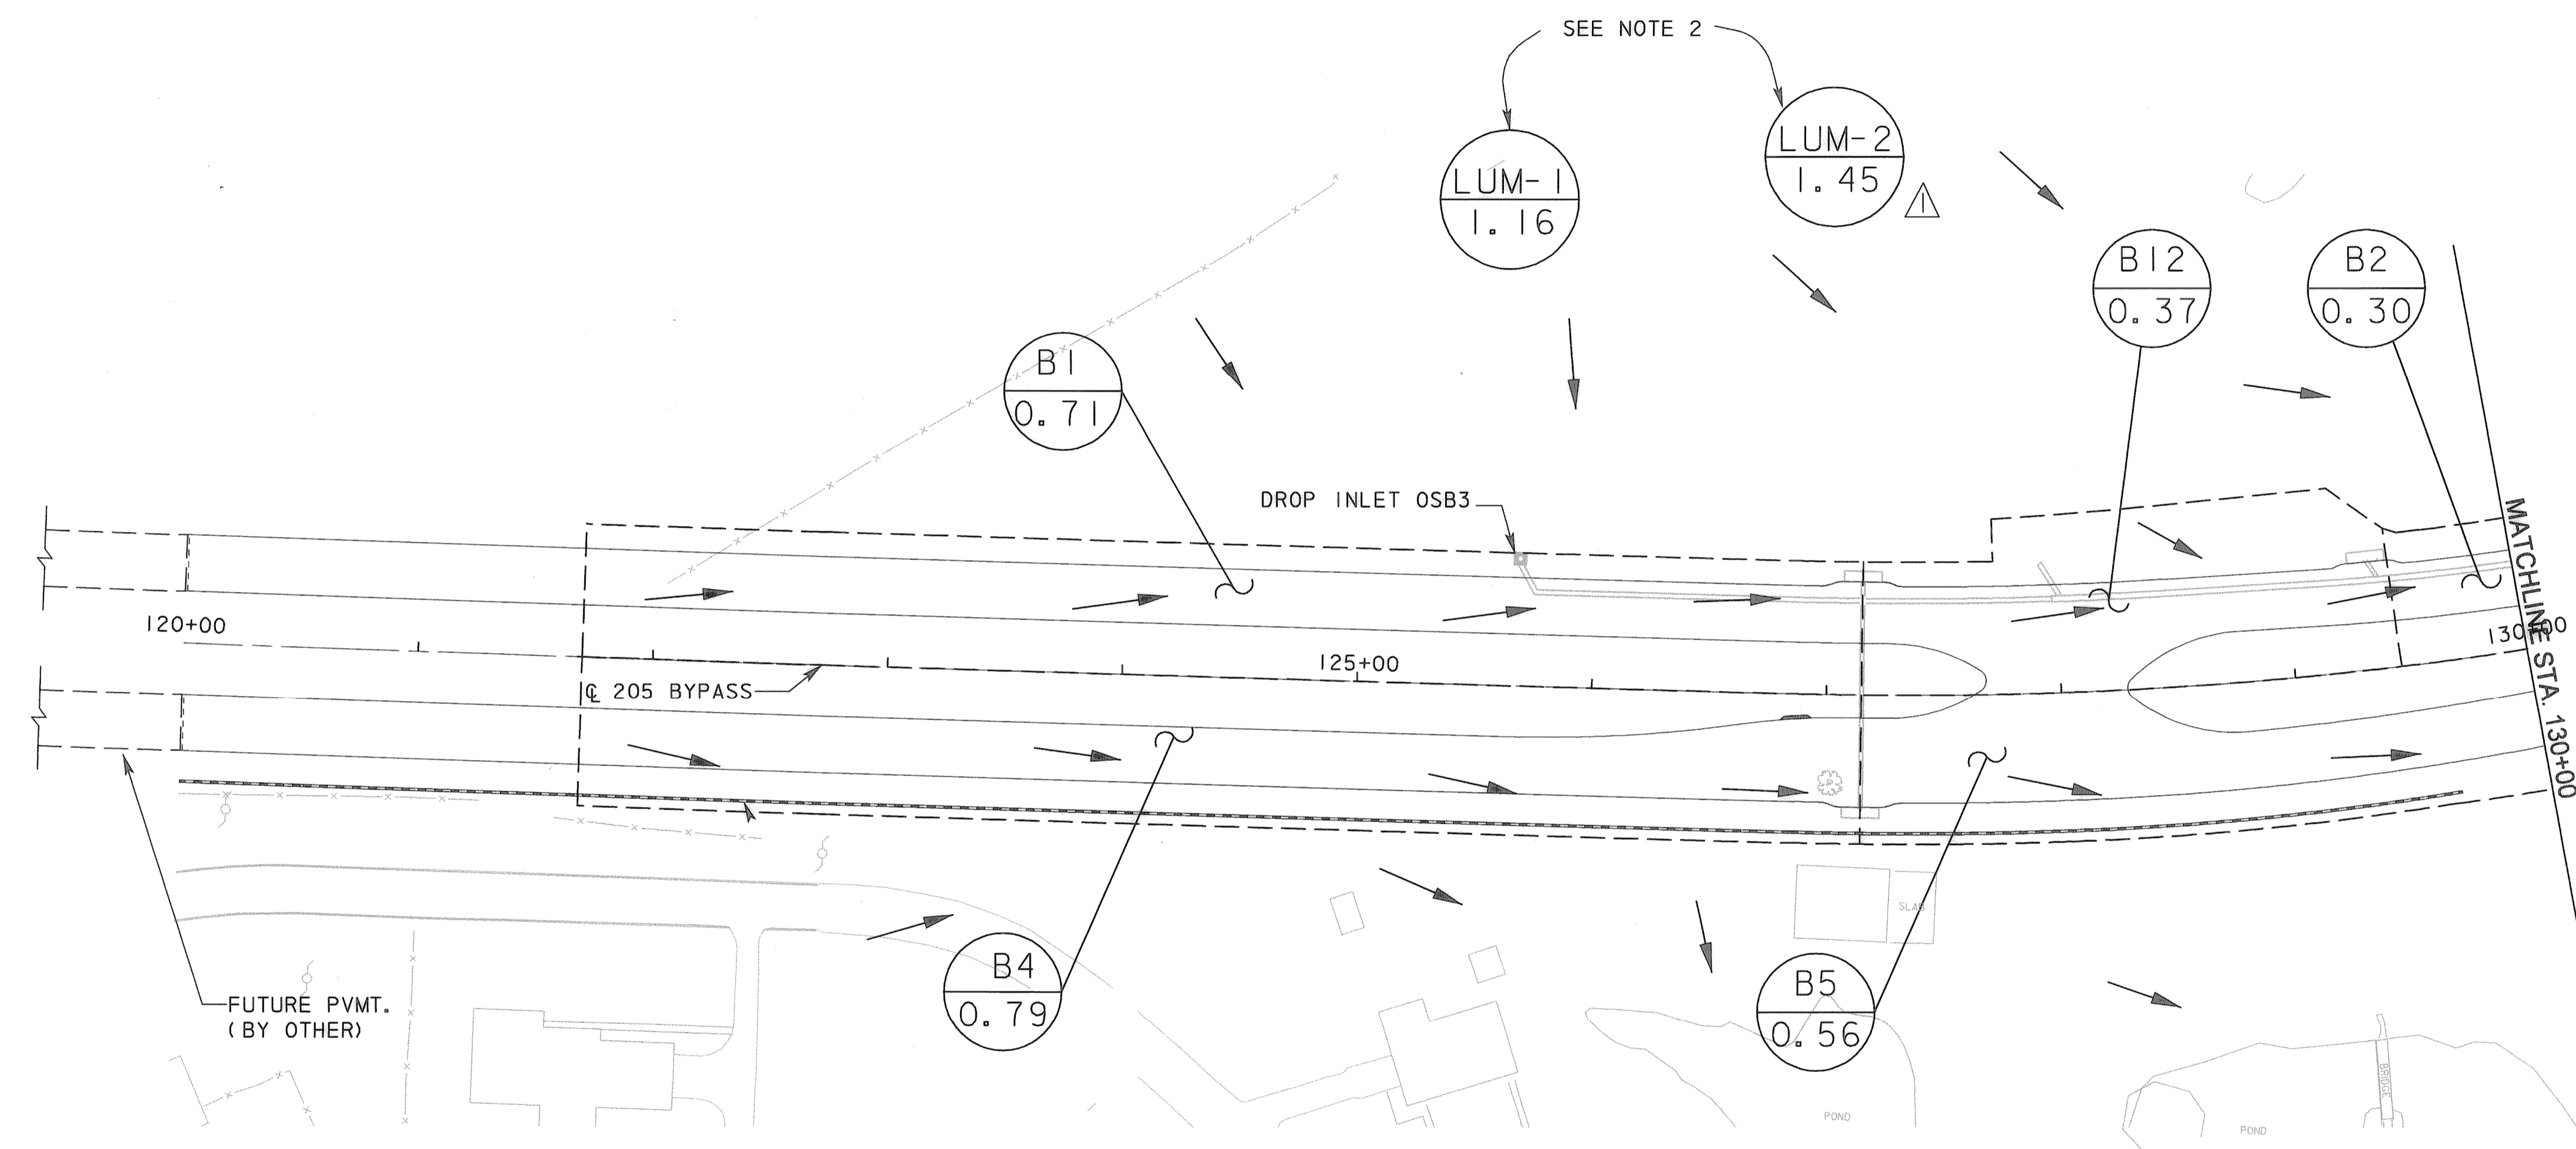


**LEGEND**

-  INLET DESIGNATION
-  AREA (AC)
-  INLET DRAINAGE BOUNDARY
-  SURFACE FLOW DIRECTION

**NOTES:**


1. SEE HYDRAULIC DATA SHEETS FOR GUTTER FLOW CALCULATIONS.
2. STORM DRAIN STUB OUTS SIZED FOR FUTURE DEVELOPED FLOWS FROM THESE AREAS ARE PROVIDED. DROP INLET OSB3 TEMPORARILY COLLECTS OFFSITE FLOW.



**RECORD DRAWING**  
 This drawing is a compilation of the original sealed engineering drawing and modifications by addenda, change orders and information furnished by the contractor. Information shown that was provided by the contractor and others not associated with the design engineer cannot be verified for accuracy or completeness. Original sealed drawing is on file at the office of AECOM USA Group, Inc., TBPE REG. NO. F-3082

**ORIGINAL DRAWING SEALED & SIGNED BY**  
 T.H. Gaertner, P.E.  
 TX NO. 37124

NO.	REVISION	BY	DATE
1	LUM-2 DRAINAGE AREA	THG	5/12/08

 **City of Rockwall, Texas**

**205 BYPASS  
 PHASE 4**

**DRAINAGE SYSTEM MAP  
 STA. 120+00 TO STA. 130+00**

1 OF 2

TCB   AECOM		TCB INC. WWW.TCB.AECOM.COM 17300 DALLAS PARKWAY, SUITE 1010 DALLAS, TEXAS 75248	
Unit: PW-DAL-FW	Scale: Horz: AS SHOWN Vert: AS SHOWN	Date: 11/11/2009	
Designed: SB	Checked: TCB	Project No: 60004153	
Drawn: FG	Approved: TCB	Sheet: 24 of 146	

P:\4328\60004153-205Bypass\CADD\Sheets\Phase 4-120+00 to 141+00\Record Drawing 10\_7\_09\024\Drawn\_syst-205B01.dgn  
 11/11/2009