

LEGEND

- INLET DESIGNATION
AREA (AC)
- INLET DRAINAGE BOUNDARY
- SURFACE FLOW DIRECTION

NOTES:

1. SEE HYDRAULIC DATA SHEETS FOR GUTTER FLOW CALCULATIONS.
2. TIE ON TO EXISTING STORM DRAIN CONSTRUCTION BY OTHERS FOR SECTION 1. EXISTING STORM DRAIN CARRIES FLOW FROM 34.2 ACRES. SEE HYDRAULIC DATA.
3. STORM DRAIN AND DROP INLET ARE SIZED FOR EXISTING CONDITIONS.
4. INLETS B7 AND B8 AND THE STORM DRAIN ARE SIZED FOR SOME OFFSITE FLOWS FOR EXISTING CONDITIONS.


RECORD DRAWING

This drawing is a compilation of the original sealed engineering drawing and modifications by addenda, change orders and information furnished by the contractor. Information shown that was provided by the contractor and others not associated with the design engineer cannot be verified for accuracy or completeness. Original sealed drawing is on file at the office of AECOM USA Group, Inc., TBPE REG. NO. F-3082

ORIGINAL DRAWING SEALED & SIGNED BY

T.H. Gaertner, P.E.
TX NO. 37124

| NO. | NOTES | THG | 5/12/08 |
|-----|----------|-----|---------|
| NO. | REVISION | BY | DATE |
| | | | |

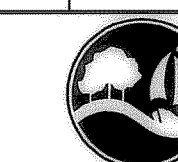

City of Rockwall, Texas

**205 BYPASS
PHASE 4**

**DRAINAGE SYSTEM MAP
STA. 130+00 TO STA. 141+00**

2 OF 2

TCB | AECOM
TCB INC. WWW.TCB.AECOM.COM
17300 DALLAS PARKWAY, SUITE 1010
DALLAS, TEXAS 75248

| | | | | | |
|----------|-----------|----------|----------------------------------|-------------|------------|
| Unit | PW-DAL-FW | Scale: | Horz: AS SHOWN Vert: AS SHOWN | Date | 11/11/2009 |
| Designed | SDB | Checked | TCB | Project No. | 60004153 |
| Drawn | FG | Approved | TCB | Sheet | 25 of 146 |

P:\4328\60004153-205Bypass\CADD\Sheets\Phase 4-120+00 to 141+00\Record Drawing 10_7_09\025Drain_syst-205B02.dgn
 11/11/2009

