


- NOTES:
1. ALL FITTINGS 4" AND LARGER SHALL BE DUCTILE IRON FITTINGS.
 2. MECHANICAL JOINTS SHALL USE A RESTRAINT GLAND, EBAA IRON INC. SERIES 2000 PV OR APPROVED EQUAL.
 3. ALL D. I. FITTINGS AND VALVES SHALL BE POLY WRAPPED.
 4. REFER TO THE CITY OF ROCKWALL SPECIAL PROVISIONS FOR REVISIONS MADE TO NORTH CENTRAL TEXAS STANDARD SPECIFICATION FOR PUBLIC WORKS CONSTRUCTION, THIRD EDITION, FOR THE EMBEDMENT- STANDARD DRAWING NO. 3030.
 5. REFER TO NORTH CENTRAL TEXAS STANDARD SPECIFICATIONS FOR PUBLIC WORKS CONSTRUCTION DRAWINGS, THIRD EDITION, FOR THRUST BLOCKS - STANDARD DRAWING 4020, 4030 AND 4040.
 6. INSTALL SERIES 1600 BELL RESTRAINT HARNESS FOR C900 PVC PIPE AT ALL BELL JOINTS. POLY WRAP BELL RESTRAINT HARNESS IF OUTSIDE OF CASING.

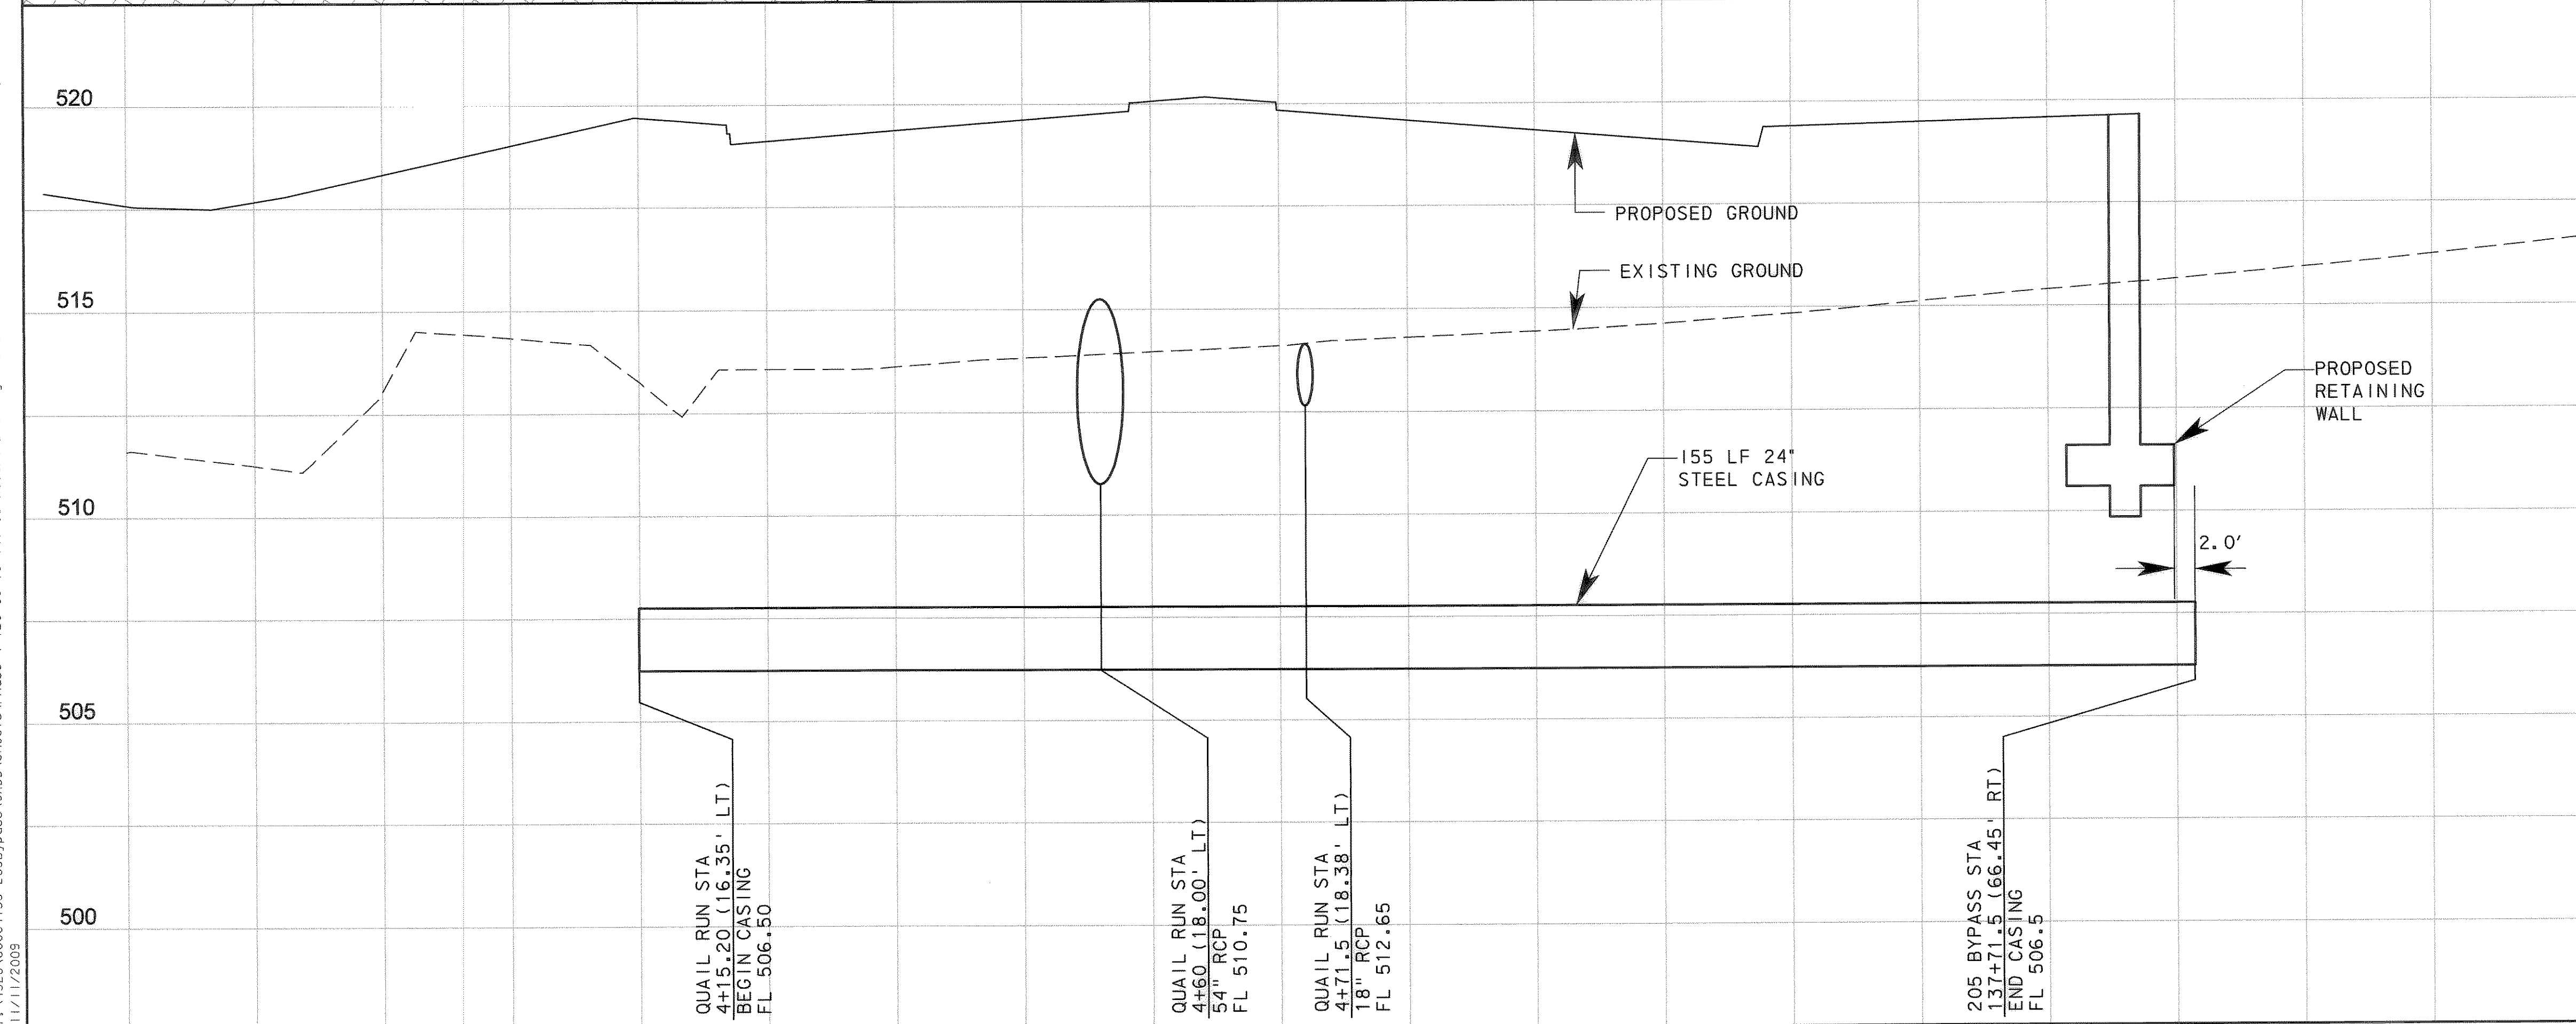


RECORD DRAWING

This drawing is a compilation of the original sealed engineering drawing and modifications by addenda, change orders and information furnished by the contractor. Information shown that was provided by the contractor and others not associated with the design engineer cannot be verified for accuracy or completeness. Original sealed drawing is on file at the office of AECOM USA Group, Inc., TBPE REG. NO. F-3082.

ORIGINAL DRAWING SEALED & SIGNED BY

T.H. Gaertner, P.E.
TX NO. 37124

NO.	REVISION	BY	DATE

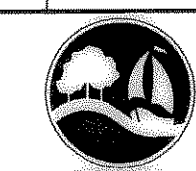

City of Rockwall, Texas

**205 BYPASS
PHASE 4**

**WATER LINE RELOCATION
QUAIL RUN RD (WEST)**

TCB | AECOM TCB INC. WWW.TCB.AECOM.COM
17300 DALLAS PARKWAY, SUITE 1010
DALLAS, TEXAS 75248

Unit	PW-DAL-FW	Scale	Horz: AS SHOWN Vert: AS SHOWN	Date	11/11/2009
Designed	THG	Checked	TCB	Project No.	60004153
Drawn	FG	Approved	TCB	Sheet	50B of 146

P:\4328\60004153\205Bypass\CADD\Sheets\Phase 4-120+00 to 141+00\Record Drawing 10_7_09_050BFP-Quail Runwaterreloc.dgn
 11/11/2009