GENERAL

- I. ALL WORK SHALL BE PERFORMED
 IN ACCORDANCE WITH THE STANDARD
 SPECIFICATIONS OF THE CITY OF
 ROCKWALL WHICH ADOPTED THE STANDARD
 SPECIFICATIONS OF PUBLIC WORKS CONSTRUCTION,
 NORTH CENTRAL, TEXAS, (COG), 3RD ADDITION
 WITH CITY AMENDMENTS. COPIES MAY BE
 OBTAINED FROM THE "NORTH CENTRAL COUNCIL OF
 GOVERNMENTS", 616 SIX FLAGS DR., P.O. BOX 5888,
 ARLINGTON. TEXAS 76005-5888. PH (817) 640-3300.
- 2. THESE PLANS, PREPARED BY TCB INC.,
 DO NOT EXTEND TO OR INCLUDE DESIGNS OR
 SYSTEMS PERTAINING TO THE SAFETY
 OF THE CONSTRUCTION CONTRACTOR OR ITS
 EMPLOYEES, AGENTS, OR REPRESENTATIVES IN THE
 PERFORMANCE OF THE WORK. THE SEAL OF TCB'S
 REGISTERED PROFESSIONAL ENGINEER(S)
 HEREON DOES NOT EXTEND TO ANY SUCH SAFETY
 SYSTEMS THAT MAY NOW OR HEREAFTER BE
 INCORPORATED IN THE WORK. THE CONSTRUCTION
 CONTRACTOR IS TO PREPARE OR OBTAIN THE
 APPROPRIATE SAFETY SYSTEMS, INCLUDING THE
 PLANS AND SPECIFICATIONS.
- THE CONTRACTOR SHALL ABIDE BY ALL APPLICABLE LOCAL, STATE, AND FEDERAL LAWS GOVERNING EXCAVATION. TRENCH SIDE SLOPES SHALL MEET OCCUPATIONAL SAFETY AND HEALTH ADMINISTRATION (OSHA) STANDARDS THAT ARE IN EFFECT AT THE TIME OF CONSTRUCTION. SHEETING, SHORING, AND BRACING WILL BE REQUIRED WHEN SIDE SLOPE STANDARDS ARE NOT MET. A TRENCH PULL BOX, MEETING OSHA STANDARDS, WILL BE ACCEPTABLE. THE APPARENT LOW BIDDER WILL SUBMIT DETAILED PLANS AND SPECIFICATIONS FOR TRENCH SAFETY SYSTEMS WHEN TRENCH EXCAVATION WILL EXCEED A DEPTH OF FIVE (5) FEET THAT MEET OSHA STANDARDS THAT ARE IN EFFECT AT THE TIME OF CONSTRUCTION.
- 4. ALL CONSTRUCTION OPERATIONS ARE TO BE ACCOMPLISHED IN ACCORDANCE WITH APPLICABLE REGULATIONS OF THE OSHA. COPIES OF OSHA STANDARDS
 MAY BE PURCHASED FROM THE U.S. GOVERNMENT
 PRINTING OFFICE; INFORMATION AND RELATED
 REFERENCE MATERIALS MAY BE OBTAINED FROM
 OSHA, 903 SAN JACINTO, AUSTIN, TEXAS.
- 5. THE CONTRACTOR SHALL OBTAIN ALL CONSTRUCTION PERMITS REQUIRED FROM THE CITY OF ROCKWALL PRIOR TO COMMENCEMENT OF WORK. NO EXTRA PAY
- 6. THE CITY OF ROCKWALL IS TO BE NOTIFIED BY TELEPHONE (972-771-7746) AT LEAST 48 HOURS IN ADVANCE OF ALL CONSTRUCTION, FOLLOWED BY A LETTER OF CONFIRMATION.
- 7. THE CONTRACTOR SHALL GIVE NOTICE TO ALL AUTHORIZED INSPECTORS, SUPERINTENDENTS, OR PERSONS IN CHARGE OF PRIVATE AND PUBLIC UTILITIES AFFECTED BY THESE OPERATIONS PRIOR TO COMMENCEMENT OF WORK. NO EXTRA PAY ITEM.
- 8. THE CONTRACTOR SHALL VERIFY ALL CONDITIONS
 AND DIMENSIONS AT THE JOB SITE AND NOTIFY THE
 OWNER'S REPRESENTATIVE OF ANY OMISSIONS,
 DISCREPANCIES, OR DIMENSIONAL ERRORS PRIOR TO
 BEGINNING OR FABRICATING ANY WORK OR
 MATERIALS. OTHERWISE THE CORRECTIONS (AND
 ASSOCIATED COST) WILL BE THE RESPONSIBILITY
 OF THE CONTRACTOR. NO EXTRA PAY ITEM.
- 9. THE CONTRACTOR IS TO TAKE ALL DUE PRECAUTIONS TO PROTECT EXISTING FACILITIES FROM DAMAGE. ANY DAMAGE TO EXISTING FACILITIES INCURRED AS A RESULT OF THESE CONSTRUCTION OPERATIONS ARE TO BE REPAIRED IMMEDIATELY BY THE CONTRACTOR TO AT LEAST THE PRE-EXISTING CONDITION AT THE CONTRACTOR'S EXPENSE.
- 10. THE CONTRACTOR SHALL BE RESPONSIBLE FOR RE-PAIRING ANY DAMAGE CAUSED BY THESE CONSTRUC-TION OPERATIONS OUTSIDE THE DESIGNATED WORK AREA WITH EQUAL OR BETTER QUALITY MATERIAL AT THE CONTRACTOR'S EXPENSE.

GENERAL CONSTRUCTION NOTES

- II. ALL EXISTING MONUMENTS, PROPERTY PINS, OR IRON RODS SHALL BE PRESERVED BY THE CONTRACTOR. IF ANY OF THESE ITEMS NEEDS TO BE REMOVED OR DISRUPTED TO ACCOMMODATE CONSTRUCTION, THE CONTRACTOR SHALL BE FULLY RESPONSIBLE FOR REPLACING IT BACK TO ITS ORIGINAL LOCATION AND/OR ELEVATION AT THE CONTRACTOR'S EXPENSE.
- 12. NO TREES SHALL BE CUT OR REMOVED EXCEPT ON SPECIFIC APPROVAL BY THE CITY OF ROCKWALL. ANY TREES THAT ARE APPROVED FOR REMOVAL MUST BE REMOVED IN A MANNER WHICH DOES NOT IMPACT TREES THAT ARE TO BE PRESERVED. NO EXTRA PAY ITEM.
- 13. THE CONTRACTOR IS RESPONSIBLE FOR THE REMOVAL AND DISPOSAL OF STUMPS, ROOTS, AND VEGETATION FROM THE PROJECT SITE. NO EXTRA PAY ITEM.
- 14. ALL TREES, BUSHES, AND BRUSH THAT MUST BE REMOVED IN ORDER TO PROCEED WITH CONSTRUCTION SHALL BE CONSIDERED INCIDENTAL TO CONSTRUCTION AND NOT MEASURED SEPARATELY FOR PAYMENT.
- 15. VEGETATION MUST BE PRUNED TO PROVIDE CLEAR-ANCE FOR STRUCTURES, VEHICULAR TRAFFIC, AND EQUIPMENT BEFORE DAMAGE OCCURS (RIPPING OF BRANCHES, ETC.). ALL FINISHED PRUNING IS TO BE DONE ACCORDING TO RECOGNIZED, APPROVED STANDARDS OF THE INDUSTRY (REFER TO THE "NATIONAL ARBORIST ASSOCIATION PRUNING STANDARDS FOR SHADE TREES"). NO EXTRA PAY ITEM.
- 16. THE CONTRACTOR IS TO COMPLY WITH ALL APPLICA-BLE LOCAL, STATE, AND FEDERAL REQUIREMENTS REGARDING EXCESS AND WASTE MATERIAL, INCLUDING METHODS OF HANDLING AND DISPOSAL.
- 17. THE LOCATION FOR THE DISPOSAL OF CONSTRUCTION MATERIAL SHALL BE APPROVED BY THE CITY OF ROCKWALL DEPARTMENT OF ENGINEERING AND PUBLIC WORKS PRIOR TO THE START OF CONSTRUCTION.
- 18. MATERIAL MAY NOT BE STOCKPILED WITHIN THE 100-YEAR FLOODPLAIN.
- 19. INTENTIONAL RELEASE OF VEHICLE OR EQUIPMENT FLUIDS ONTO THE GROUND IS NOT ALLOWED. CONTAMINATED SOIL RESULTING FROM AN ACCIDENTAL SPILL IS TO BE REMOVED AND DISPOSED OF PROPERLY AT THE CONTRACTOR'S EXPENSE.

CONSTRUCTION

- I. THE CONTRACTOR SHALL NOTIFY THE CITY OF ROCKWALL DEPARTMENT OF ENGINEERING AND PUBLIC WORKS BY TELEPHONE (972-771-7746) AT LEAST 48 HOURS IN ADVANCE FOR ALL WATER OR WASTEWATER MODIFICATIONS, LOCATES, OR TURNOFFS.
- 2. ONLY THE CITY OF ROCKWALL WATER DEPARTMENT SHALL OPERATE EXISTING WATER VALVES. CONTACT THE WATER DEPARTMENT AT 972-771-7730 FOR ASSISTANCE AT LEAST 24 HOURS IN ADVANCE (EXCEPT IN THE CASE OF AN EMERGENCY).
- 3. FIELD ADJUSTMENTS MAY BE NECESSARY AND SHALL BE CARRIED OUT AS DIRECTED BY THE ENGINEER AT NO EXTRA PAY.
- 4. A MINIMUM OF 48 INCHES OF COVER IS REQUIRED OVER ALL UTILITY LINES. NO EXTRA PAY ITEM. THE CONTRACTOR SHALL USE CITY STANDARD DRAWING 3030 FOR CLASS B-3 PIPE EMBEDMENT, UNLESS OTHERWISE SHOWN IN PLANS.
- 5. COMPACTION OF BACKFILL MATERIAL BY FLOODING OR JETTING WILL NOT BE PERMITTED.
- 6. THE CONTRACTOR MUST OBTAIN A CONSTRUCTION METER THROUGH THE CITY OF ROCKWALL AND PAY FOR THE WATER USED FOR DUST CONTROL AND CONCRETE BATCH PLANT. NO EXTRA PAY ITEM.
- 7. THROUGHOUT THE CONSTRUCTION, AND AT THE COMPLETION OF CONSTRUCTION, THE CONTRACTOR IS TO
 ASSURE THAT DRAINAGE OF STORMWATER RUNOFF IS
 NOT BLOCKED. THE CONTRACTOR IS TO LEVEL
 WASHES, RUTS, DEPRESSIONS, AND MOUNDS TO GIVE
 THE AREA A SMOOTH FINISH. NO EXTRA PAY ITEM.
- 8. THE CONTRACTOR IS TO MAINTAIN ACCESS TO PUBLIC AND PRIVATE FACILITIES DURING CONSTRUCTION. CONSTRUCTION ACTIVITIES ARE TO BE COORDINATED WITH THE OWNER, OWNER'S REPRESENTATIVE, AND THE CITY OF ROCKWALL. NO EXTRA PAY ITEM.

- 9. THE CONTRACTOR SHALL REPAIR ANY DAMAGE TO EXISTING IRRIGATION SYSTEMS WITH NEW MATERIALS. IRRIGATION HEADS, VALVES, AND METERS MAY BE TEMPORARILY REMOVED TO ALLOW FOR CONSTRUCTION OF THE PROJECT. IRRIGATION HEADS, VALVES, AND METERS SHALL BE REPLACED IN THE SAME LOCATION AND IN WORKING ORDER. NO EXTRA PAY ITEM.
- 10. THE CONTRACTOR MUST NOTIFY EACH PROPERTY OWNER AND CITY 24 HOURS PRIOR TO SHUTTING OFF WATER FOR CONNECTION TO NEW MAIN.
- II. THE CONTRACTOR SHALL MAINTAIN THE EXISTING WATER MAINS IN SERVICE DURING ALL PHASES OF CONSTRUCTION AT NO EXTRA PAY. LEAKS CAUSED BY THE CONTRACTOR SHALL BE REPAIRED IMMEDIATELY AT THE CONTRACTOR'S EXPENSE.
- 12. ALL SALVAGEABLE MATERIALS (VALVES, FIRE HYDRANTS, VALVE BOXES, ETC.) SHALL BE DELIVERED TO THE CITY OF ROCKWALL PUBLIC WORKS YARD. ALL NON-SALVAGEABLE MATERIALS TO BECOME PROPERTY OF THE CONTRACTOR AND TO BE DISPOSED OF OFFSITE.
- 13. THE MAXIMUM DEFLECTION OF PIPE JOINTS SHALL NOT EXCEED THAT RECOMMENDED BY THE PIPE MANUFACTURER. IF IT IS NECESSARY TO DEFLECT THE PIPE GREATER THAN THE RECOMMENDED AMOUNT, THE CONTRACTOR SHALL PROVIDE FITTINGS. THERE SHALL BE NO ADDITIONAL COMPENSATION ALLOWED.
- 14. THE CONTRACTOR SHALL INSTALL BLUE ELECTRONIC MARKER SYSTEM (EMS) LOCATOR PADS ALONG THE WATER LINE EVERY 250', AT VALVES, AT CHANGES IN DIRECTION, AND AT SERVICES. NO EXTRA PAY ITEM.
- IS. ALL AREAS DISTURBED BY CONTRACTOR SHALL BE RESTORED TO THE SAME OR BETTER CONDITION THAN BEFORE START OF CONSTRUCTION.
- 16. CONCRETE TESTING SHALL BE PERFORMED PER CITY OF ROCKWALL STANDARDS. CONCRETE FOR PAVING SHALL BE 5000 PSI CONCRETE, MINIMUM 7 SACKS FOR MACHINE FINISH AND MINIMUM 71/2 SACKS FOR HAND FINISH. CONCRETE FOR STRUCTURES, MANHOLES, INLETS, AND CULVERTS SHALL BE 4200 PSI. NO FLY ASH IS ALLOWED IN CONCRETE FOR STRUCTURES.
- 17. COMPACTION WITH A "SHEEP'S FOOT ROLLER" IS REQUIRED.

UTILITY

- I. THE LOCATION AND DEPTH OF ALL EXISTING UTILITIES SHOWN ON THE PLANS ARE APPROXIMATE AND THERE MAY BE OTHER UNKNOWN UTILITIES EXISTING NOT SHOWN ON THE PLANS THAT SHALL BE VERIFIED AND PROTECTED BY THE CONTRACTOR PRIOR TO COMMENCEMENT OF CONSTRUCTION. NO EXTRA PAY ITEM.
- 2. THE CONTRACTOR SHALL BE RESPONSIBLE FOR PROTECTING ALL UTILITIES ENCOUNTERED DURING CONSTRUCTION OPERATIONS.

 ANY DAMAGE TO UTILITIES DONE BY THE CONTRACTOR DURING CONSTRUCTION SHALL BE REPAIRED TO THE SATISFACTION OF THE UTILITY OWNER AND THE CITY OF ROCKWALL AT THE ENTIRE EXPENSE OF THE CONTRACTOR.
- 3. THE CONTRACTOR SHALL COORDINATE INTERRUPTIONS OF ALL UTILITIES AND SERVICES WITH THE APPLICABLE UTILITY COMPANIES AND/OR AGENCIES. ALL WORK IS TO BE DONE IN ACCORDANCE WITH THE REQUIREMENTS OF THE APPLICABLE UTILITY COMPANY OR AGENCY INVOLVED. THE CONTRACTOR SHALL CONTACT THE TEXAS ONE-CALL SYSTEM FOR UTILITY LOCATIONS PRIOR TO ANY WORK IN PUBLIC EASEMENTS OR RIGHT-OF-WAY AT 1-800 545-6005.

TXU GAS
TXU ELECTRIC
TIME WARNER
VERIZON COMMUNICATIONS
AT&T
MT ZION

800-344-8377
972-888-1302
972-445-6200
972-318-5276
214-745-8200
972-722-3203

- 4. WHEN AN UNLOCATED OR INCORRECTLY LOCATED UNDERGROUND UTILITY OR A BREAK IN A UTILITY IS ENCOUNTERED DURING SITE WORK OPERATIONS, THE CONTRACTOR IS TO NOTIFY THE APPLICABLE UTILITY COMPANY IMMEDIATELY TO OBTAIN PROCEDURE DIRECTIONS. NO EXTRA PAY ITEM.
- 5. THE CONTRACTOR SHALL BE REQUIRED TO ARRANGE TEMPORARY/
 PERMANENT RELOCATION, SUPPORT AND/OR PROTECT ALL POWER,
 ELECTRIC, TELEPHONE, OR LIGHT POLES THAT MAY INTERFERE WITH
 CONSTRUCTION. COORDINATION WITH THE VARIOUS UTILITY COMPANIES
 SHALL BE THE CONTRACTOR'S RESPONSIBILITY. NO EXTRA PAY ITEM.
- 6. CONTRACTOR IS RESPONSIBLE FOR PERSONNEL SAFETY IN PROXIMITY OF OVERHEAD POWER UTILITIES. CONTRACTOR SHALL ARRANGE FOR POLE RELOCATIONS OR DEENERGIZING LINES AS NEEDED. NO EXTRA PAY ITEM.

TRAFFIC CONTROL

- I. THE CONTRACTOR IS RESPONSIBLE FOR PLACEMENT AND MAINTENANCE OF ALL NECESSARY BARRICADES AS REQUIRED BY THE CITY OF ROCKWALL. CONTRACTOR SHALL PROVIDE, INSTALL, AND MAINTAIN TRAFFIC CONTROL DEVICES IN CONFORMANCE WITH THE LATEST TEXAS MANUAL OF UNIFORM TRAFFIC CONTROL DEVICES (TMUTCD) AND LATEST REVISIONS.
- 2. NO STOP OR YIELD SIGN IS TO BE RELOCATED OR REMOVED WITHOUT PRIOR APPROVAL BY THE CITY. THE CONTRACTOR MUST CALL THE CITY DEPARTMENT OF PUBLIC WORKS, AND OBTAIN PERMISSION FOR ANY CHANGES IN THESE SIGNS.
- 3. TWO-WAY TRAFFIC MUST BE MAINTAINED AT ALL TIMES ON EXISTING ROADS OF THIS PROJECT UNLESS SPECIFIED OTHERWISE IN THE PLANS AND SPECIFICATIONS.


 THE TRAVELWAY WIDTH SHALL NOT BE LESS THAN 10 FEET.
- 4. ACCESS TO ABUTTING PROPERTY DURING THE CONSTRUCTION OF THIS PROJECT MUST BE MAINTAINED FOR EMERGENCY AND LOCAL TRAFFIC AT ALL TIMES.
- 5. ALL WORK IN TXDOT ROW SHALL MEET TXDOT TRAFFIC STANDARDS.
- 6. MAINTENACE OF TRAFFIC CONTROL SYSTEM AND TEMPORARY PAVEMENT IS THE RESPONSIBILITY OF THE CONTRACTOR, NO SEPERATE PAY ITEM.

STORM WATER POLLUTION PREVENTION


- I. UNLESS OTHERWISE NOTED, ALL STORM WATER POLLUTION PREVENTION MEASURES SHALL CONFORM TO THE CITY OF ROCKWALL STANDARDS OR TO APPLICABLE GUIDELINES SHOWN ON PLANS.
- 2. CONTRACTOR IS RESPONSIBLE FOR MAINTAINING SURFACE DRAINAGE AND EROSION CONTROL FACILITIES ON SITE DURING CONSTRUCTION.
- 3. THE CONTRACTOR IS RESPONSIBLE FOR KEEPING STREETS AND SIDEWALKS ADJACENT TO THE PROJECT FREE OF MUD AND DEBRIS FROM THE CONSTRUCTION AT ALL TIMES.
- 4. CONTRACTOR IS RESPONSIBLE FOR OBTAINING AND COMPLETING ANY APPLICABLE LOCAL, STATE, OR FEDERAL PERMITTING REQUIREMENTS WHICH MAY APPLY, INCLUDING THE SWPPP. NO EXTRA PAY ITEM.
- 5. CONTRACTOR SHALL PROVIDE CONSTRUCTION ENTRANCE/EXITS AT ALL ACCESS POINTS TO THE PROJECT

RECORD DRAWING

This drawing is a compilation of the original sealed engineering drawing and modifications by addenda, change orders and information furnished by the contractor. Information shown that was provided by the contractor and others not associated with the design engineer cannot be verified for accuracy or completeness. Original sealed drawing is on file at the office of AECOM USA Group, Inc., TBPE REG. NO. F-3082

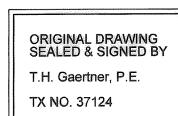

• • • • • • • • • • • • • • • • • • • •			
NO.	REVISION	BY	DATE

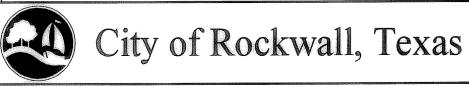

PHASE 4

GENERAL CONSTRUCTION NOTES

205 BYPASS

TCB AECOM WWW.TCB.AECOM.COM 17300 DALLAS PARKWAY, SUITE 1010 DALLAS, TEXAS 75248

Unit PW-DAL-FW Scale: Horz: AS SHOWN Date 11/11/2009

 Unit
 PW-DAL-FW
 Scale:
 Vert:
 AS SHOWN
 Date
 11/11/2009

 Designed
 THG
 Checked
 TCB
 Project No.
 60004153

 Drawn
 FG
 Approved
 TCB
 Sheet
 6 of 146

4|55-205Bypass\CADU\Shee†s\Phase 4-|20+00 †o |4|+00\Kecord Urawing |0_7_09\006Gene