

RETAINING WALL TYPE (A) DETAIL
N. T. S.


- NOTES:
- TOP OF TYPE (B) RETAINING WALL PROFILE SAME AS PVMT. PROFILE. SEE RETAINING WALL PLAN SHEETS FOR DETAILS.
 - TOP OF TYPE (A) RETAINING WALL AS SHOWN IN PAVING PROFILE. SEE RETAINING WALL TYPE (A) DETAIL ABOVE.
 - CONSTRUCT LANDSCAPE MAINTENANCE RAMP. SEE MISCELLANEOUS ROADWAY DETAILS SHEET.
 - CONSTRUCT BRICK PAVERS. SEE MISCELLANEOUS ROADWAY DETAILS SHEET.

CURVE DATA					
NO.	Δ	D	R	T	L
205BP-1	08° 58' 01.21"	03° 16' 50.18"	1746.50'	136.95'	273.33'
205BP-2	17° 02' 45.09" (LT)	05° 12' 31.35"	1100.00'	164.85'	327.26'

- LEGEND
- CONCRETE PAVEMENT
 - HMAC PAVEMENT
 - RECESSED CURB INLET
 - DROP INLET TYPE H

RECORD DRAWING
This drawing is a compilation of the original sealed engineering drawing and modifications by addenda, change orders and information furnished by the contractor. Information shown that was provided by the contractor and others not associated with the design engineer cannot be verified for accuracy or completeness. Original sealed drawing is on file at the office of AECOM USA Group, Inc., 'BPE REG. NO. F-3082'

ORIGINAL DRAWING SEALED & SIGNED BY
T.H. Gaertner, P.E.
TX NO. 37124

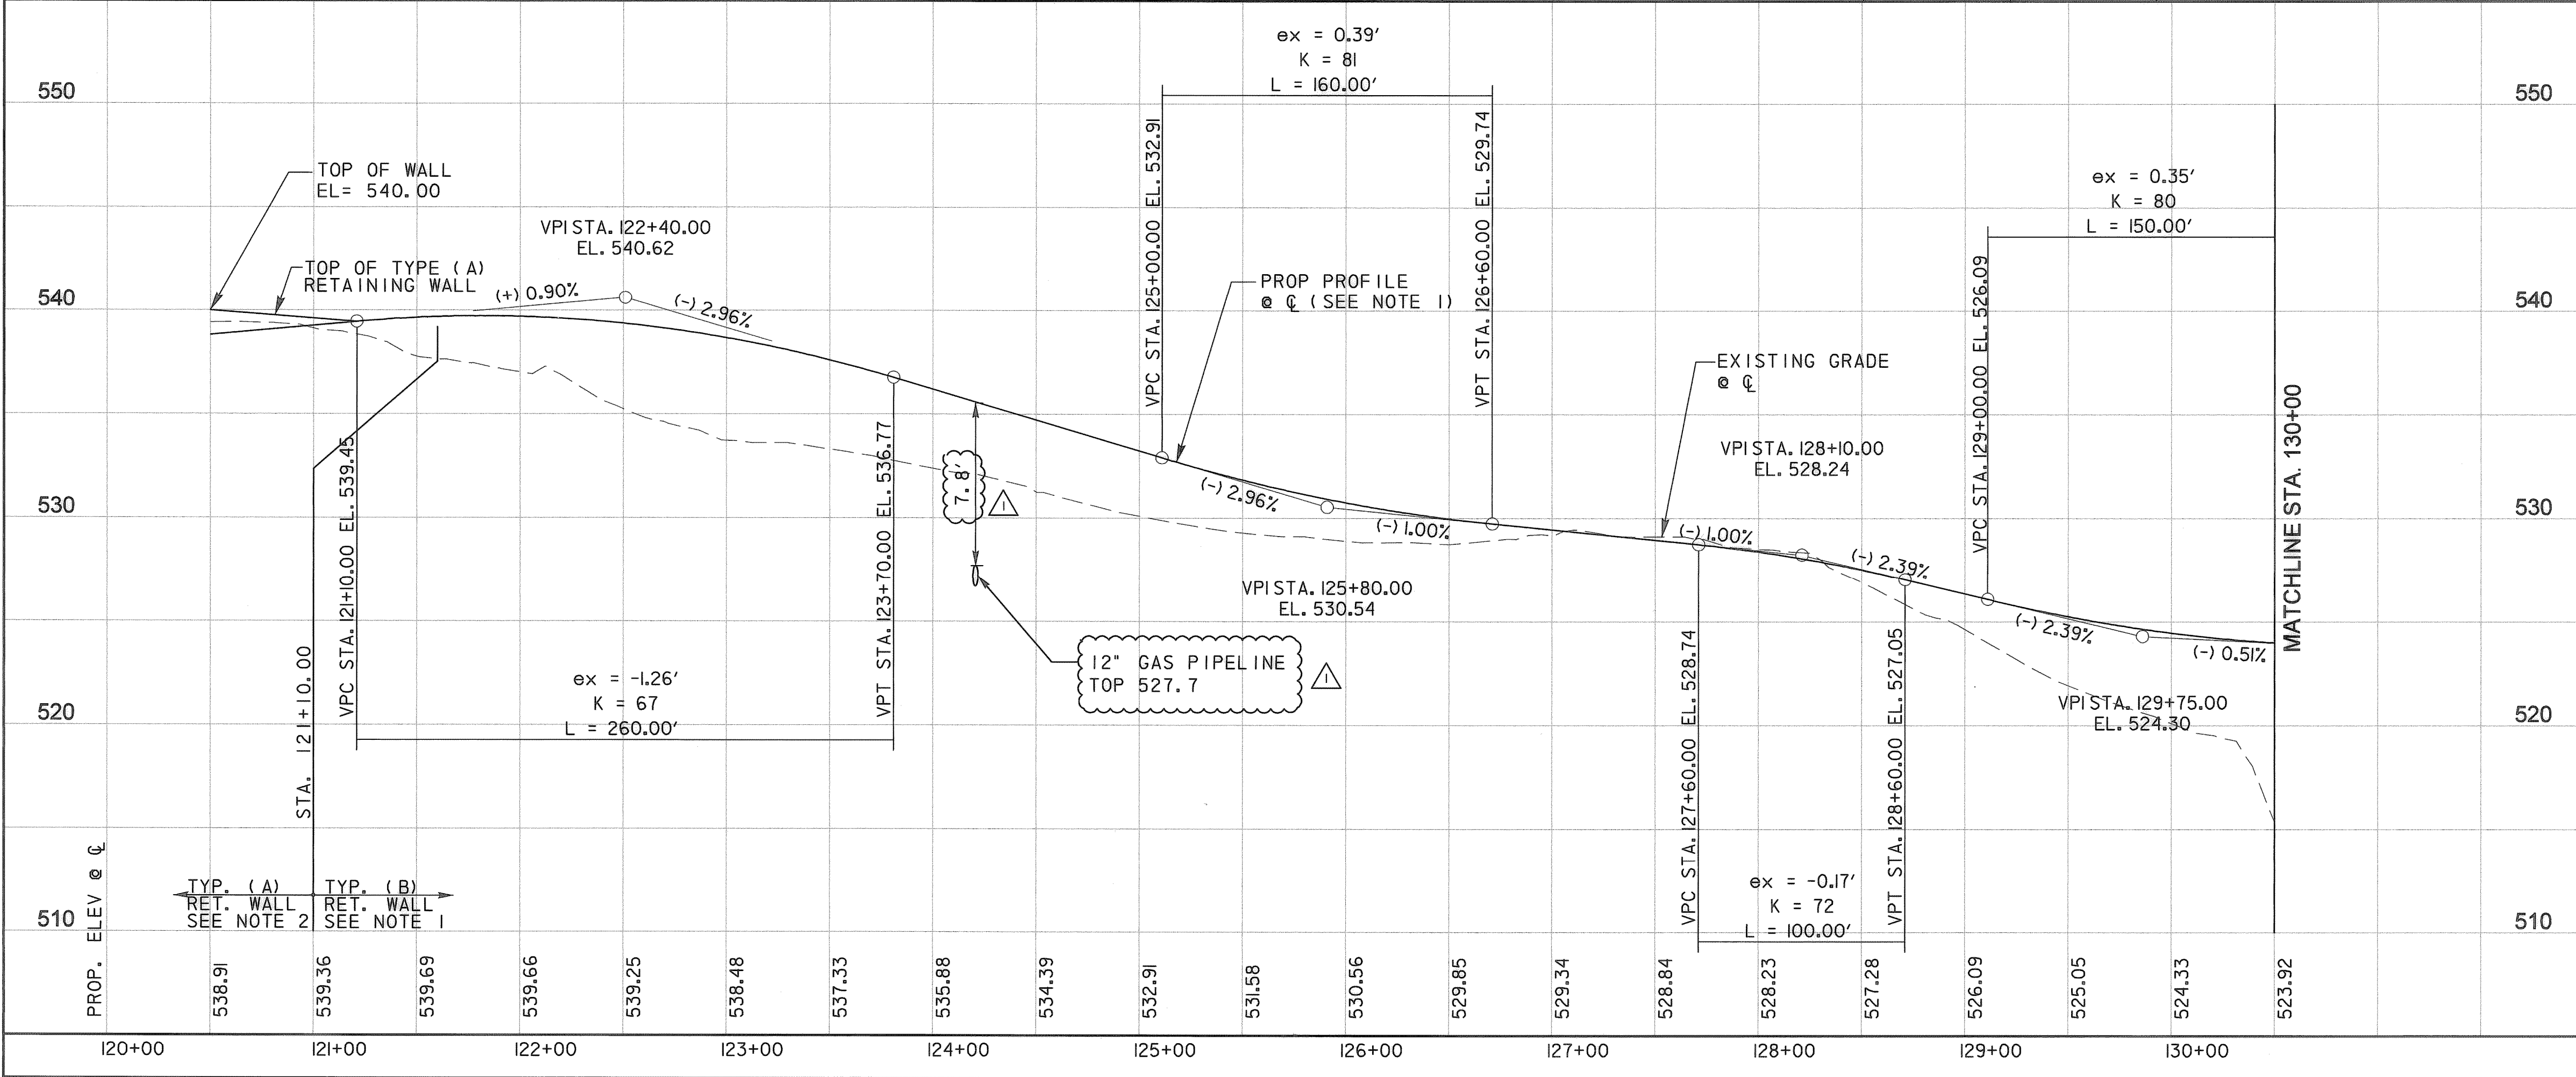

REVISED GAS LINE DATA		THG	08/01/08
NO.	REVISION	BY	DATE
205 BYPASS PHASE 4			
PLAN & PROFILE STA. 120+00 TO STA. 130+00			
1 OF 2			
TCB AECOM		TCB INC. WWW.TCB.AECOM.COM 17300 DALLAS PARKWAY, SUITE 1010 DALLAS, TEXAS 75248	
Unit	PW-DAL-FW	Scale	Horz: AS SHOWN Vert: AS SHOWN
Designed	THG	Checked	TCB
Drawn	FG	Approved	TCB
Date	11/11/2009	Project No.	60004153
Sheet	13	of	146

P:\4328\60004153-205Bypass\CADD\Sheets\Phase 4-120+00 to 141+00\Record Drawing 10-7-09\1013Pav.ngp-205BP01.dgn
 11/11/2009