



City of Rockwall, Texas

CONSTRUCTION PLANS

FOR

205 BYPASS

PHASE 6

FOR THE CONSTRUCTION OF MISCELLANEOUS WORK

CONSISTING OF : GRADING, DRAINAGE FACILITIES, CONCRETE PAVEMENT, ASPHALT CONCRETE PAVEMENT, SIGNING AND PAVEMENT MARKINGS.

DESIGN SPEEDS:

205-BYPASS	=	45 mph
F.M. 552	=	55 mph
S.H. 205	=	55 mph *

* SH 205 = 45 MPH AT CONNECTION W/ 205-BYPASS

MAYOR
Bill Cecil

MAYOR PRO-TEM
Stephen Straughan

CITY COUNCIL
Matt Scott
David Sweet
Glen Farris
Cliff Sevier
Margo Nielsen


CITY MANAGER
Julie Couch

CITY ENGINEER
Chuck Todd

END PHASE 6
STA. 289+00.00

2007

BEGIN PHASE 6
STA. 206+58.93

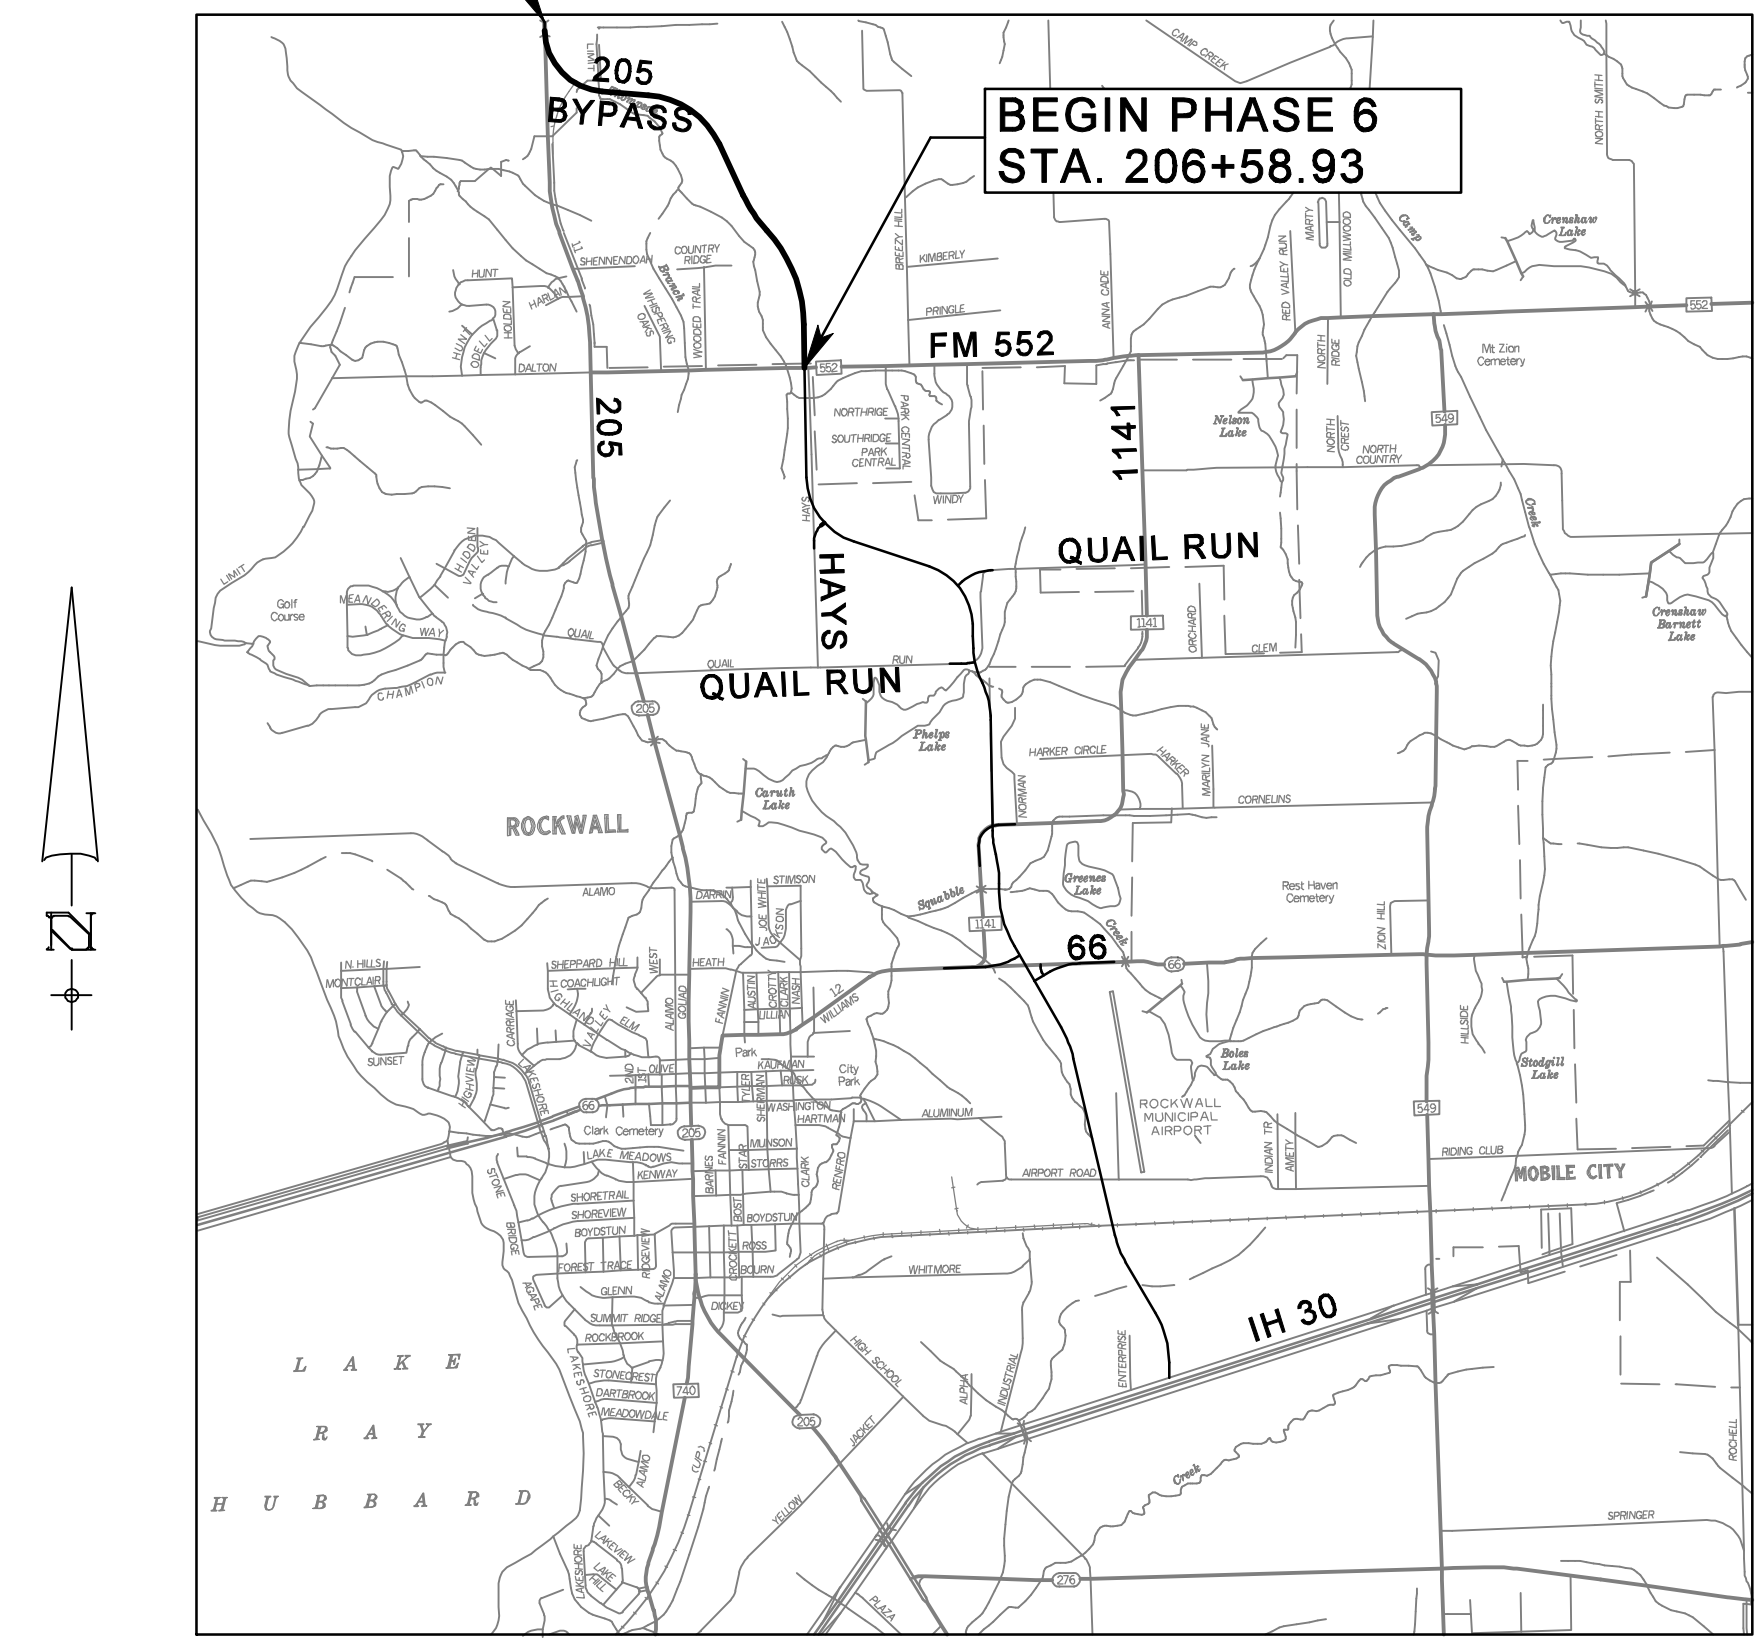

RECORD DRAWING
This drawing is a compilation of the original sealed engineering drawing and modifications by addenda, change orders and information furnished by the contractor. Information shown that was provided by the contractor and others not associated with the design engineer cannot be verified for accuracy or completeness. Original sealed drawing is on file at the office of AECOM USA Group, Inc., TBPE REG. NO. F-3082

ORIGINAL DRAWING
SEALED & SIGNED BY
Gregory G. Hooten, P.E.
TX NO. 83936

ORIGINAL DRAWING
SEALED & SIGNED BY
Matthew L. Abbe, P.E.
TX NO. 92715

NOTE:
SPECIFICATIONS ADOPTED BY THE TEXAS DEPARTMENT OF TRANSPORTATION, JUNE 1, 2004 AND THE CONTRACT PROVISIONS LISTED AND DATED AS FOLLOWS SHALL GOVERN ON THIS PROJECT: REQUIRED CONTRACT PROVISIONS FOR ALL FEDERAL-AID CONSTRUCTION CONTRACTS, (FORM FHWA 1273, DECEMBER 1993.)



TCB INC.
17300 DALLAS PARKWAY, SUITE 1010
DALLAS, TEXAS 75248
WWW.TCB.AECOM.COM

VICINITY MAP
SCALE: N.T.S.