
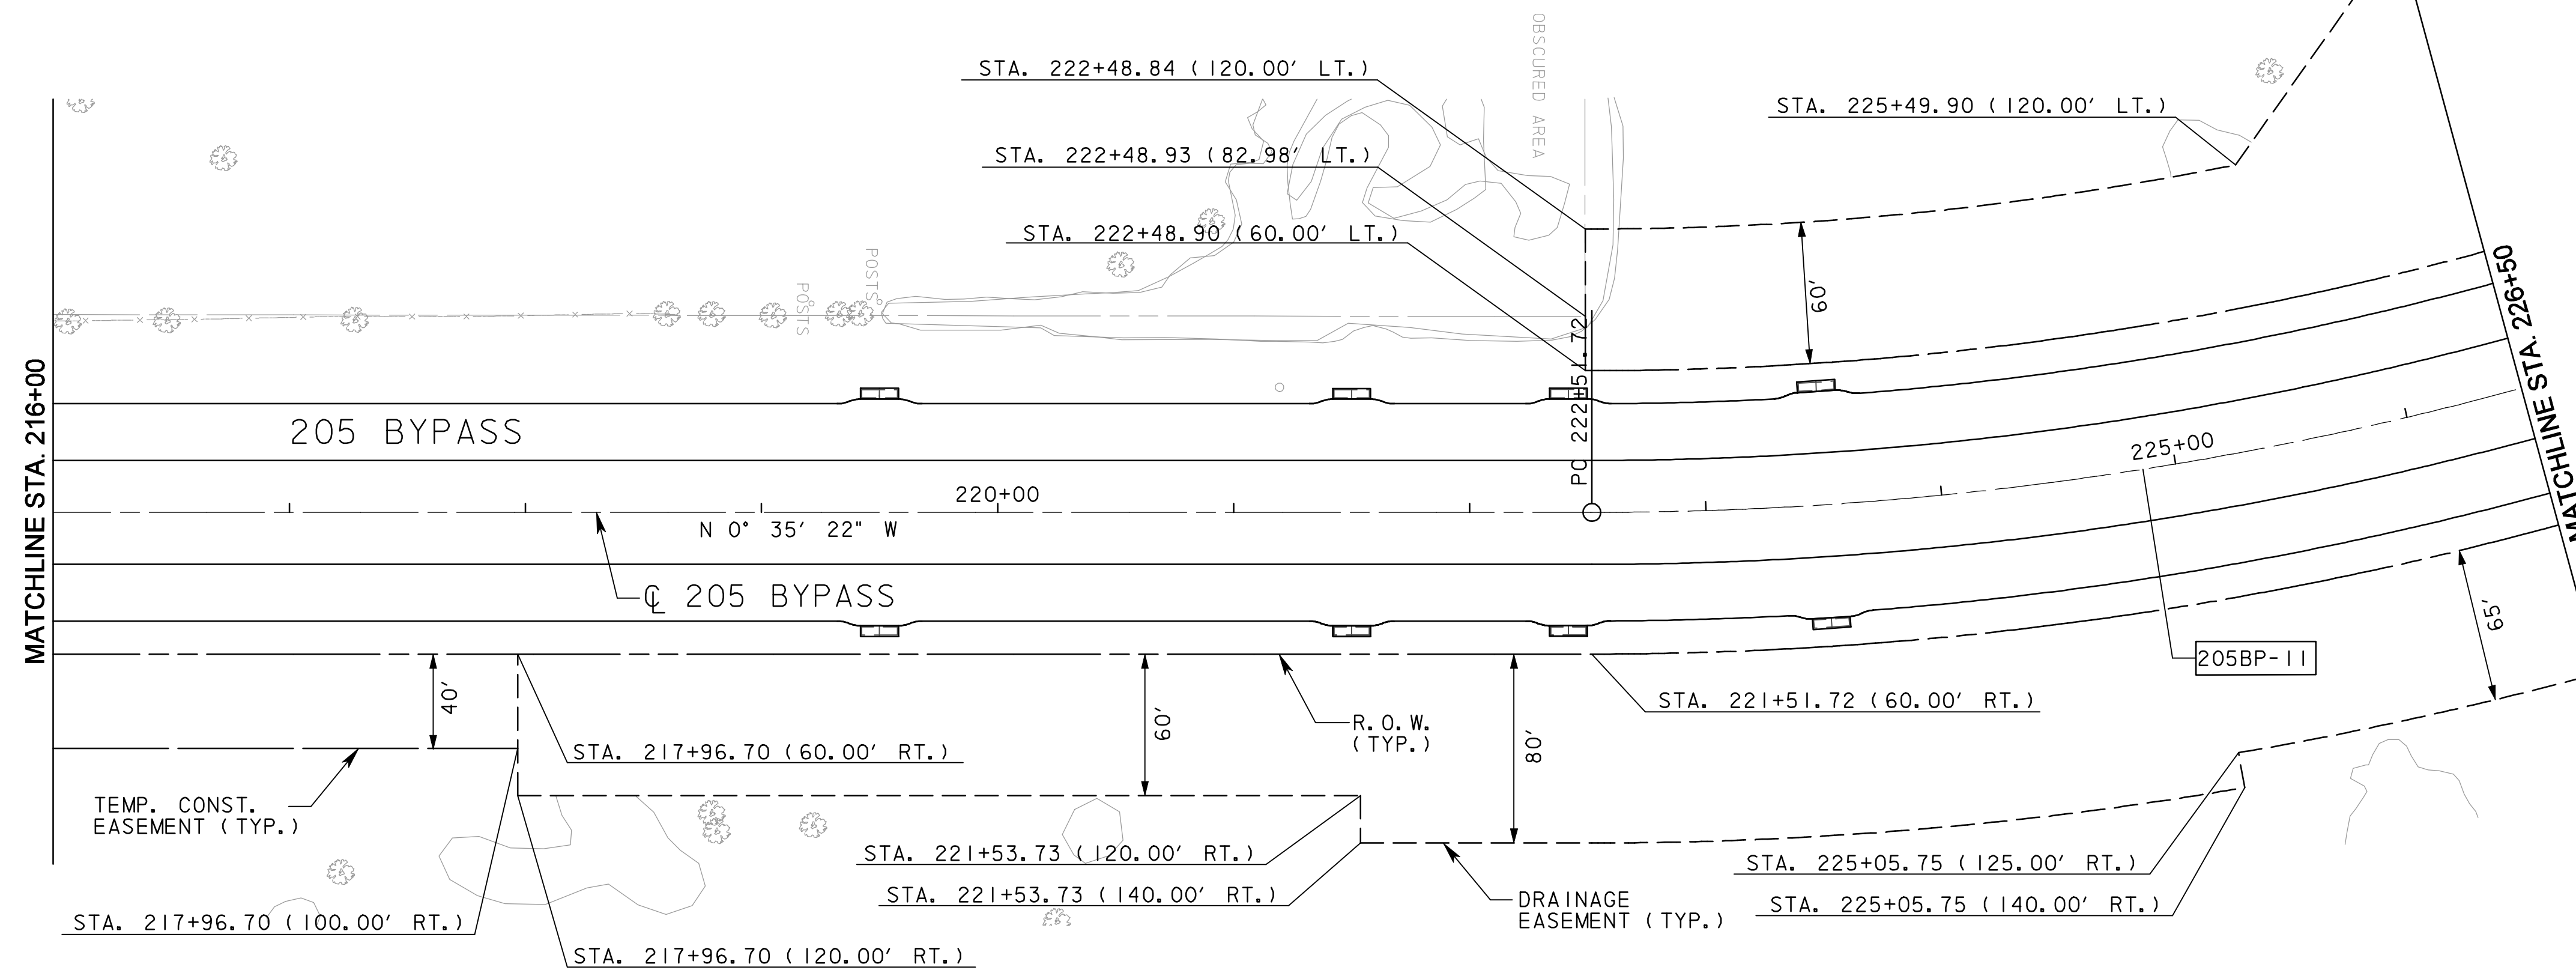


LEGEND

	ROW
	CONSTRUCTION EASEMENT
	DRAINAGE EASEMENT
	CONTROL LINE
	CURVE NUMBER
	RECESSED CURB INLET

NOTE:

- ALL STATION/OFFSET SHOWN ARE BASED OFF THE 205 BYPASS CONTROL LINE, UNLESS OTHERWISE SHOWN.
- EASEMENTS HAVE BEEN CALLED OUT ON THE PLANS FOR CONTRACTORS INFORMATION. IF THERE IS A VARIATION BETWEEN THESE PLANS AND SURVEYED PARCEL, CONTRACTOR SHALL USE SURVEYED PARCELS/DESCRIPTIONS.

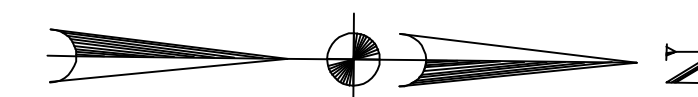

**RECORD DRAWING**

This drawing is a compilation of the original sealed engineering drawing and modifications by addenda, change orders and information furnished by the contractor. Information shown that was provided by the contractor and others not associated with the design engineer cannot be verified for accuracy or completeness. Original sealed drawing is on file at the office of AECOM USA Group, Inc., TBPE REG. NO. F-3082

ORIGINAL DRAWING  
SEALED & SIGNED BY  
Matthew L. Abbe, P.E.  
TX NO. 92715

NO.	REVISION	BY	DATE
<b>City of Rockwall, Texas</b> <b>205 BYPASS PHASE 6</b> <b>HORIZONTAL CONTROL LAYOUT</b>			
1 OF 5			
		<small>TCB INC. WWW.TCB.AECOM.COM 17300 DALLAS PARKWAY, SUITE 1010 DALLAS, TEXAS 75248</small>	
Unit	PW-DAL-FW	Scale	Horz: AS SHOWN Vert: AS SHOWN
Designed	SKW/MLA	Checked	TCB
Drawn	TCB	Approved	TCB
Date	11/24/2009	Project No.	60004153
Sheet	33	of	216

P:\4328\60004153-205bypass\cadd\sheet\phase 6 - fm552 to 205\record drawing 10..7..09\033for tzl\yout-01.dgn  
 11/24/2009