


**LEGEND**  
 205BP-1 CURVE NUMBER

**RECORD DRAWING**  
 This drawing is a compilation of the original sealed engineering drawing and modifications by addenda, change orders and information furnished by the contractor. Information shown that was provided by the contractor and others not associated with the design engineer cannot be verified for accuracy or completeness. Original sealed drawing is on file at the office of AECOM USA Group, Inc., TBPE REG. NO. F-3082

ORIGINAL DRAWING SEALED & SIGNED BY  
 Matthew L. Abbe, P.E.  
 TX NO. 92715

NO.	REVISION	BY	DATE
<b>City of Rockwall, Texas</b> <b>205 BYPASS PHASE 6</b> <b>HORIZONTAL CONTROL LAYOUT</b>			
3 OF 5			
		<small>TCB INC.          WWW.TCB.AECOM.COM          17300 DALLAS PARKWAY, SUITE 1010          DALLAS, TEXAS 75248</small>	
Unit	PW-DAL-FW	Scale	Horz: AS SHOWN Vert: AS SHOWN
Designed	SKW/MLA	Checked	TCB
Drawn	TCB	Approved	TCB
Date	11/24/2009	Project No.	60004153
Sheet	35	of	216

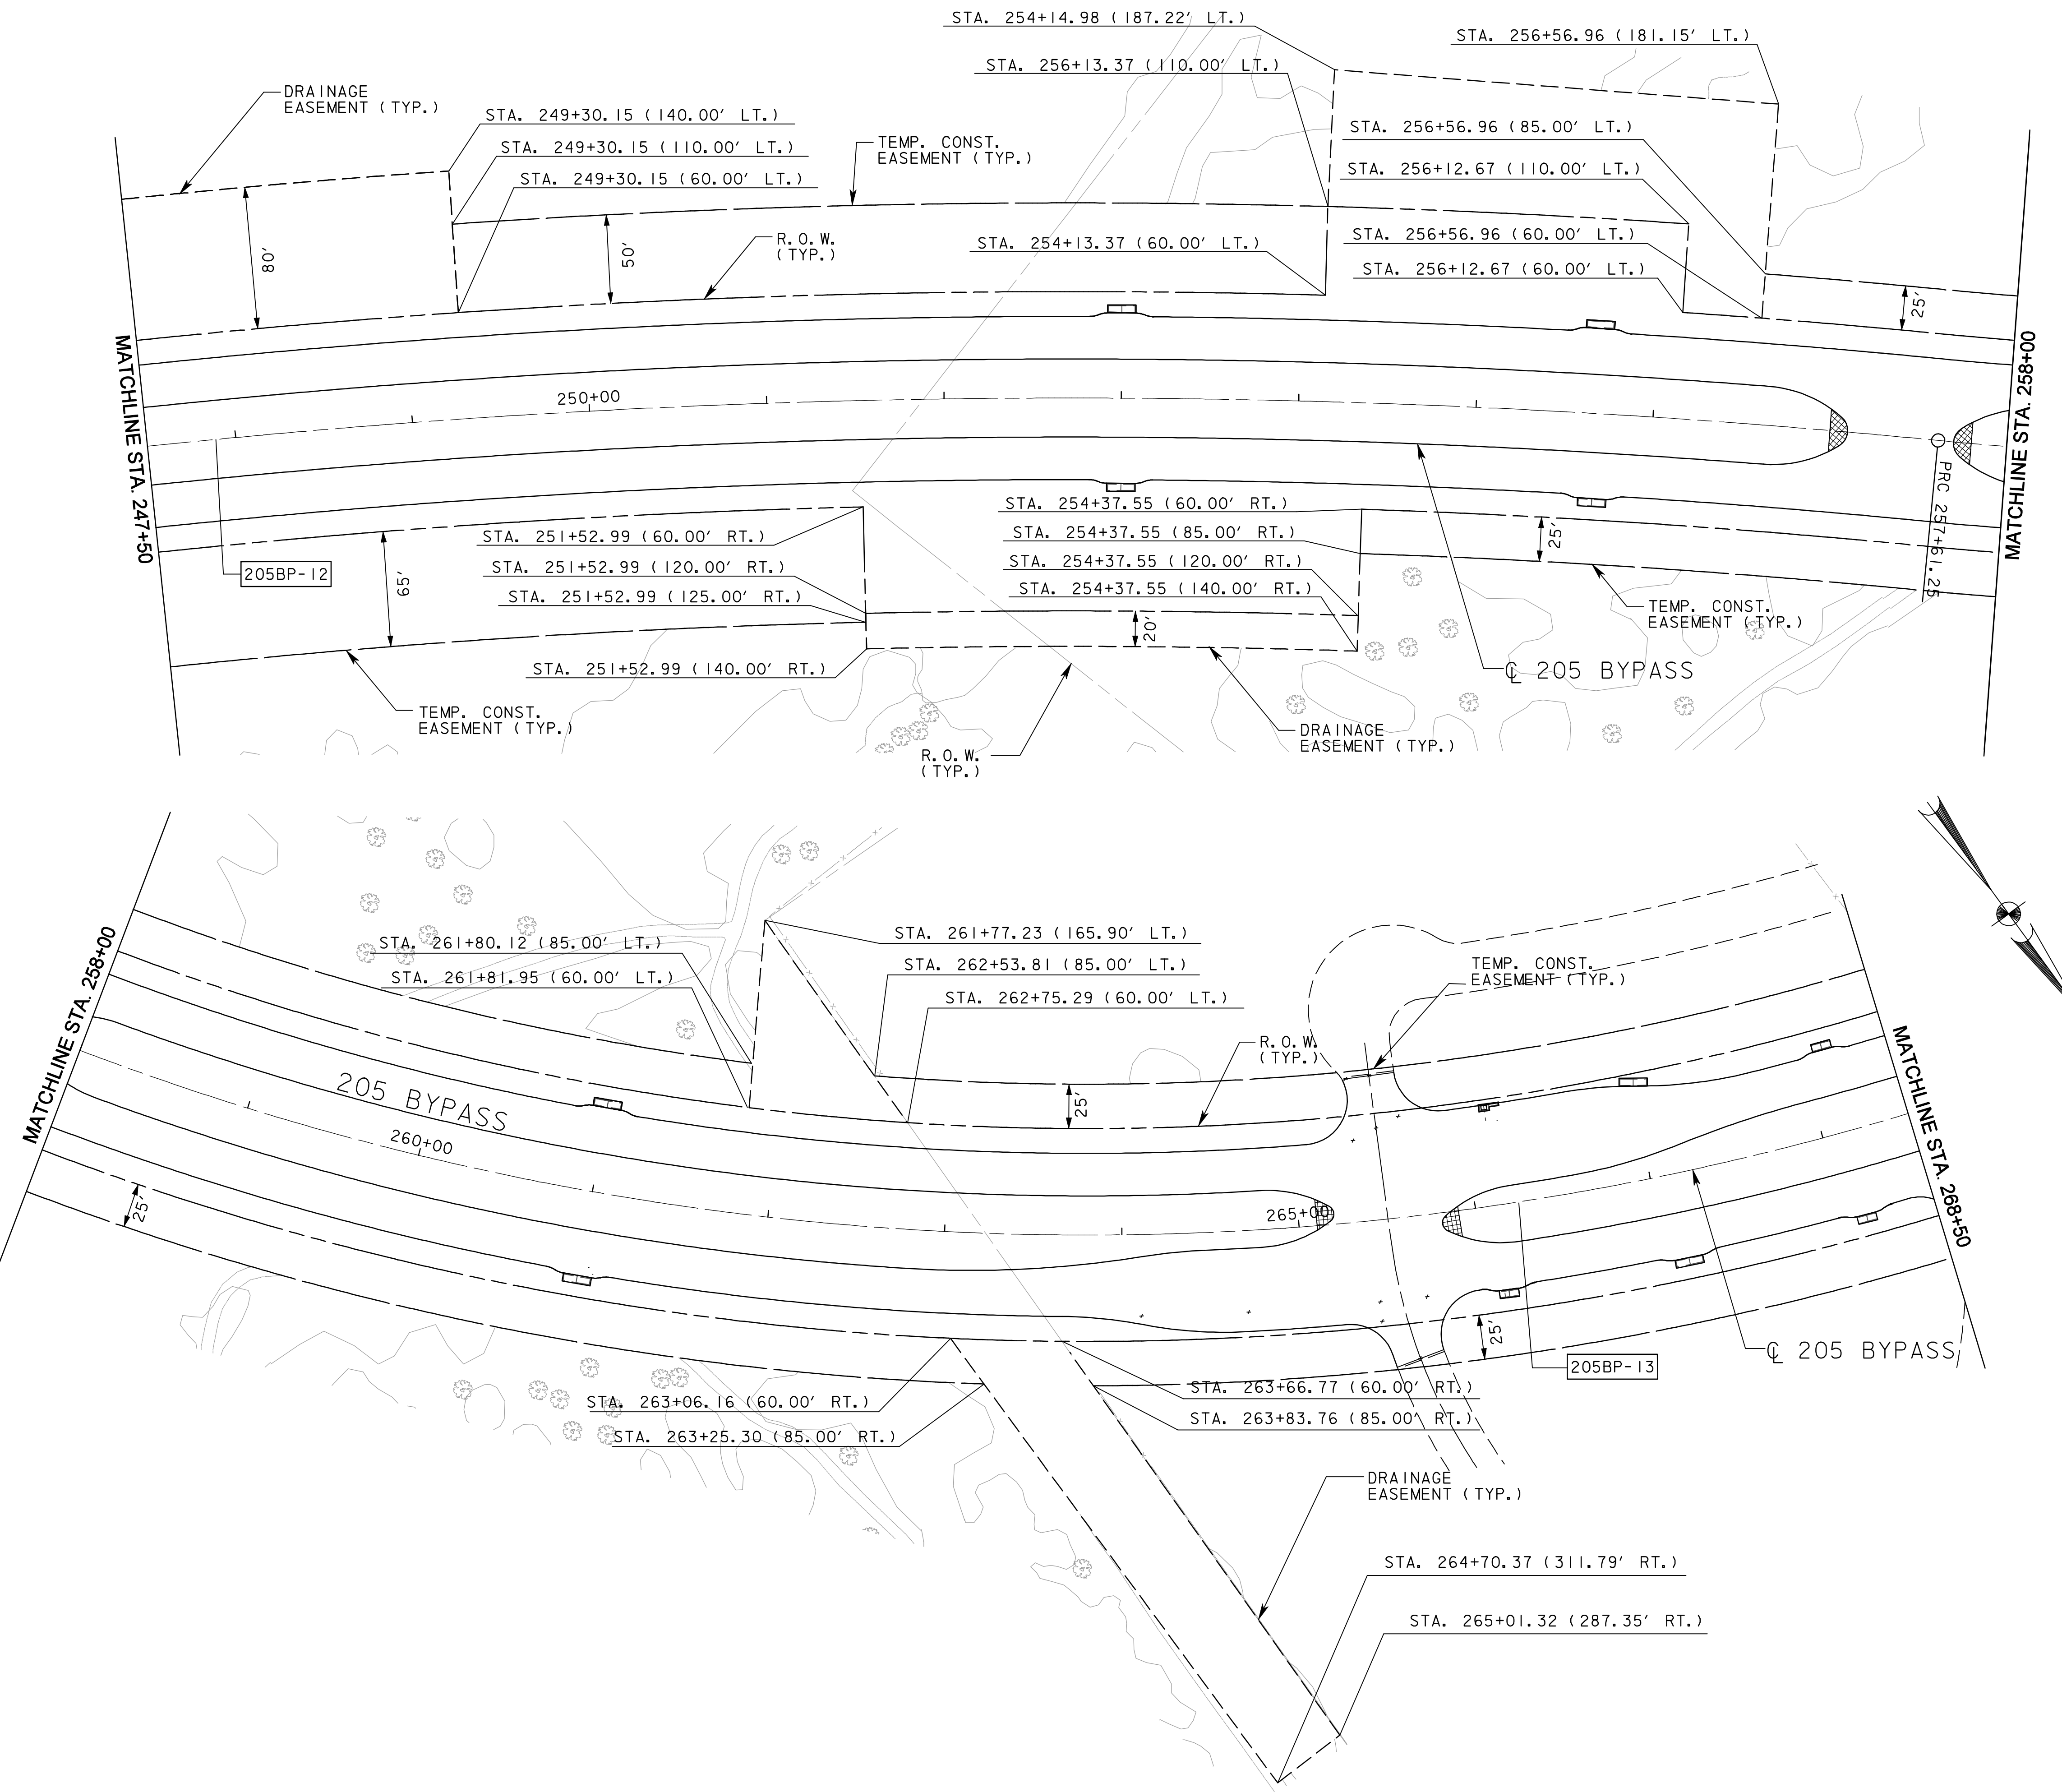

P:\4328\60004153-205bypass\cadd\sheet\phase 6 - final\record drawing 10..7..09\035for1z\eyouf-03.dgn  
 11/24/2009