

50 0 50 100




SCALE IN FEET
HORIZONTAL

5 0 5 10




SCALE IN FEET
VERTICAL

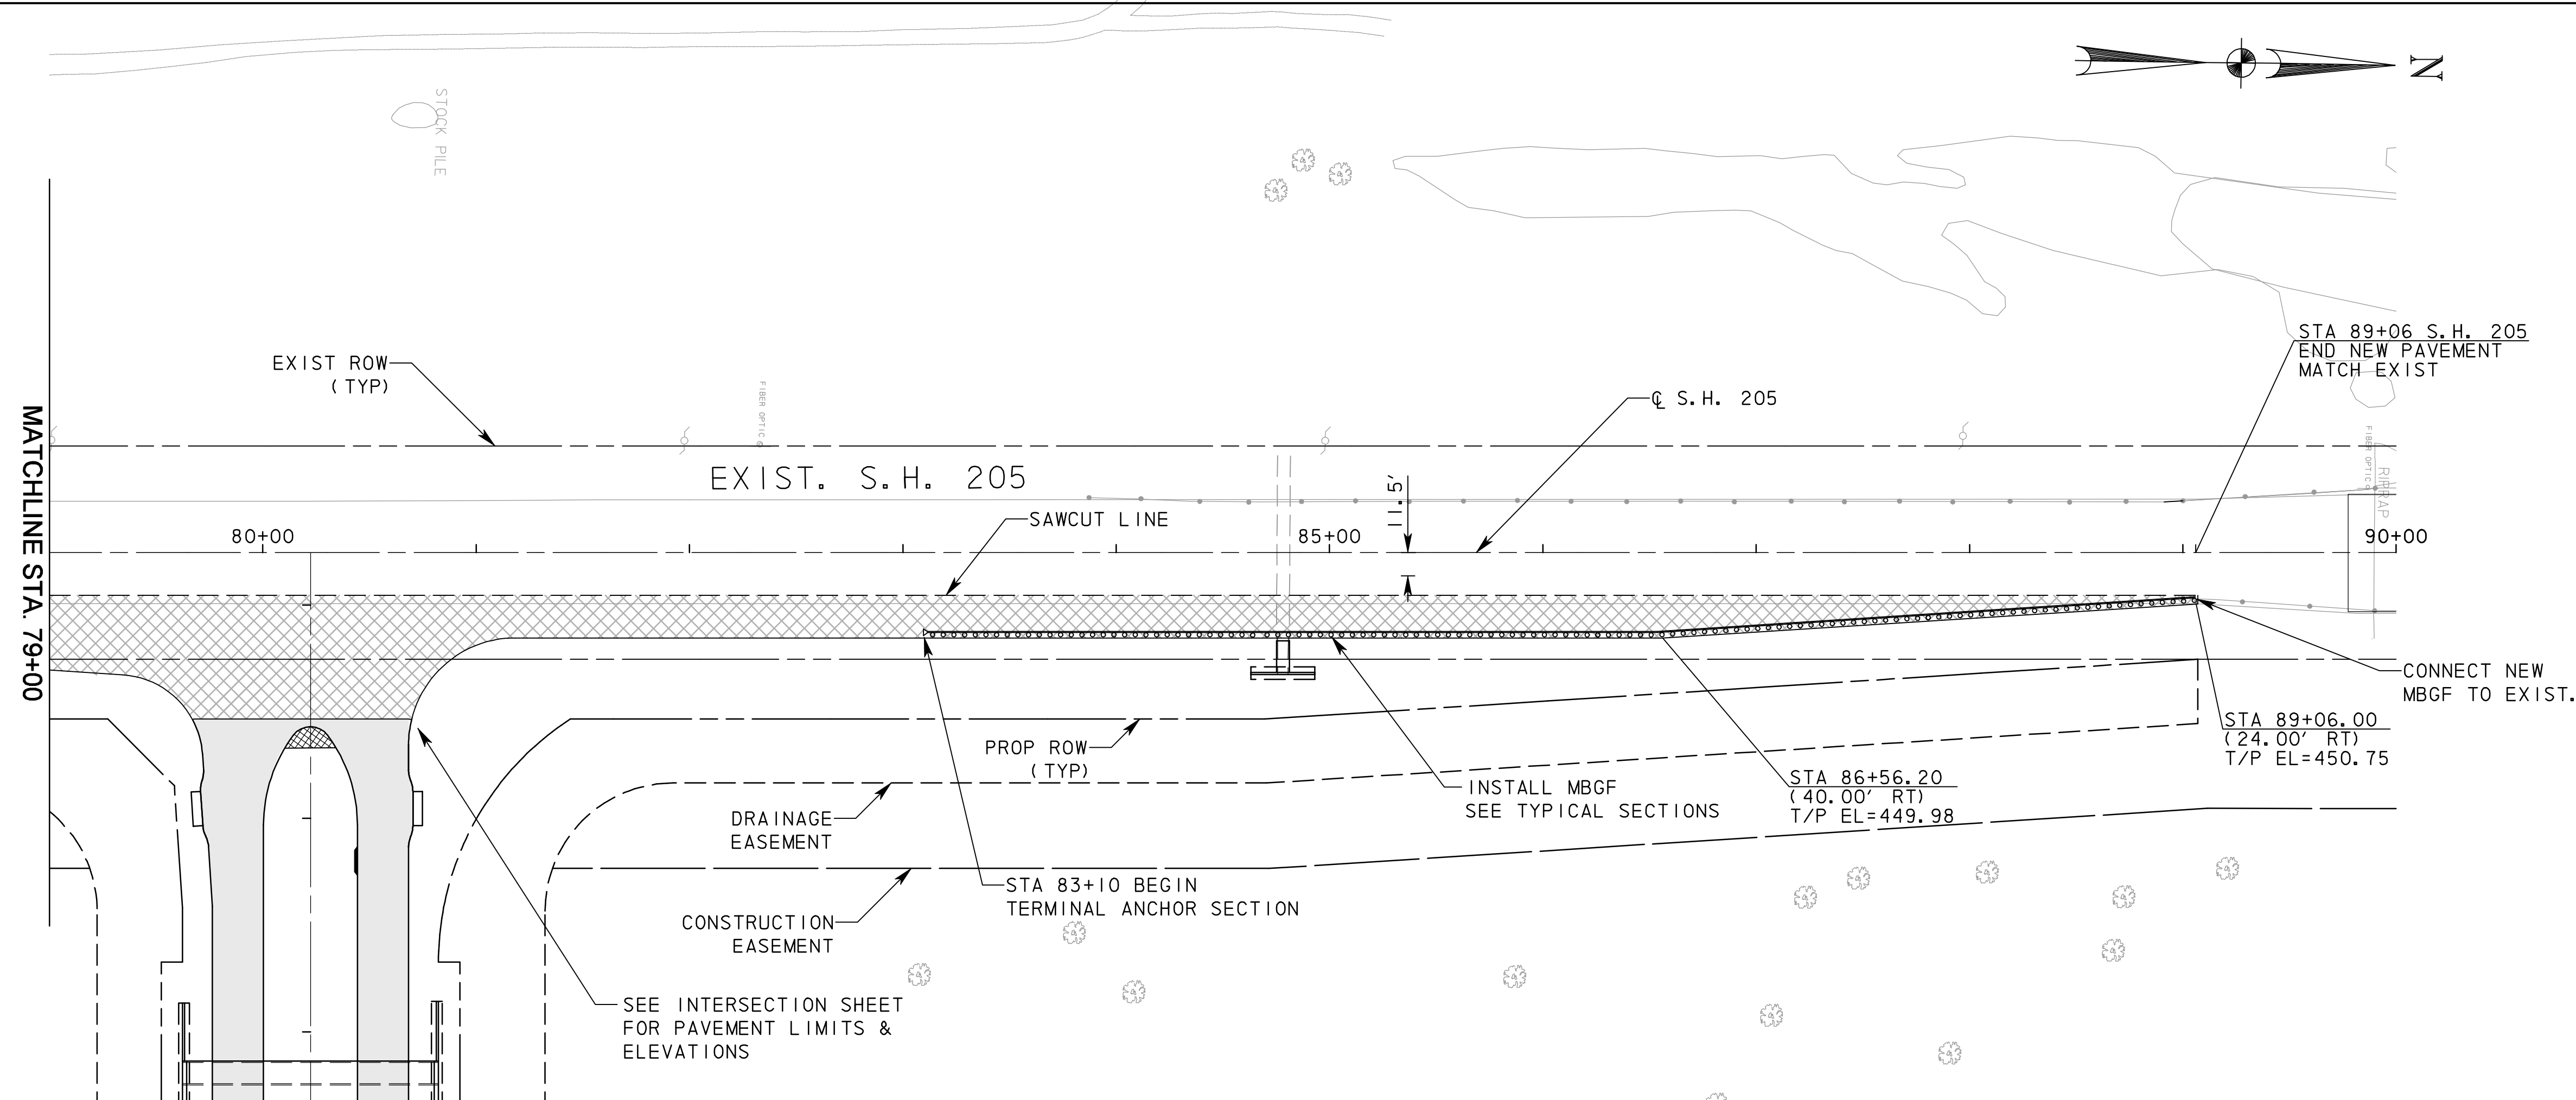

LEGEND

	CONCRETE PAVEMENT
	HMAC PAVEMENT
	RECESSED CURB INLET
	DROP INLET TYPE H

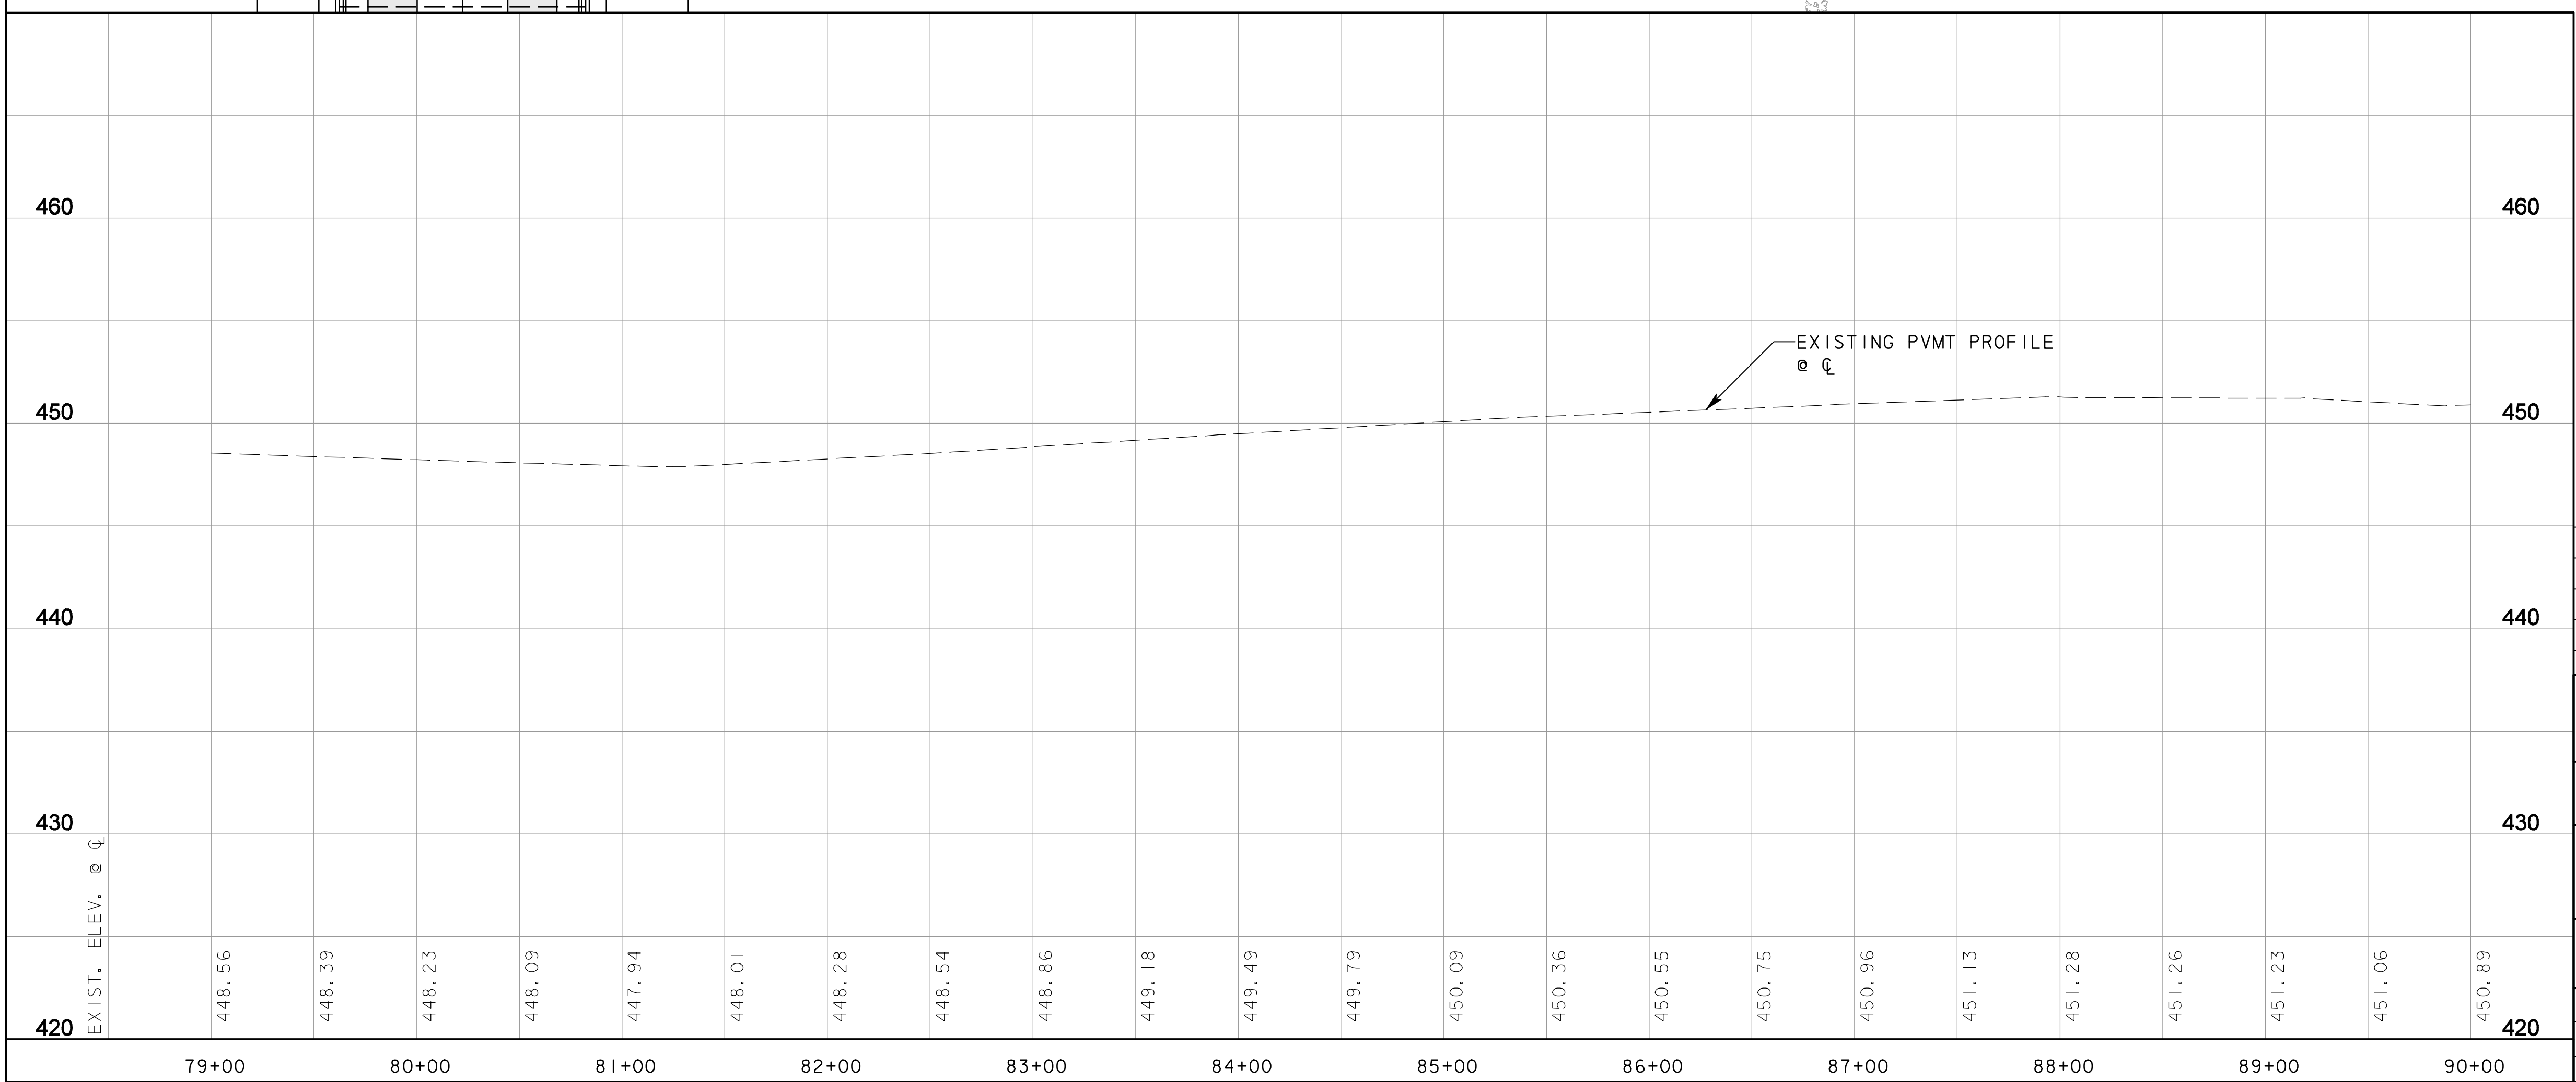

RECORD DRAWING
This drawing is a compilation of the original sealed engineering drawing and modifications by addenda, change orders and information furnished by the contractor. Information shown that was provided by the contractor and others not associated with the design engineer cannot be verified for accuracy or completeness. Original sealed drawing is on file at the office of AECOM USA Group, Inc., TBPE REG. NO. F-3082

ORIGINAL DRAWING
SEALED & SIGNED BY
T.H. Gaertner, P.E.
TX NO. 37124

NO.	REVISION	BY	DATE
2	REVISED S.H. 205 INTERSECTION	THG	7/14/08
1	REVISED S.H. 205 INTERSECTION	THG	7/02/08

City of Rockwall, Texas
**205 BYPASS
PHASE 6**
**PLAN & PROFILE
STA. 72+00.00 TO STA. 79+00.00** 11 OF 11

TCB AECOM		TCB INC. WWW.TCB.AECOM.COM 17300 DALLAS PARKWAY, SUITE 1010 DALLAS, TEXAS 75248	
Unit	PW-DAL-FW	Scales	Horz: AS SHOWN Vert: AS SHOWN
Designed	THG	Checked	TCB
Drawn	FG	Approved	TCB
Date	11/24/2009	Project No.	60004153
Sheet	48A	of	216

P:\328\60004153-205bypass\cadd\sheet6\phase 6 - fms2 to 205\record drawing 10_7_09\048APF-205BP-11.dgn
 11/24/2009