

**LEGEND**

- INLET DESIGNATION  
AREA (AC)
- INLET DRAINAGE BOUNDARY
- SURFACE FLOW DIRECTION
- DITCH

**NOTES:**

1. SEE HYDRAULIC DATA SHEETS FOR GUTTER FLOW CALCULATIONS.
2. FLOW FROM RSJ2 FLOWS INTO ROADSIDE DITCH AND FLOWS SOUTH TO CULVERT.
3. FLOW FROM RSK2 FLOWS INTO ROADSIDE DITCH AND FLOWS NORTH TO CULVERT.

**RECORD DRAWING**  
 This drawing is a compilation of the original sealed engineering drawing and modifications by addenda, change orders and information furnished by the contractor. Information shown that was provided by the contractor and others not associated with the design engineer cannot be verified for accuracy or completeness. Original sealed drawing is on file at the office of AECOM USA Group, Inc., TBPE REG. NO. F-3082

ORIGINAL DRAWING  
 SEALED & SIGNED BY  
 Matthew L. Abbe, P.E.  
 TX NO. 92715

NO.	REVISION	BY	DATE

**City of Rockwall, Texas**


**205 BYPASS  
 PHASE 6**

**DRAINAGE SYSTEM MAP  
 STA. 225+00 TO STA. 235+00**

3 OF 9

**TCB | AECOM**  
 TCB INC.  
 WWW.TCB.AECOM.COM  
 17300 DALLAS PARKWAY, SUITE 1010  
 DALLAS, TEXAS 75248

Unit	PW-DAL-FW	Scale	Horz: AS SHOWN Vert: AS SHOWN	Date	11/24/2009
Designed	RI/SB/AR	Checked	TCB	Project No.	60004153
Drawn	FG	Approved	TCB	Sheet	61 of 216

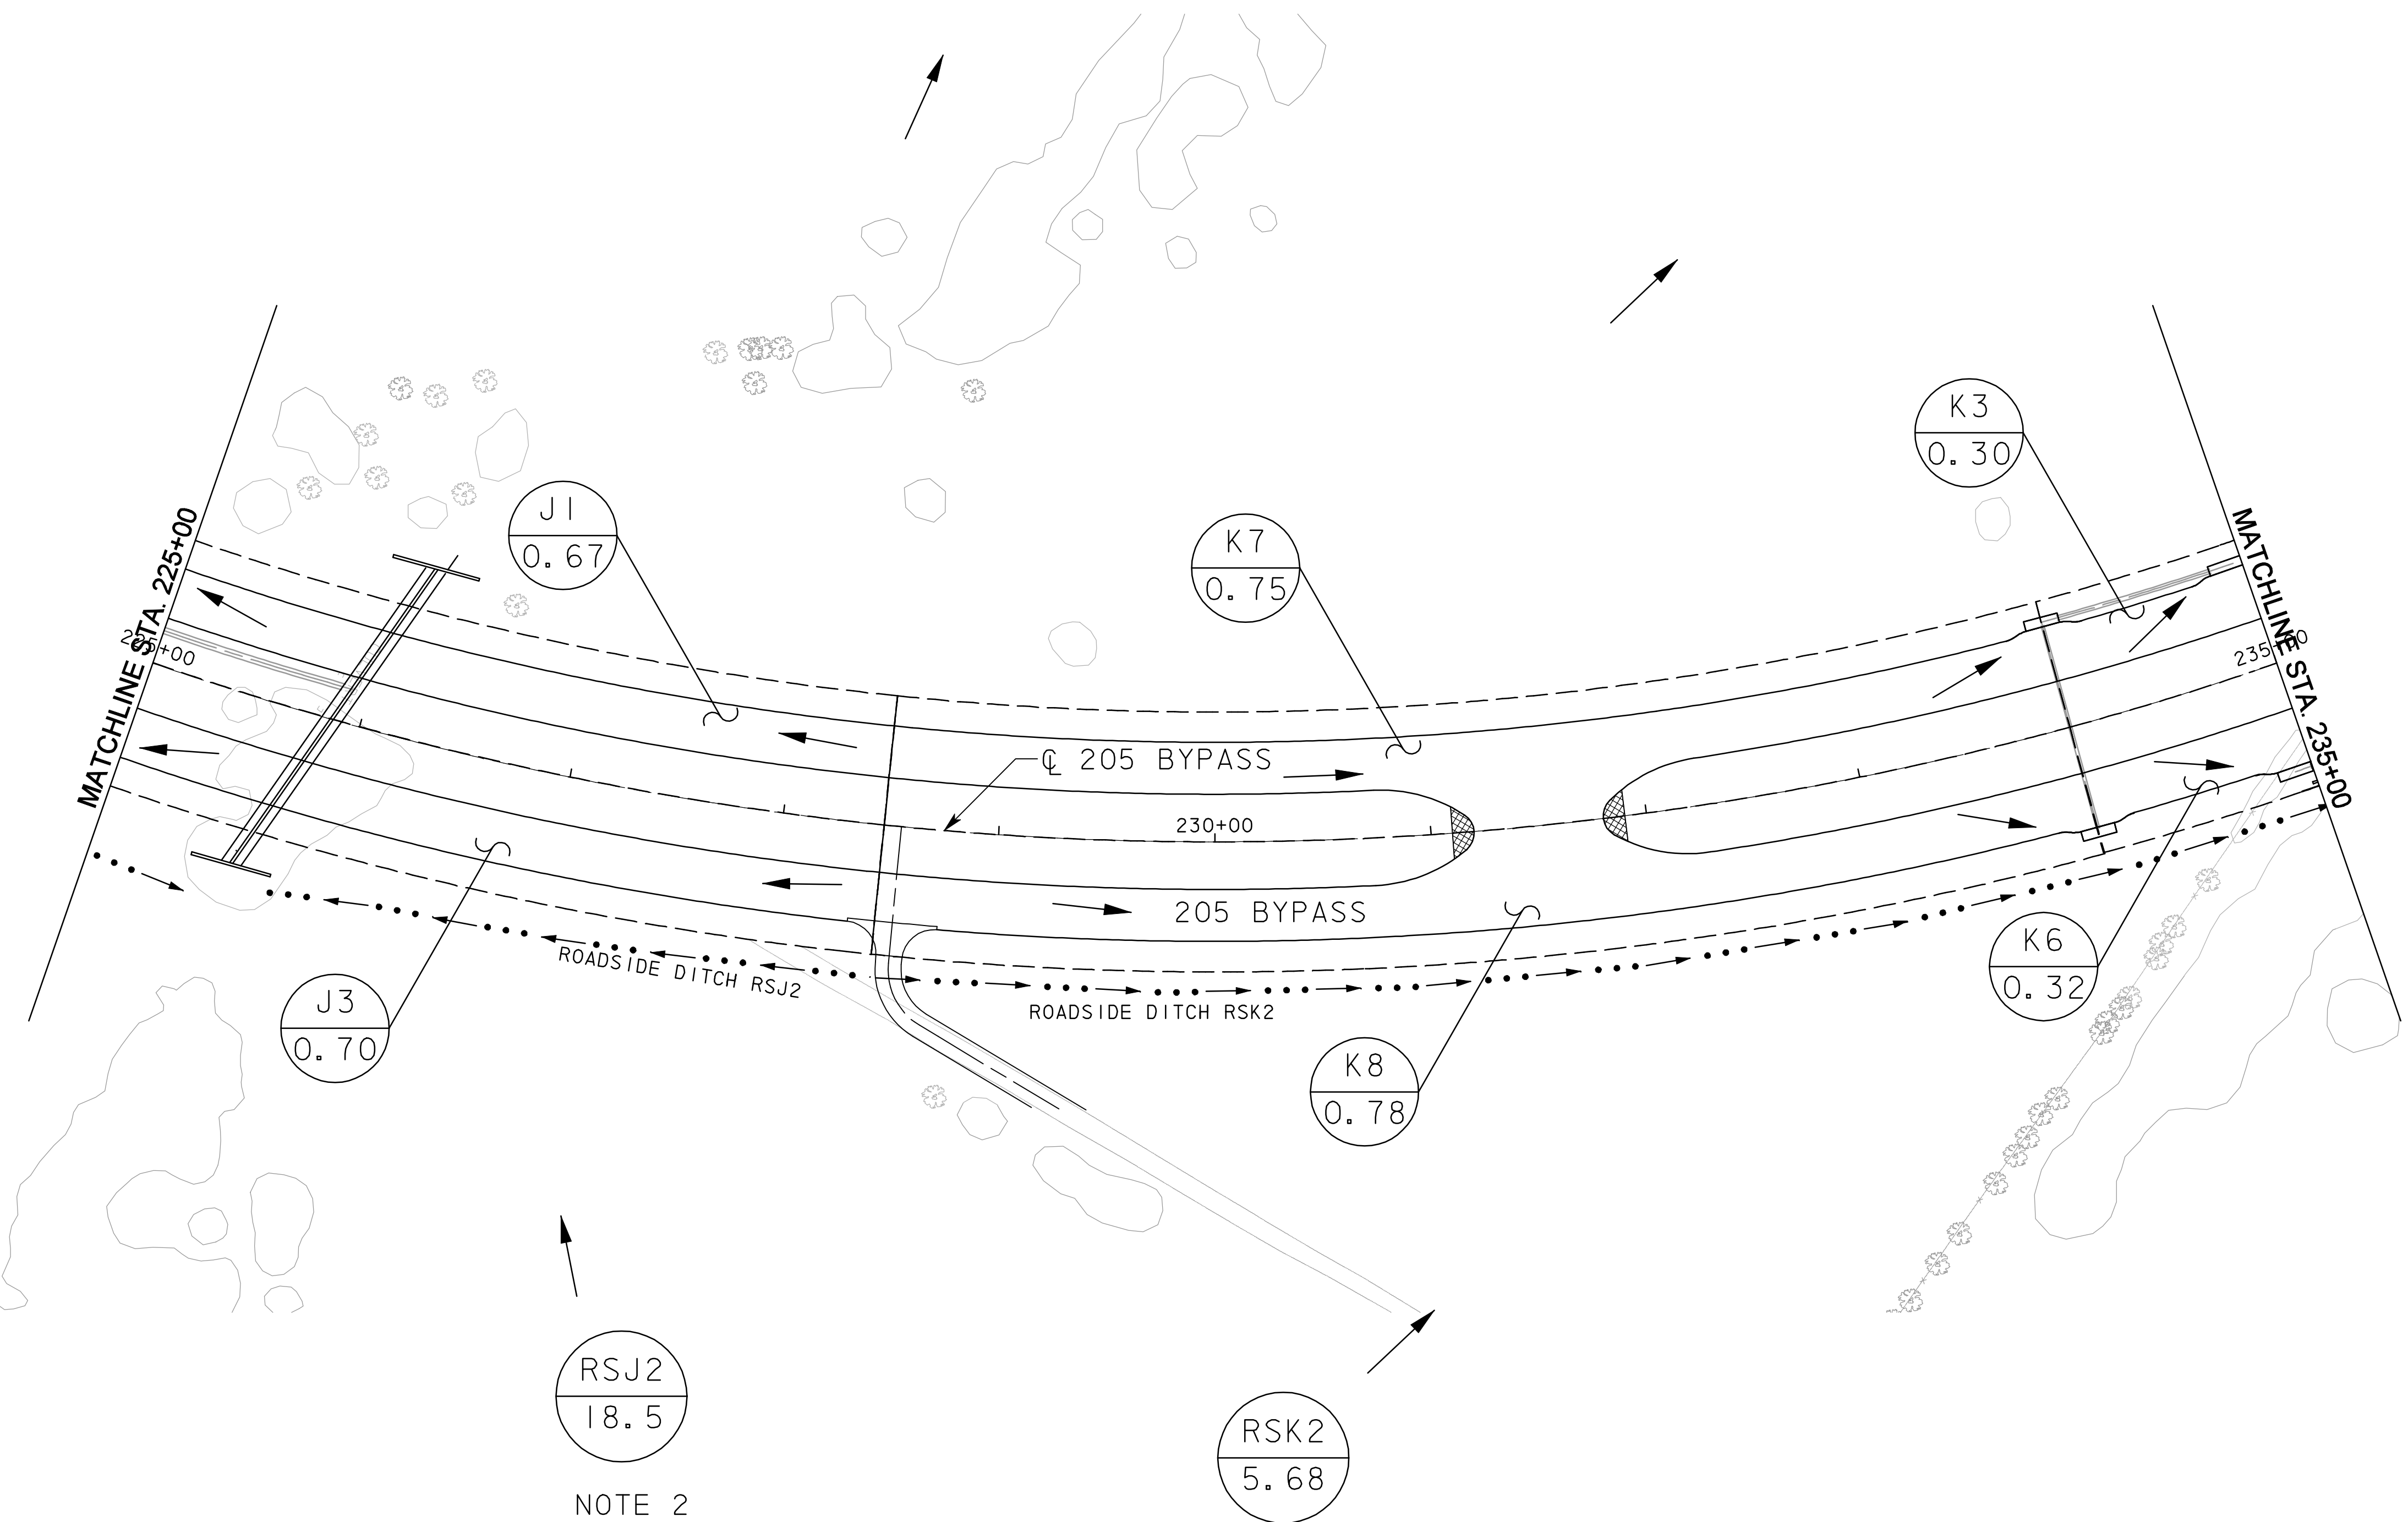

**NOTE 2**

**NOTE 3**

P:\4328\60004153-205bypass\cadd\sheet\phase 6 - final\record drawing 10.7.09\06\dra\in\_syst-205BPF03.dgn  
 11/24/2009