


LEGEND

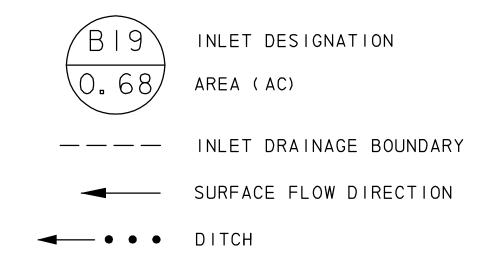

NOTES:


- I. SEE HYDRAULIC DATA SHEETS FOR GUTTER FLOW CALCULATIONS.
- 2. FLOW FROM RSKI FLOWS INTO ROADSIDE DITCH AND FLOWS TO CULVERT.

RECORD DRAWING

This drawing is a compilation of the original sealed engineering drawing and modifications by addenda, change orders and information furnished by the contractor. Information shown that was provided by the contractor and others not associated with the design engineer cannot be verified for accuracy or completeness. Original sealed drawing is on file at the office of AECOM USA Group, Inc., TBPE REG. NO. F-3082

ORIGINAL DRAWING SEALED & SIGNED BY Matthew L. Abbe, P.E. TX NO. 92715

NO.	REVISION	BY	DATE

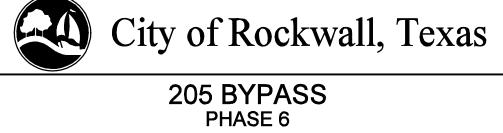

DRAINAGE SYSTEM MAP STA. 235+00 TO STA. 245+00

	4 OF 9			
TCB INC. WWW.TCB.AECOM.COM 17300 DALLAS PARKWAY, SUITE 1010 DALLAS, TEXAS 75248				
Jnit PW-DAL-FW	Horz: AS SHOWN Scale: Vert: AS SHOWN Date 11/24/2009			
Designed RI/SB/AF	Checked TCB Project No. 60004153			
rawn F.G	Approved TCB Sheet 62 of 216			