


LEGEND

- INLET DESIGNATION
AREA (AC)
- INLET DRAINAGE BOUNDARY
- SURFACE FLOW DIRECTION

NOTES:
1. SEE HYDRAULIC DATA SHEETS FOR GUTTER FLOW CALCULATIONS.

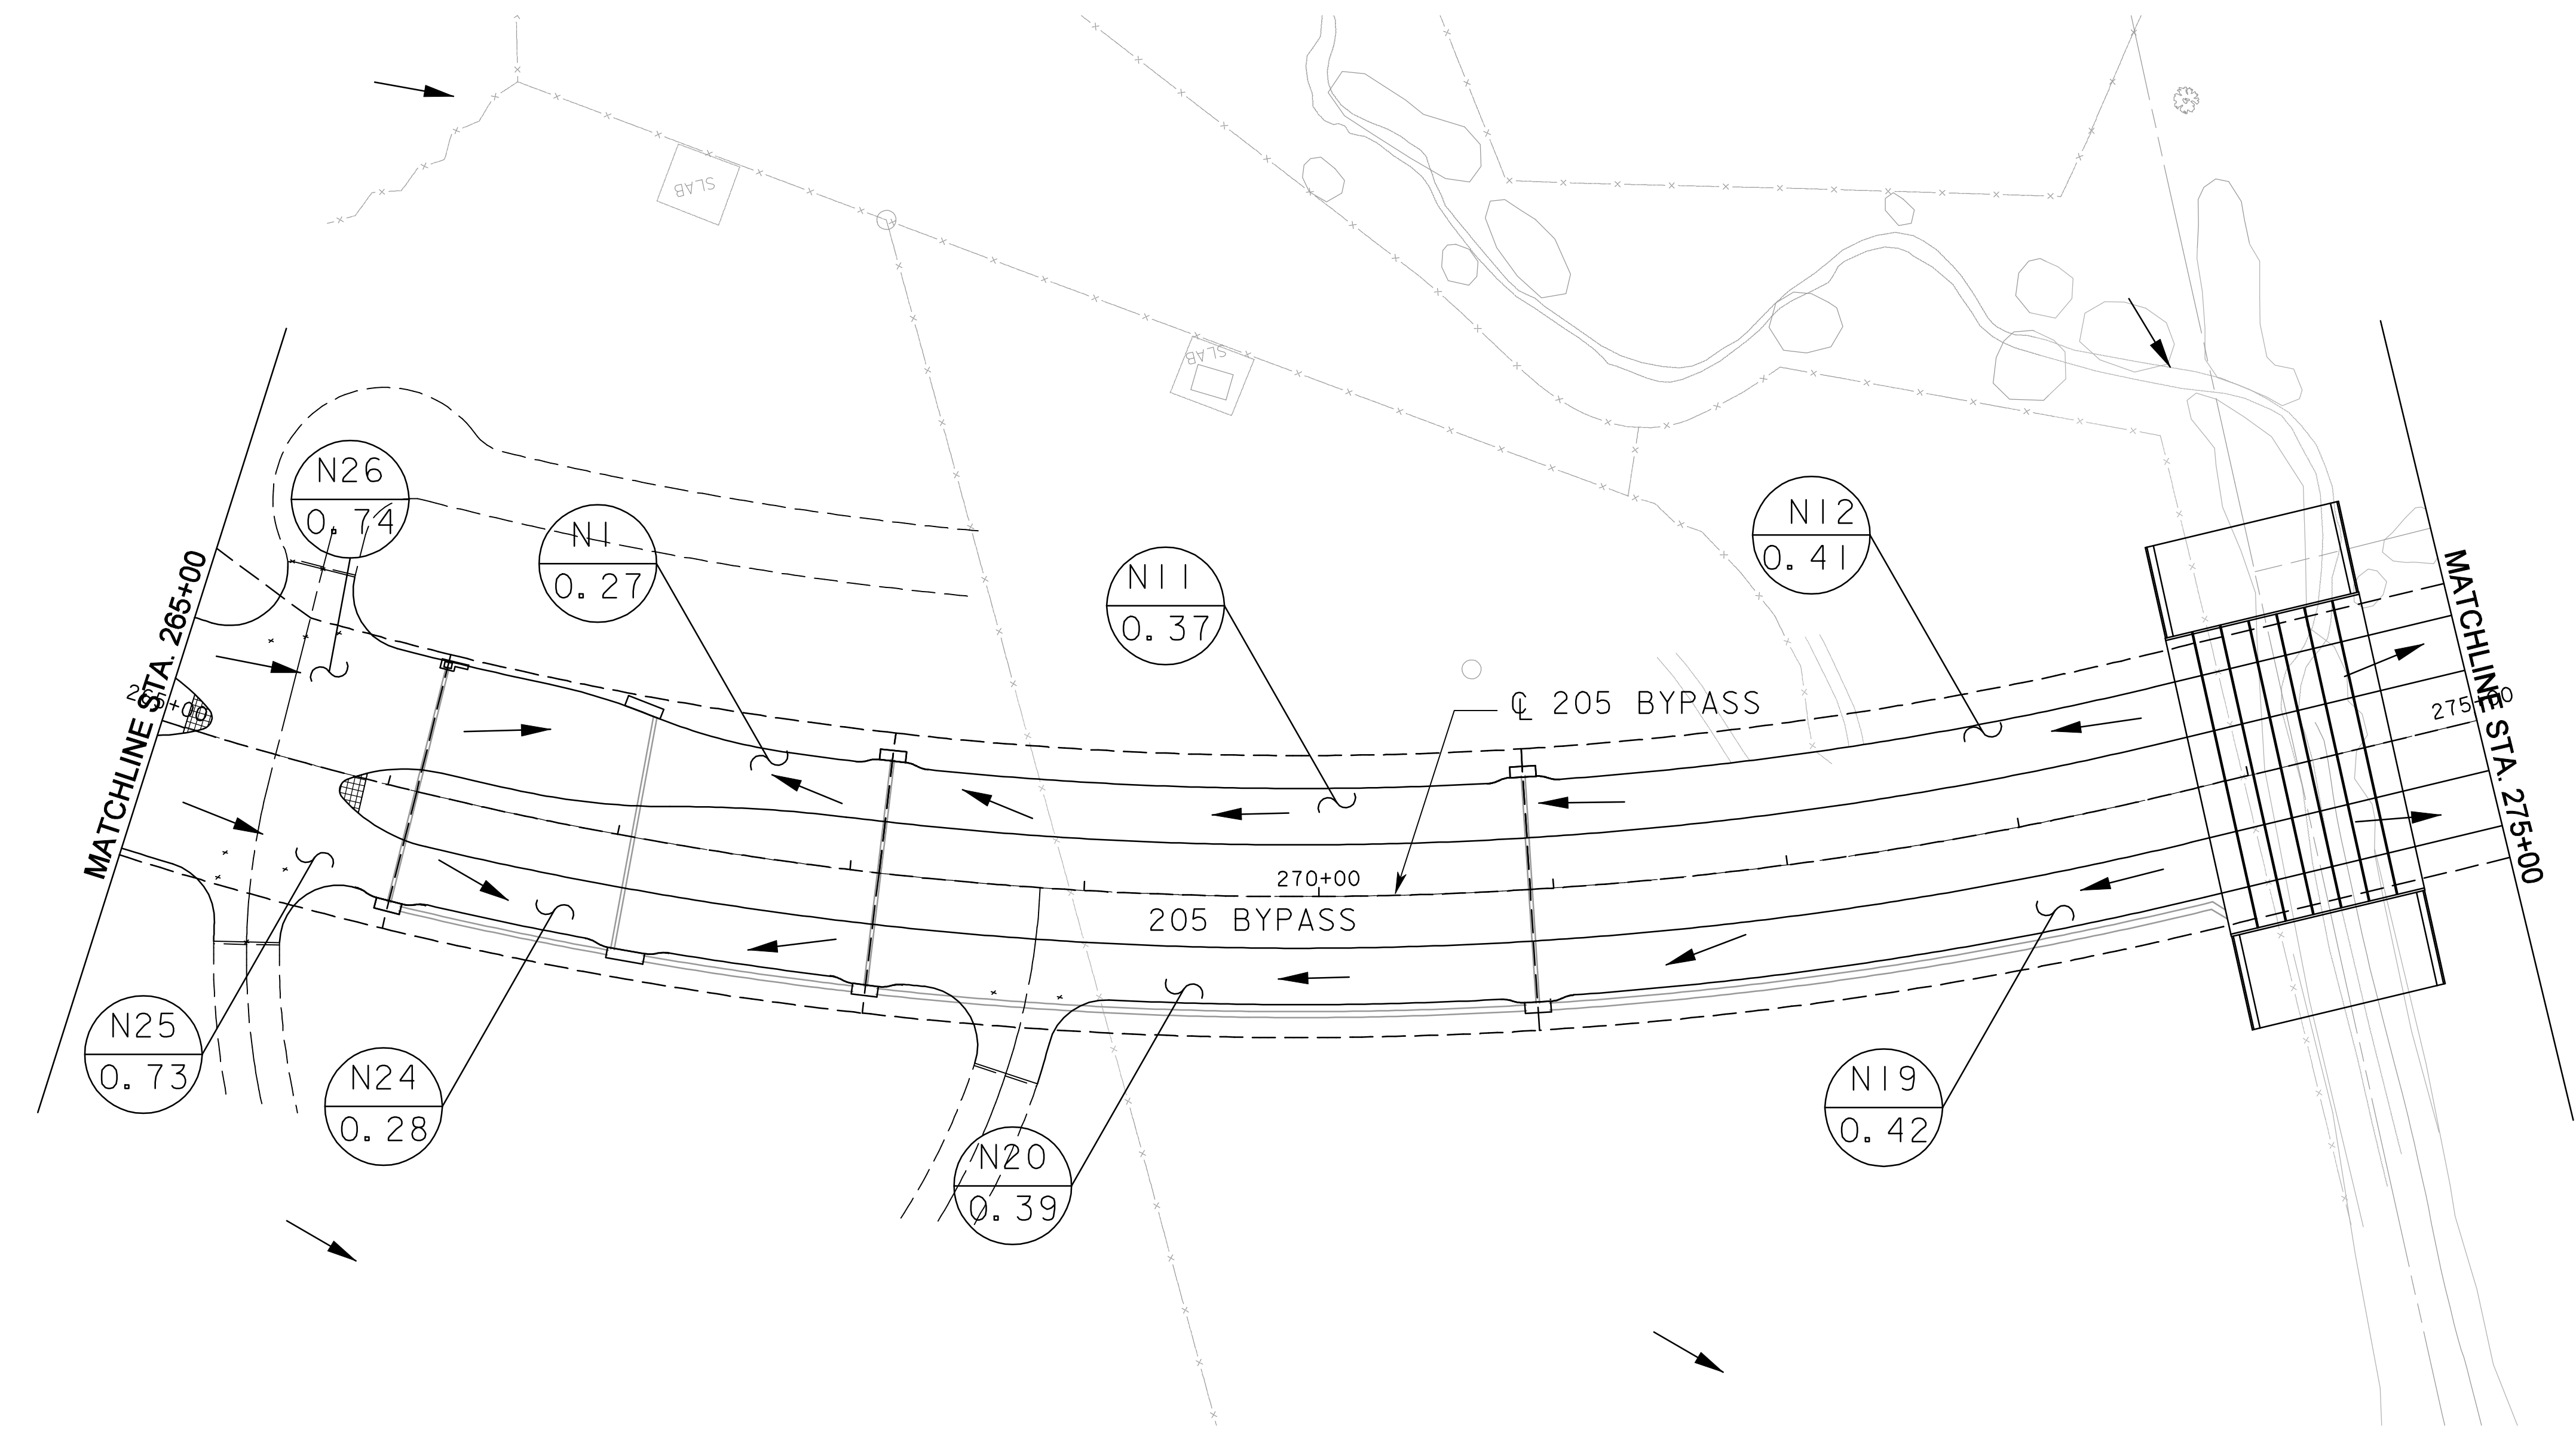

RECORD DRAWING
This drawing is a compilation of the original sealed engineering drawing and modifications by addenda, change orders and information furnished by the contractor. Information shown that was provided by the contractor and others not associated with the design engineer cannot be verified for accuracy or completeness. Original sealed drawing is on file at the office of AECOM USA Group, Inc., TBPE REG. NO. F-3082

ORIGINAL DRAWING SEALED & SIGNED BY
Matthew L. Abbe, P.E.
TX NO. 92715

NO.	REVISION	BY	DATE

City of Rockwall, Texas

**205 BYPASS
PHASE 6**

**DRAINAGE SYSTEM MAP
STA. 265+00 TO STA. 275+00**

7 OF 9

TCB AECOM
TCB INC.
WWW.TCB.AECOM.COM
17300 DALLAS PARKWAY, SUITE 1010
DALLAS, TEXAS 75248

Unit	PW-DAL-FW	Scale	Horz: AS SHOWN Vert: AS SHOWN	Date	11/24/2009
Designed	RI/SB/AR	Checked	TCB	Project No.	60004153
Drawn	FG	Approved	TCB	Sheet	65 of 216

P:\4328\60004153-205bypass\cadd\sheet\phase 6 - final\record drawing 10.7.09\065Dra\in_syst-205BPF07.dgn
 11/24/2009