



NOTE
 1. **BLOCK SOD** ALL GRADED SLOPES STEEPER THAN 4:1 AND ALL AREAS IN BOTTOM OF STREAM CHANNEL. INSTALL CELLULOSE FIBER MULCH SEEDING IN ALL OTHER DISTURBED AREAS PER TXDOT SPEC ITEM 164.

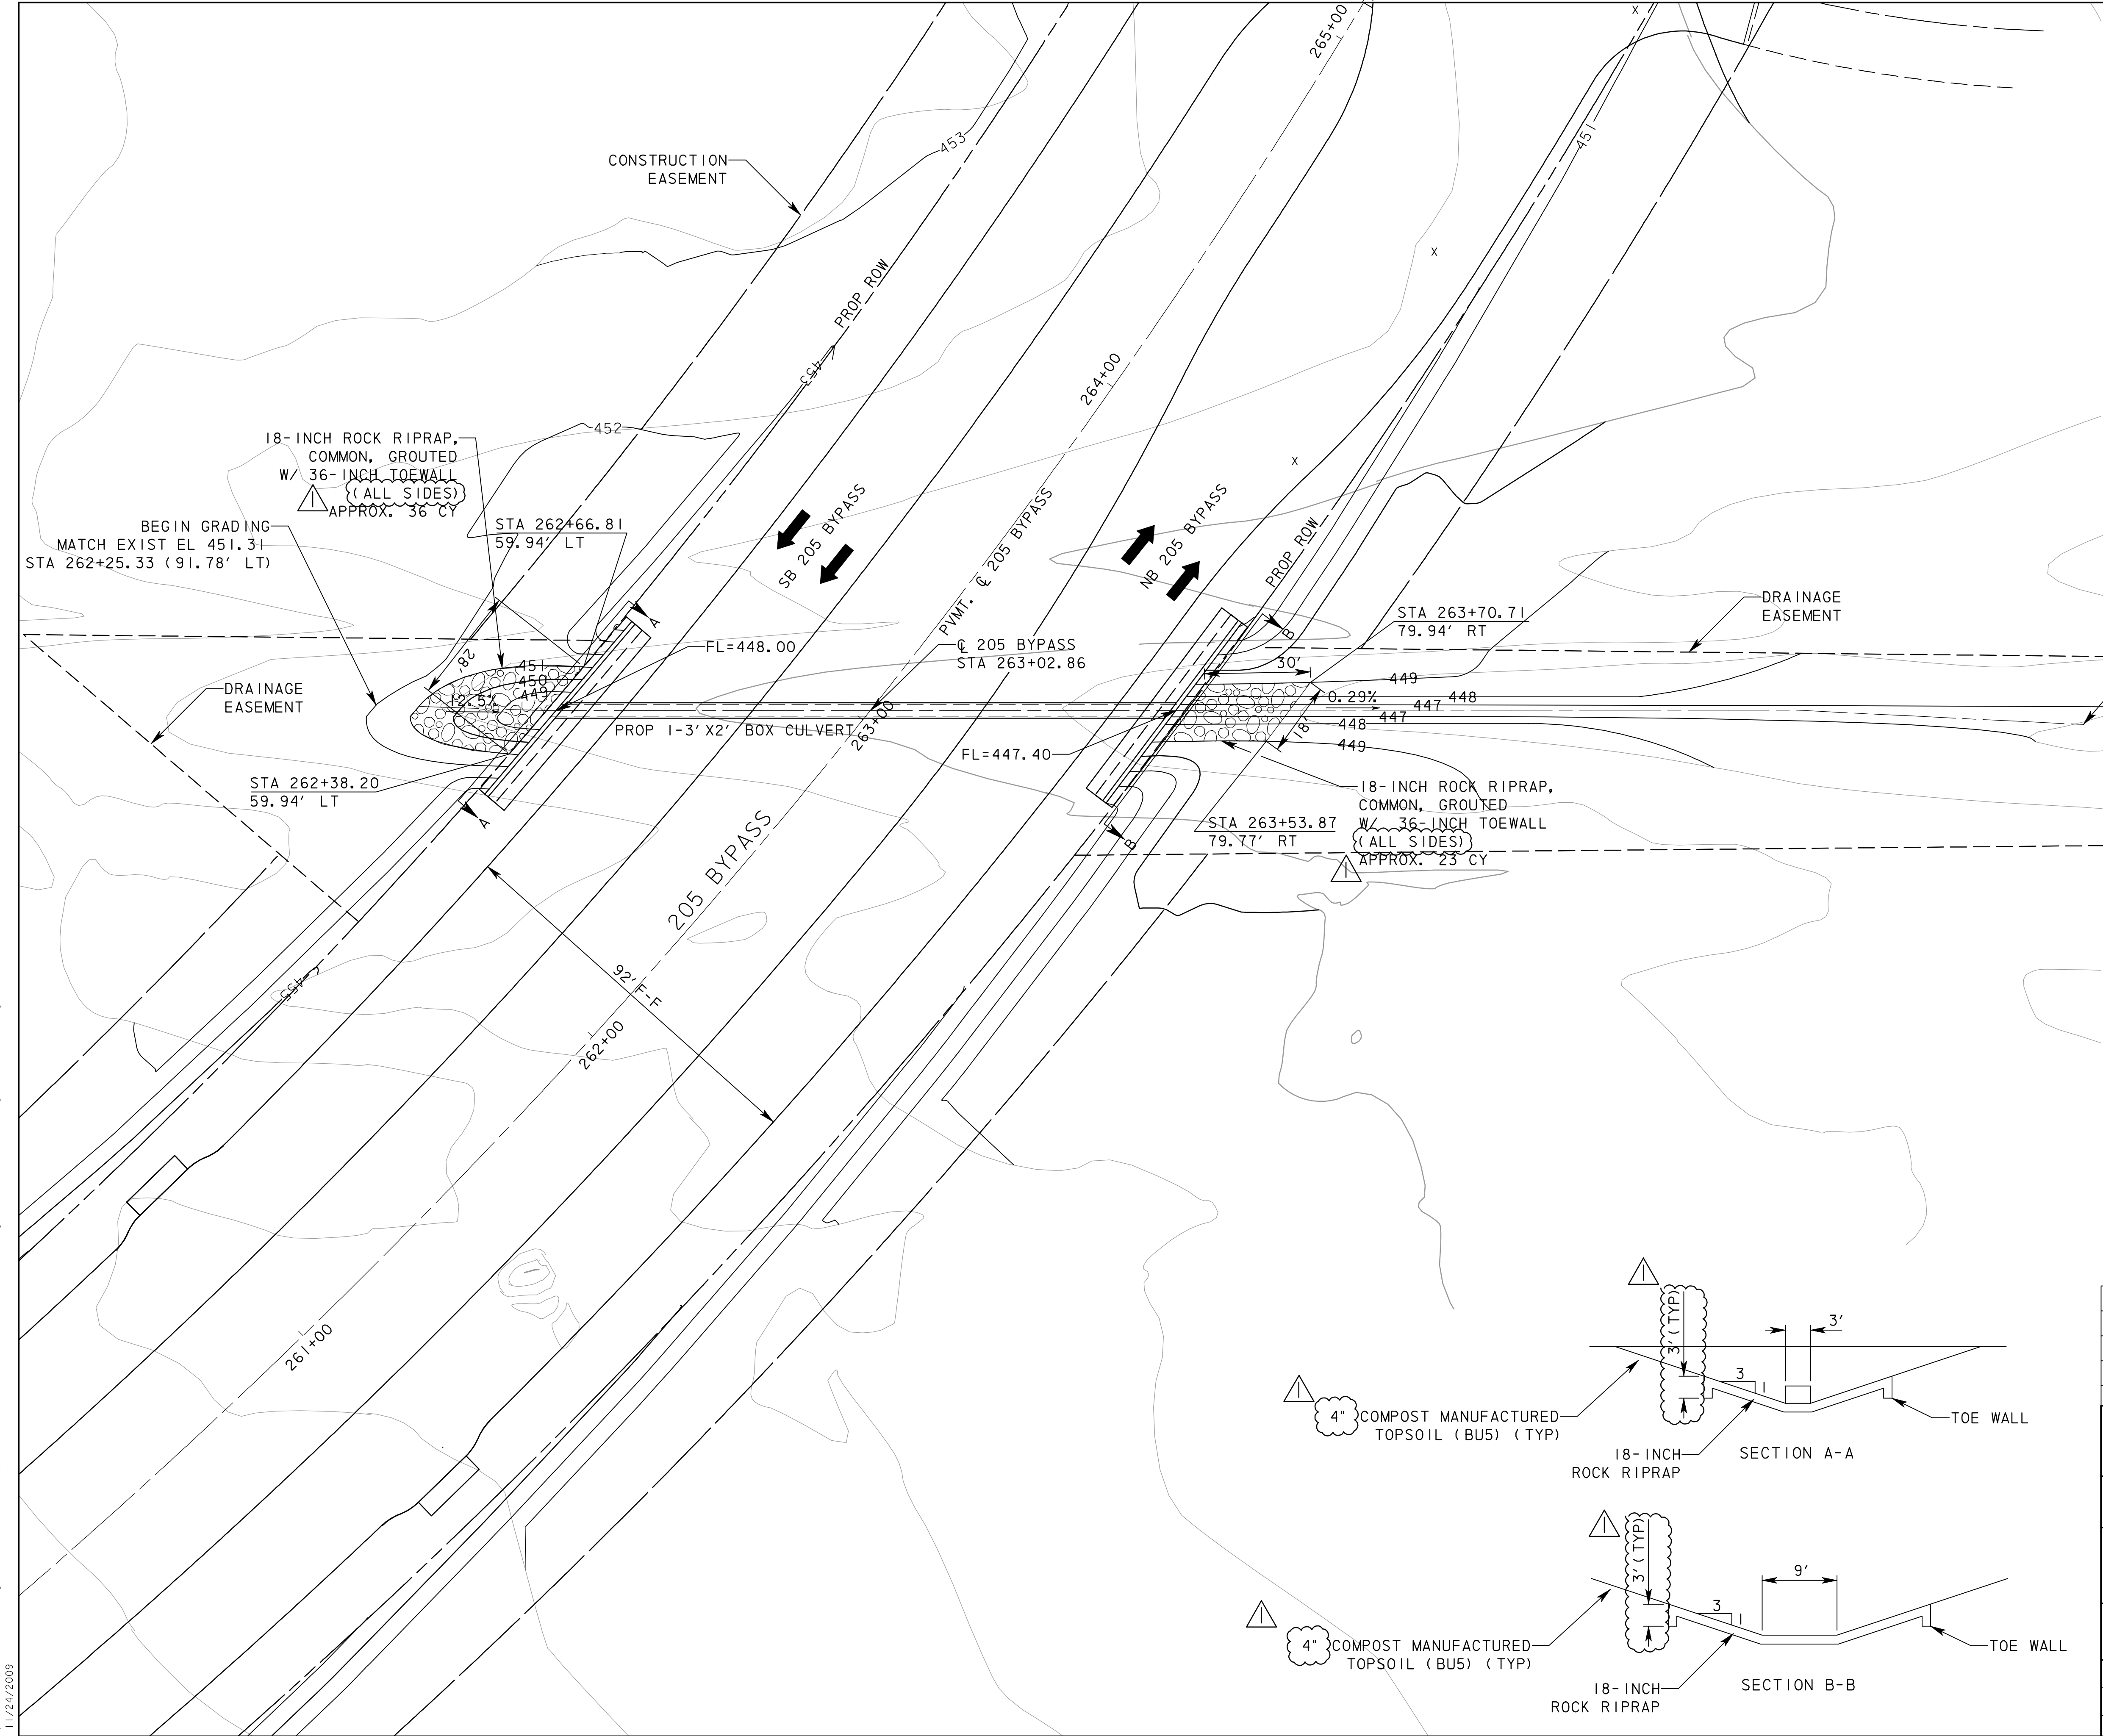

RECORD DRAWING
 This drawing is a compilation of the original sealed engineering drawing and modifications by addenda, change orders and information furnished by the contractor. Information shown that was provided by the contractor and others not associated with the design engineer cannot be verified for accuracy or completeness. Original sealed drawing is on file at the office of AECOM USA Group, Inc., TBPE REG. NO. F-3082

ORIGINAL DRAWING SEALED & SIGNED BY
 T.H. Gaertner, P.E.
 TX NO. 37124

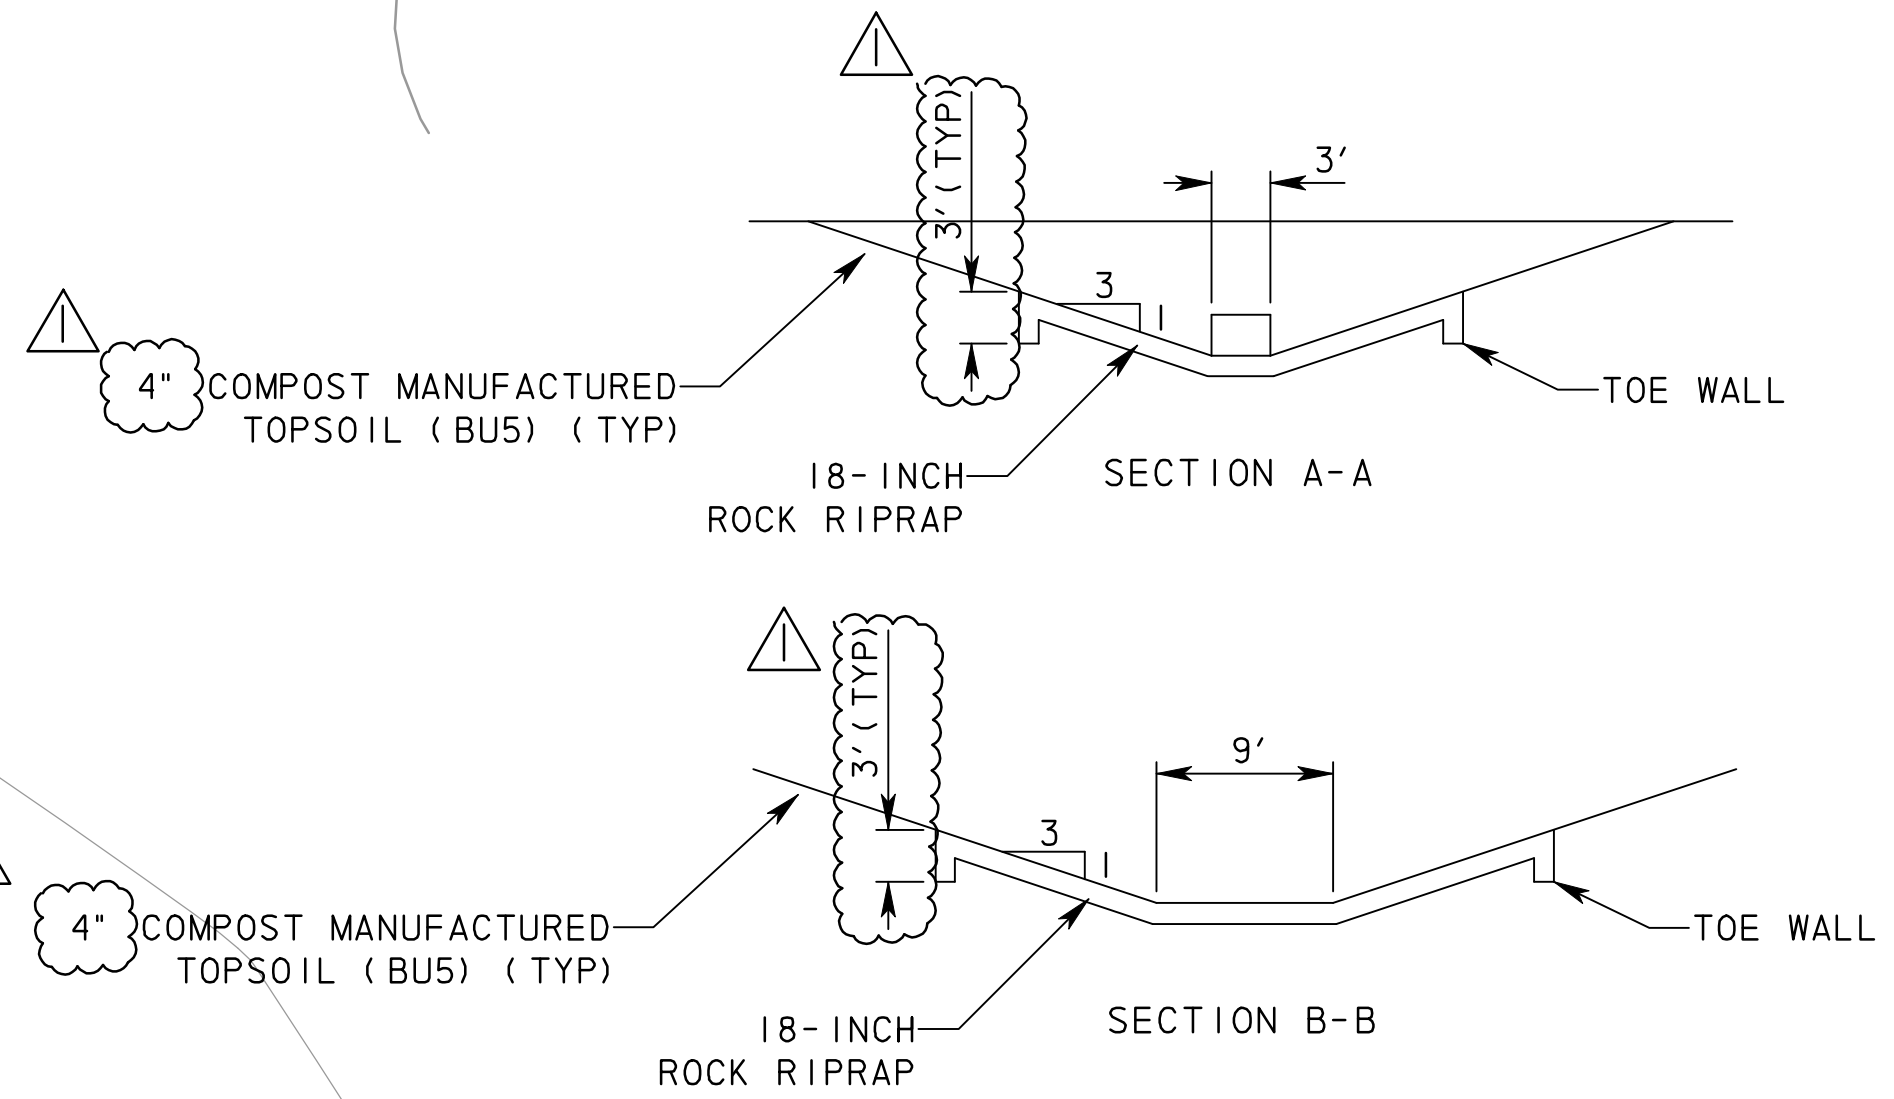

I MISC. REVISIONS		THG	10/22/07
NO.	REVISION	BY	DATE
205 BYPASS PHASE 6			
GRADING PLAN AT STA 263+02.86			
2 OF 2			
		TCB INC. WWW.TCB.AECOM.COM 17300 DALLAS PARKWAY, SUITE 1010 DALLAS, TEXAS 75248	
Unit	PW-DAL-FW	Scale	Horz: AS SHOWN Vert: AS SHOWN
Designed	Checked	TCB	Date
Drawn	FG	Approved	TCB
Project No. 60004153		Date 11/24/2009	
Sheet 87 of 216			

P:\328\60004153-205bypass\cadd\sheet6\phase 6 - fm52 to 205\record drawing 10_7_09\087\grading-Sta 263-00.dgn
 11/24/2009