


- NOTES:
1. CONTRACTOR TO REMOVE EXIST. HEADWALL & CONCRETE OFF EXISTING CULVERT, EXPOSING REBAR. CONNECT PROP CULVERT TO EXISTING CULVERT, TYING REBAR TOGETHER.
 2. NO FLOW INFORMATION AVAILABLE FOR CULVERT.
 3. BLOCK SOD ALL GRADED SLOPES STEEPER THAN 4:1 AND ALL AREAS IN BOTTOM OF STREAM CHANNEL. INSTALL CELLULOSE FIBER MULCH SEEDING IN ALL OTHER DISTURBED AREAS PER TXDOT SPEC ITEM 164.

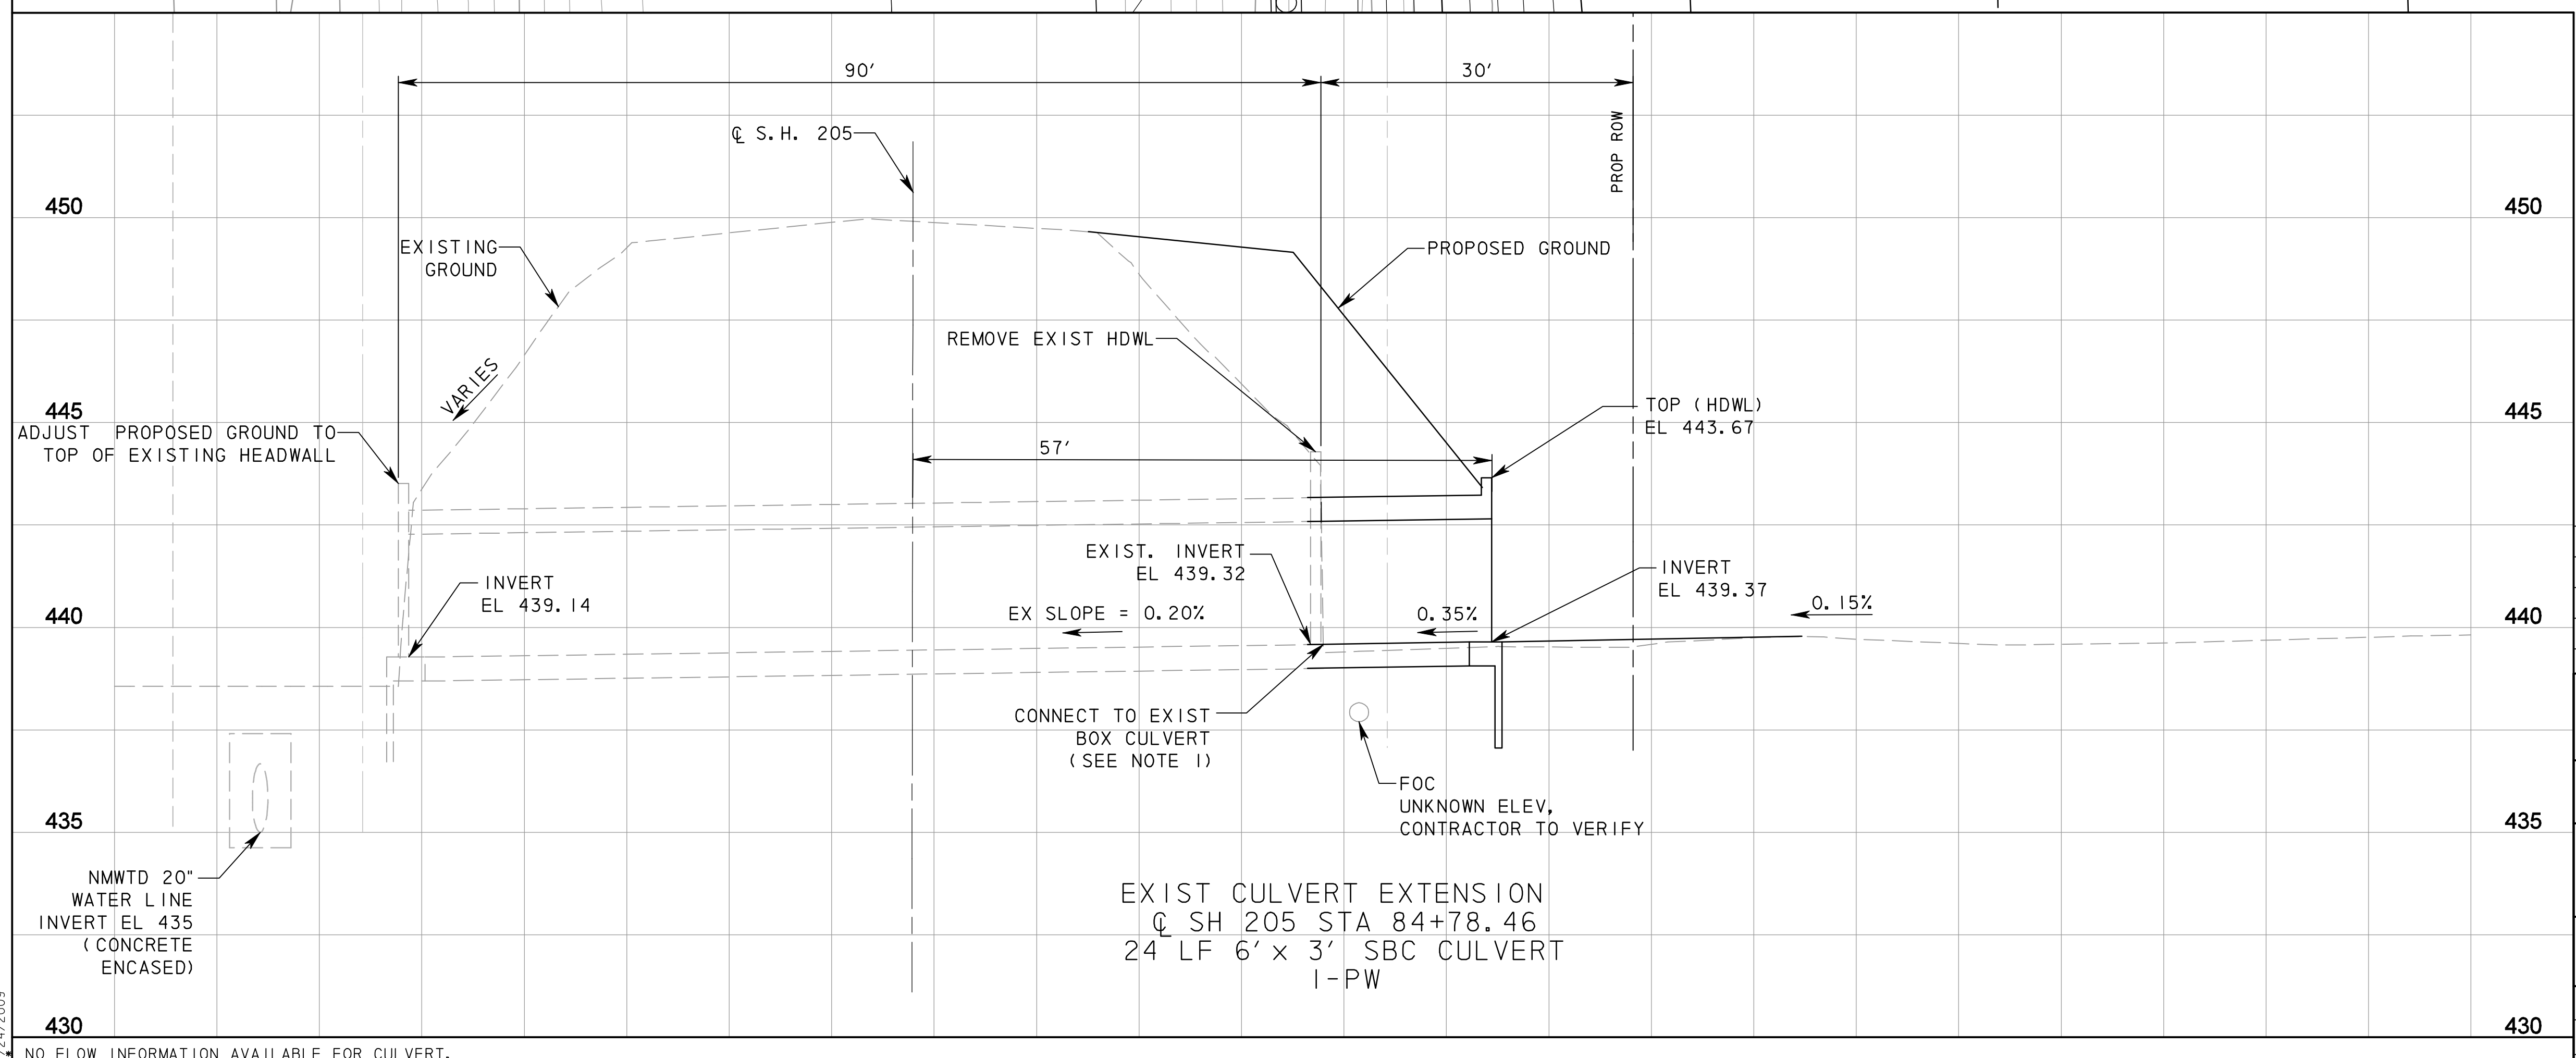

RECORD DRAWING

This drawing is a compilation of the original sealed engineering drawing and modifications by addenda, change orders and information furnished by the contractor. Information shown that was provided by the contractor and others not associated with the design engineer cannot be verified for accuracy or completeness. Original sealed drawing is on file at the office of ACCOM USA Group, Inc., TBPE REG. NO. F-3082

ORIGINAL DRAWING SEALED & SIGNED BY
T.H. Gaertner, P.E.
TX NO. 37124

CULVERT LENGTH		THC	07/02/08
NO.	REVISION	BY	DATE
City of Rockwall, Texas			
205 BYPASS PHASE 6			
CULVERT PLAN & PROFILE AT STA 84+78.46			
TCB AECOM		<small>TCB INC. WWW.TCB.AECOM.COM 17300 DALLAS PARKWAY, SUITE 1010 DALLAS, TEXAS 75248</small>	
Unit	PW-DAL-FW	Scales	Horz: AS SHOWN Vert: AS SHOWN
Designed	RI/US	Checked	TCB
Drawn	FG	Approved	TCB
Date	11/24/2009		Project No. 60004153
Sheet 90A		of 216	

p:\328\60004153-205bypass\cadd\sheet6\phase 6 - fm52 to 205\record drawing 10_7_09\090\Culvert- Sta 84+78.dgn
 11/24/2009